





CLINTON REGIONAL PARK WAS RENAMED COSCA REGIONAL PARK

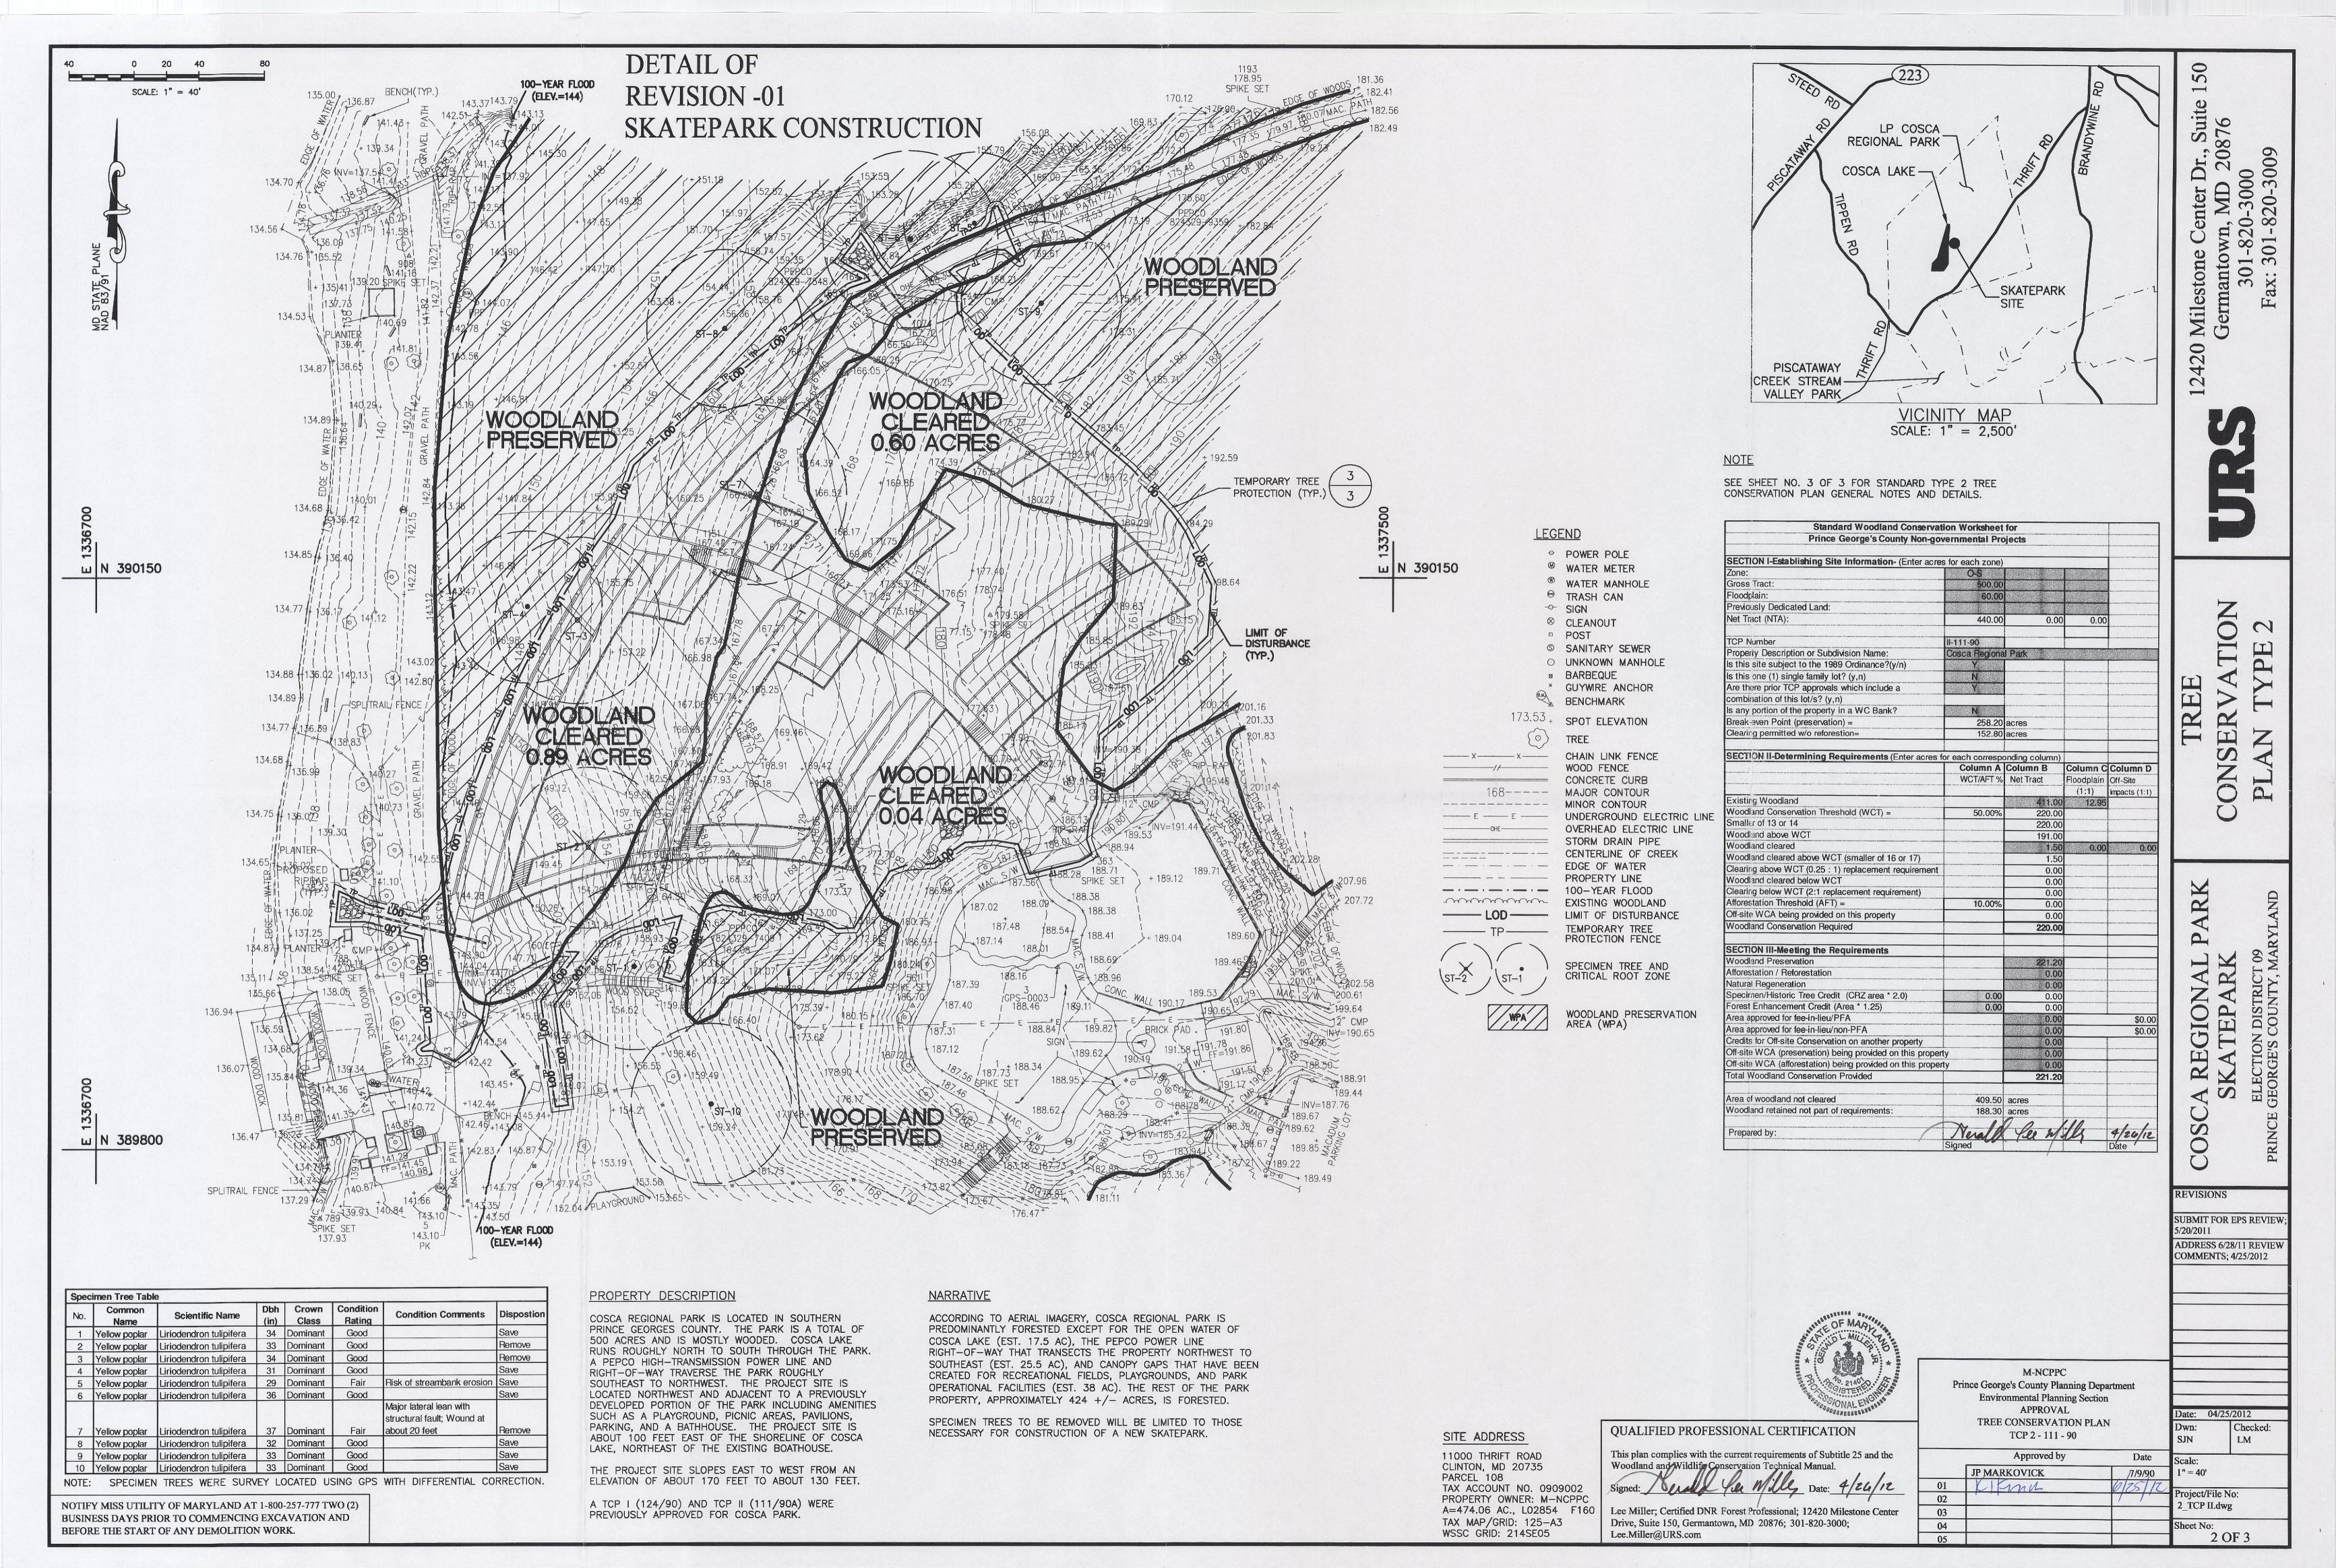

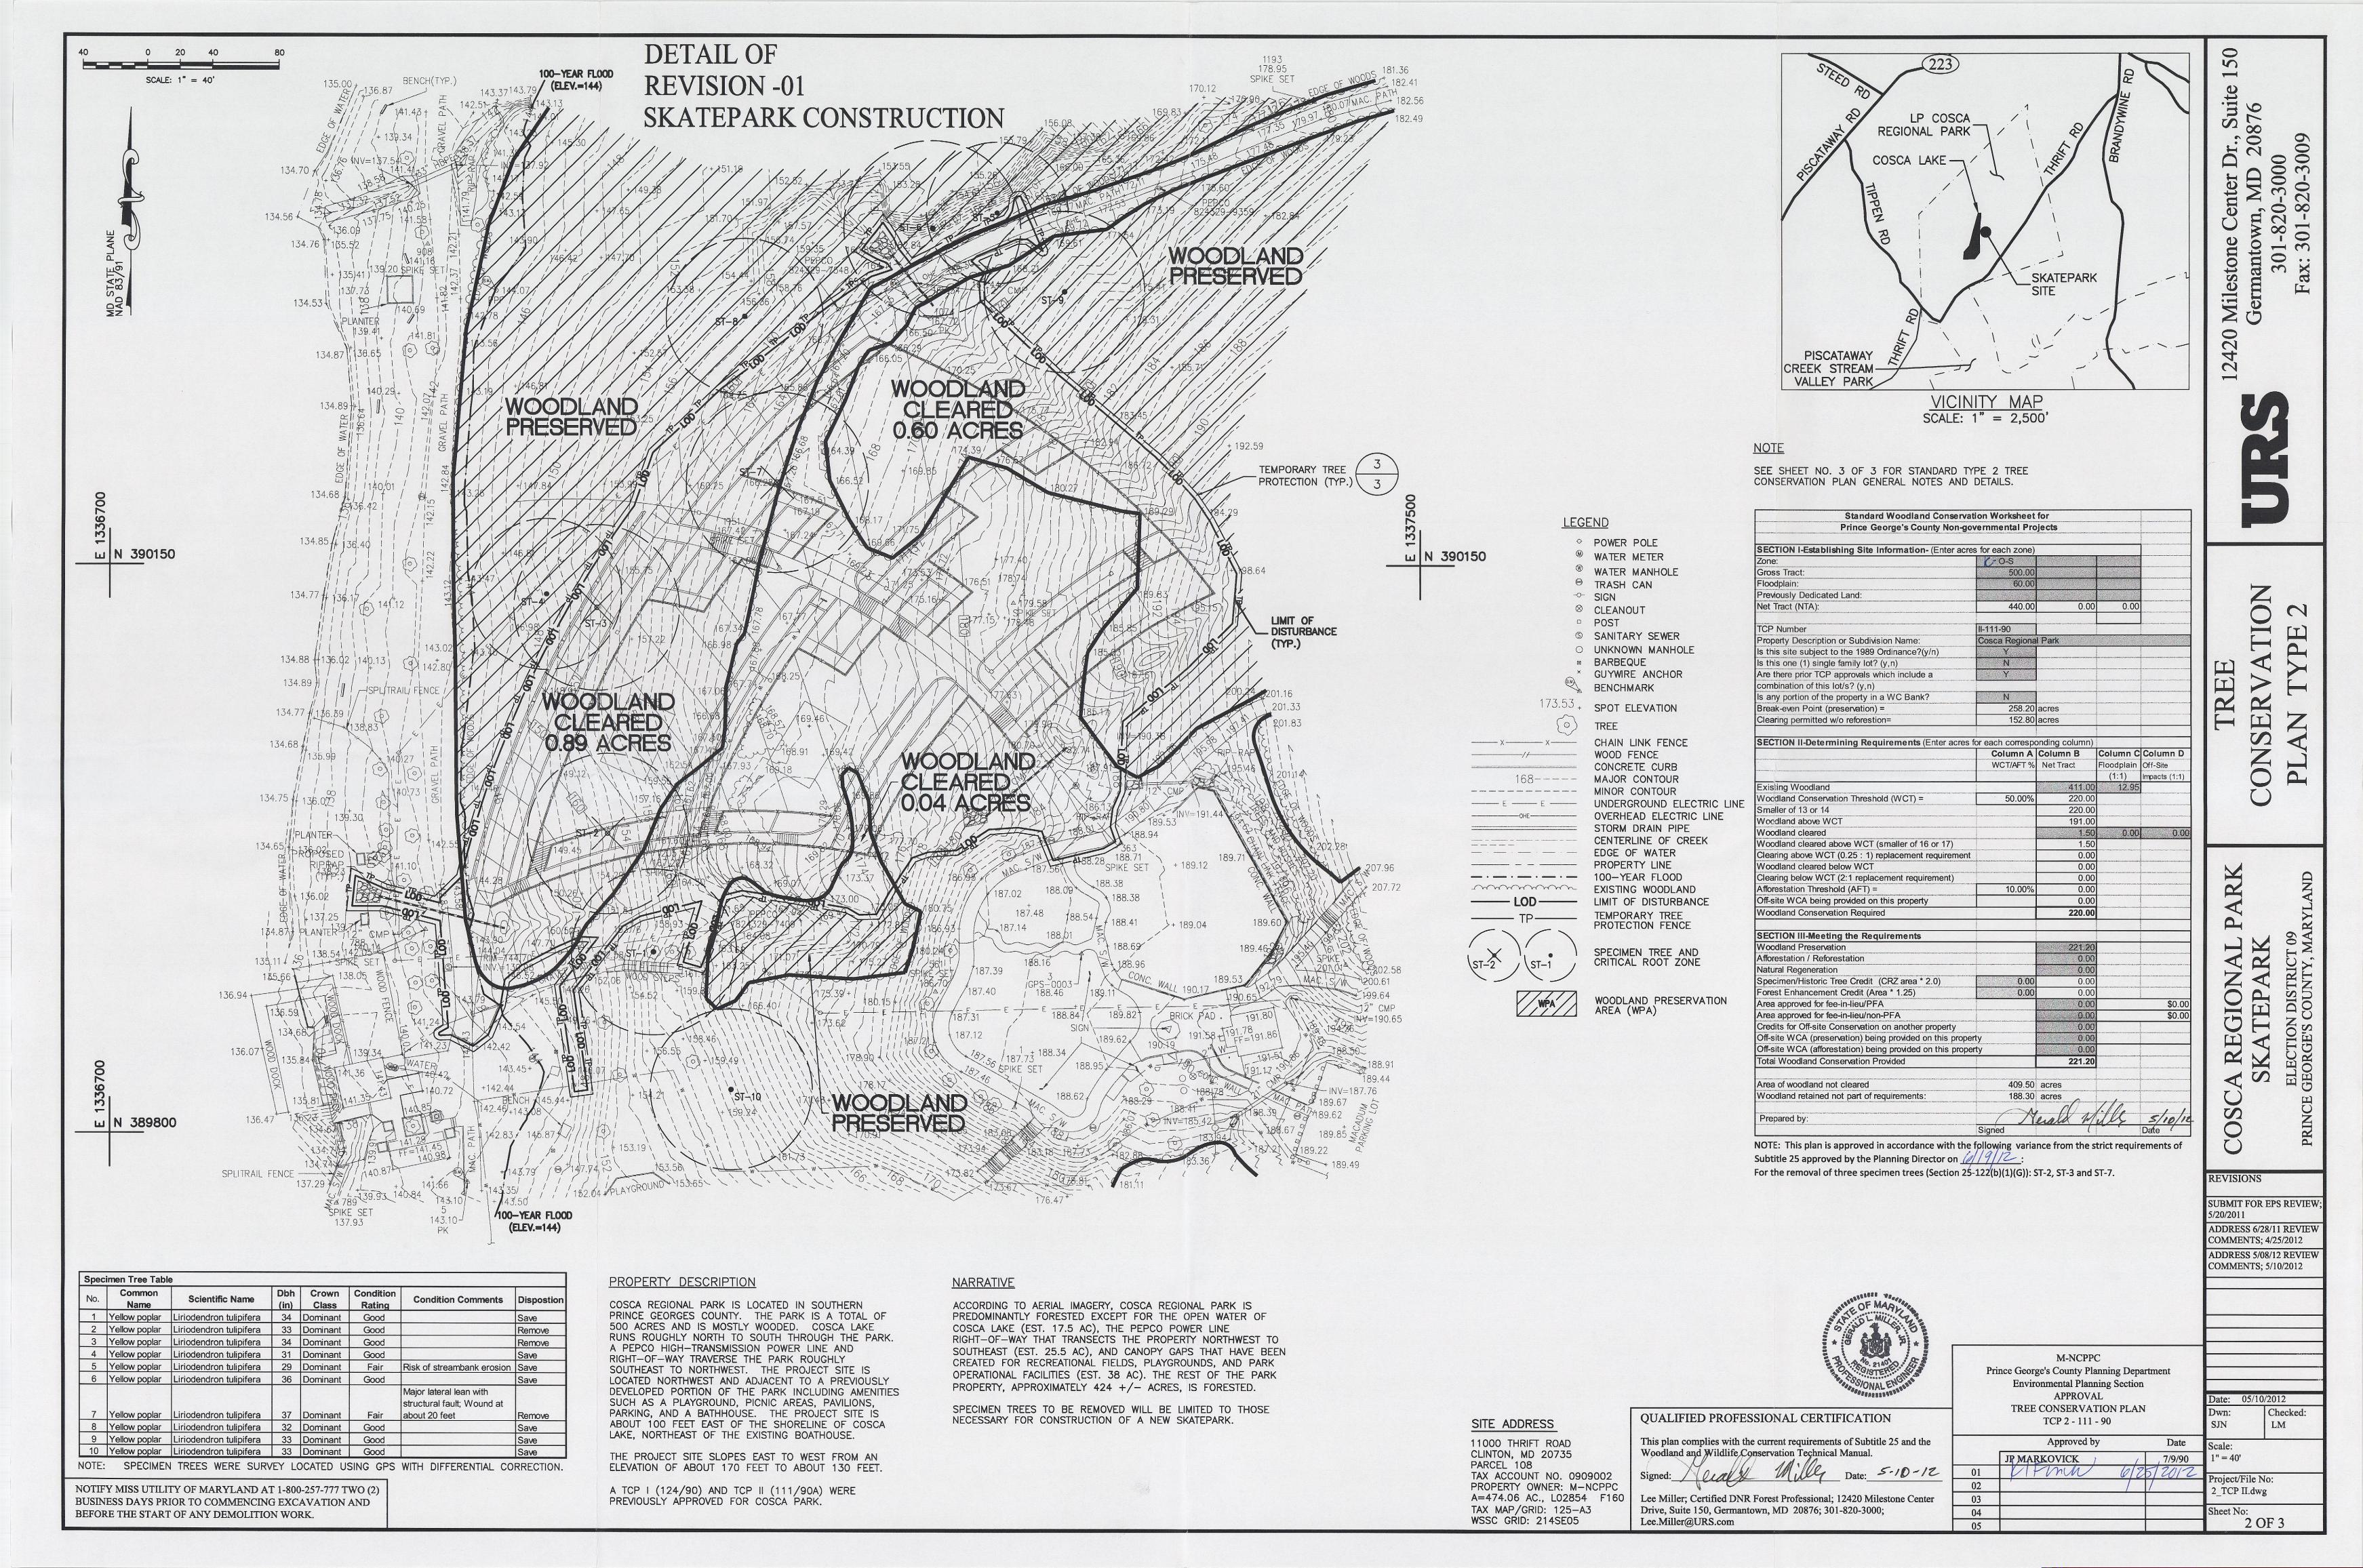

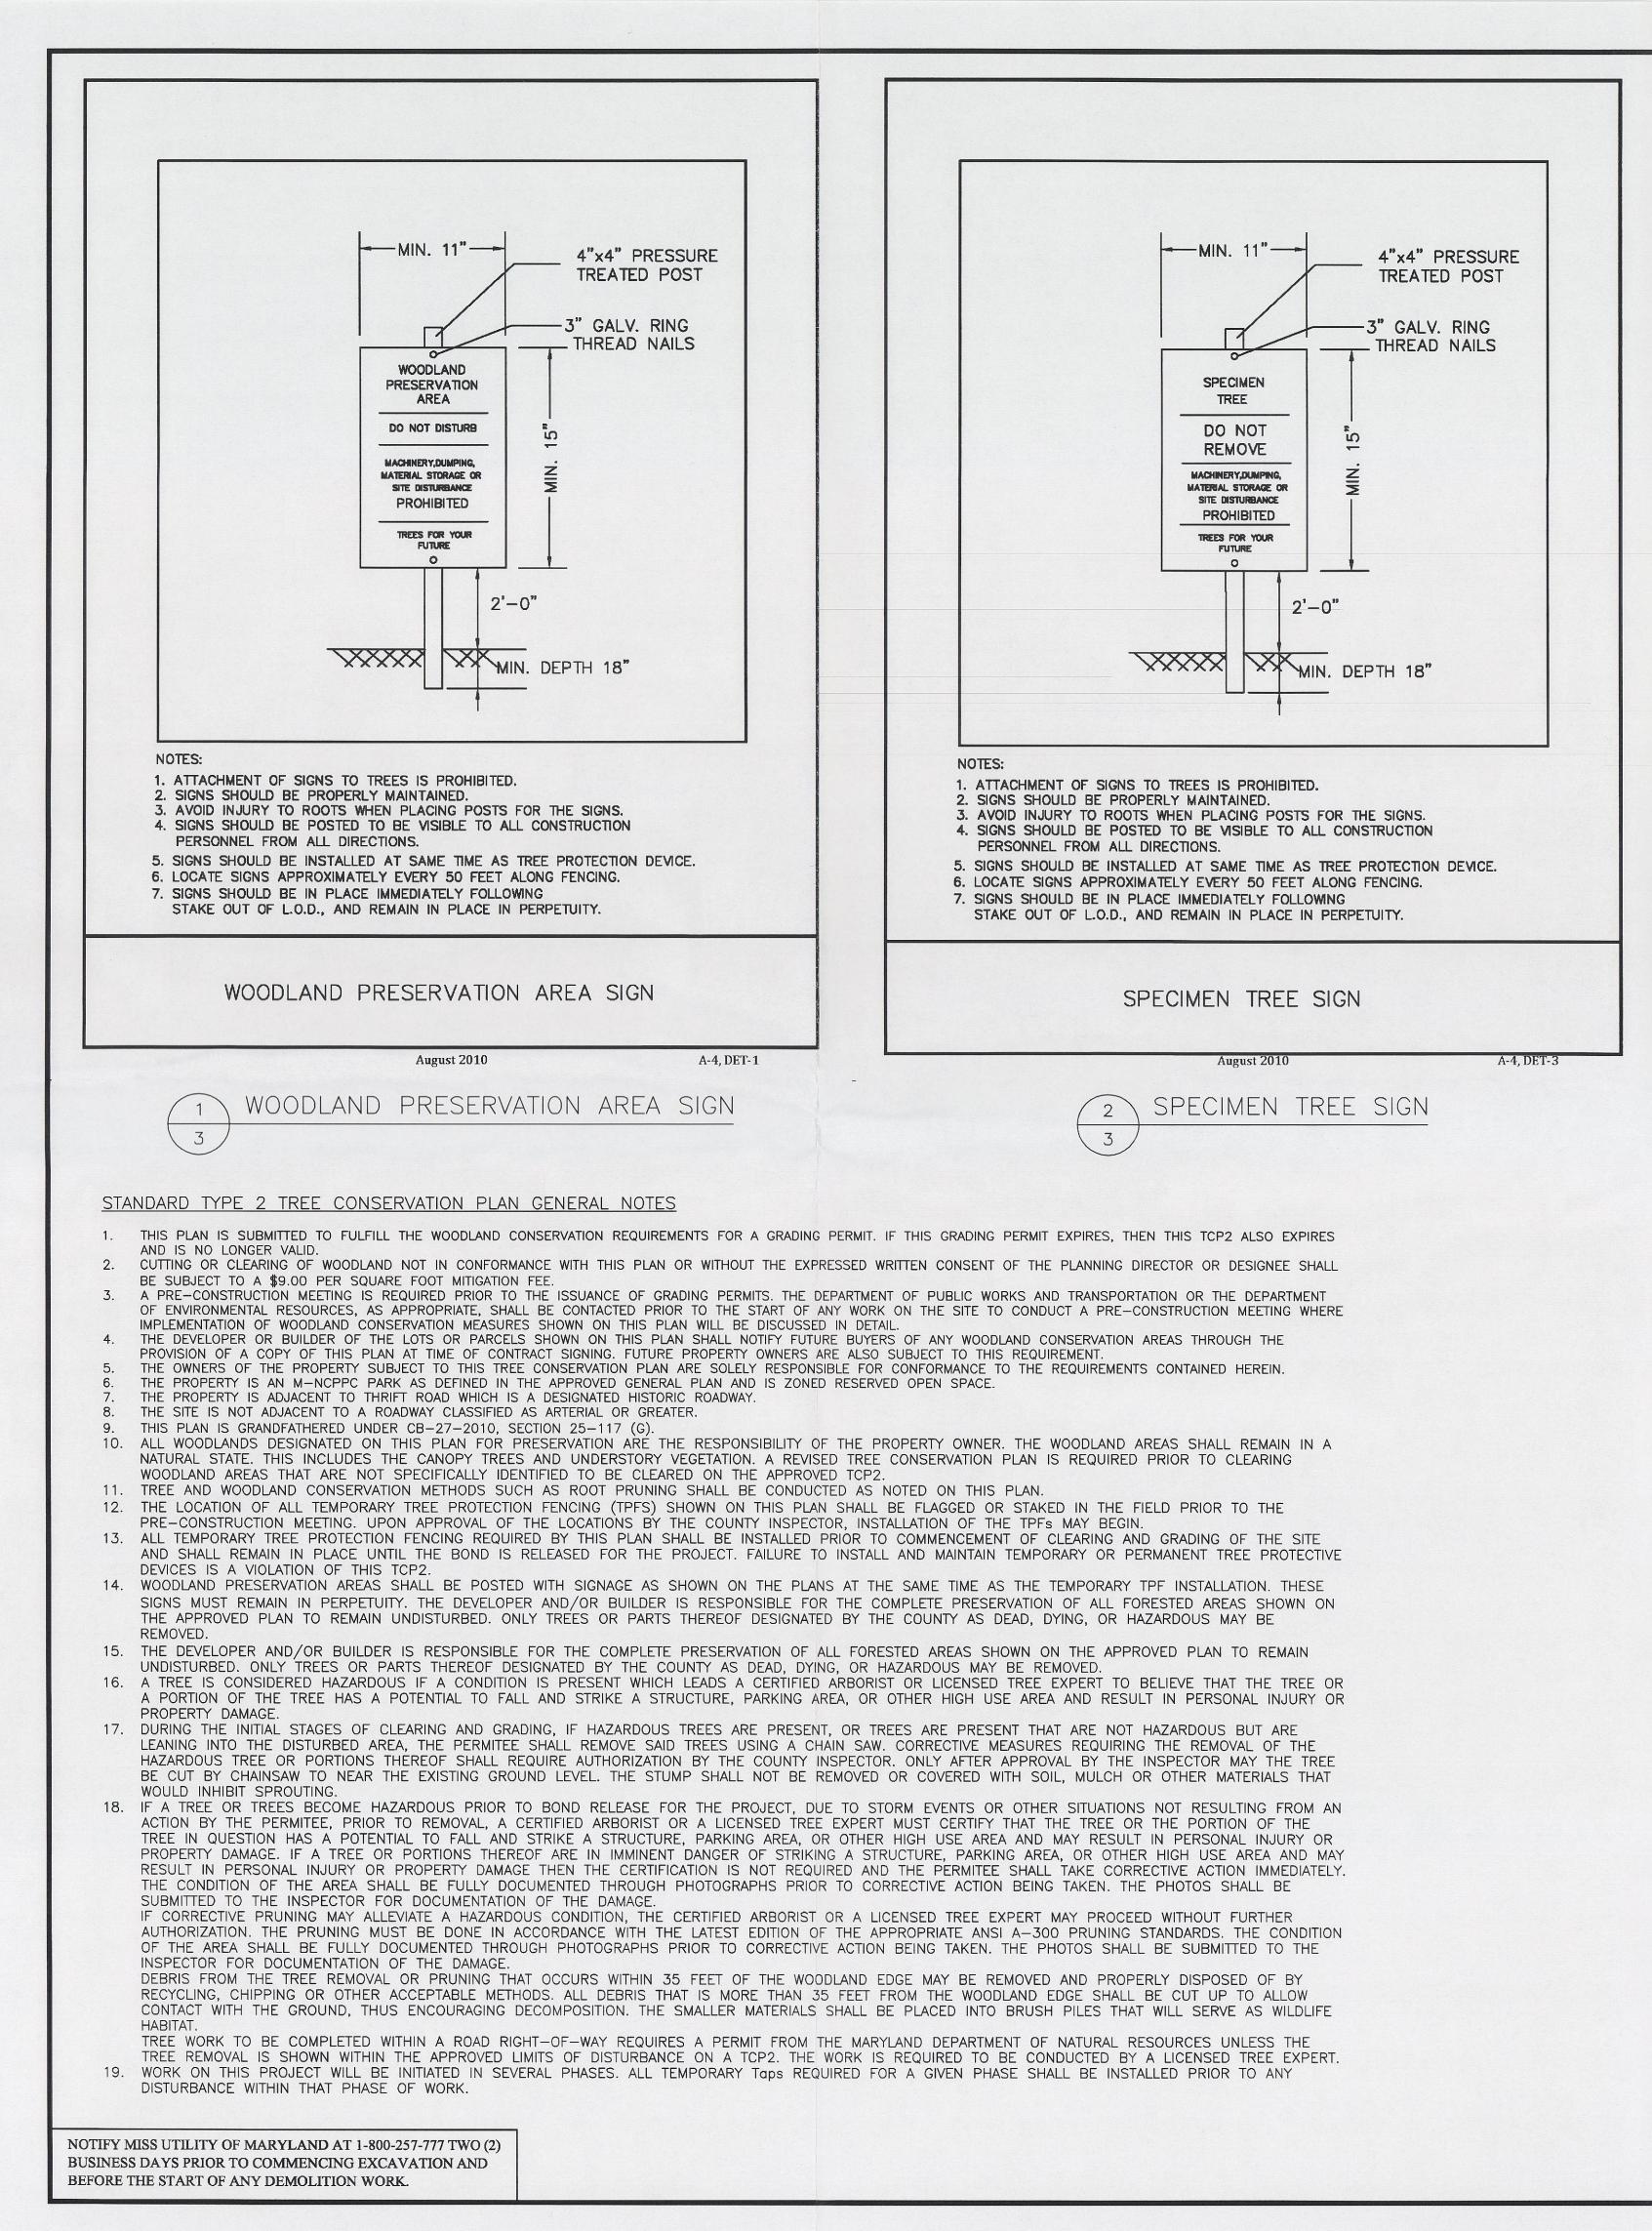

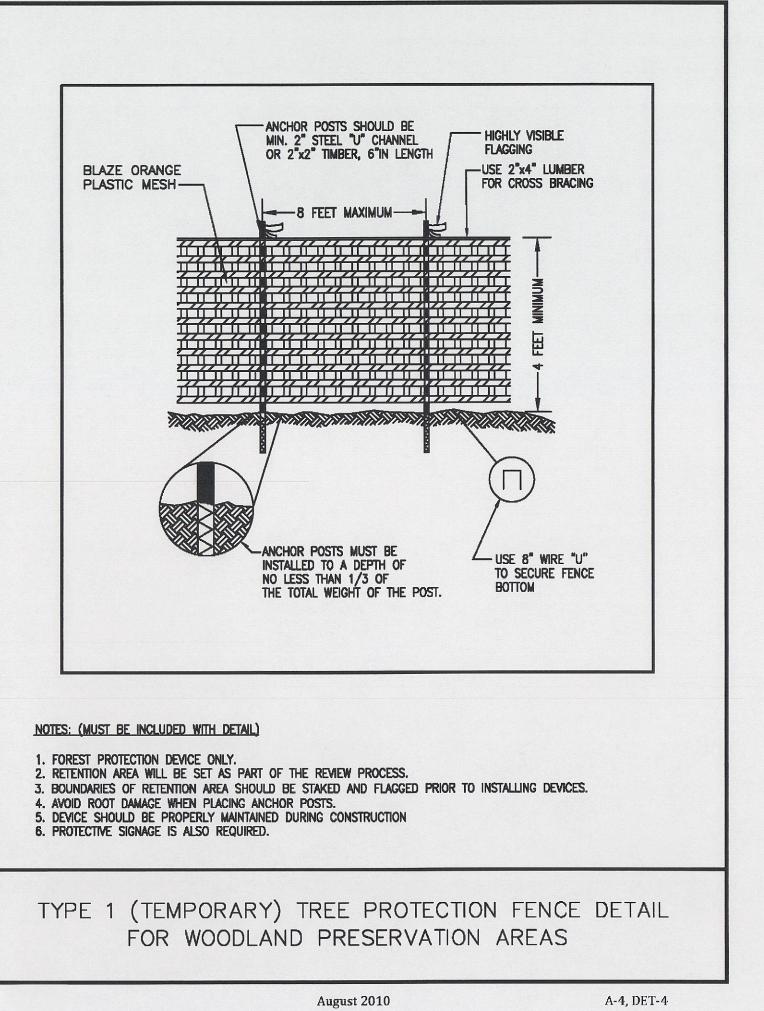

3 TEMPORARY TREE PROTECTION FENCE

COSCA REGIONAL PAJ
SKATEPARK

SUBMIT FOR EPS REVIEW

ADDRESS 6/28/11 REVIEW

3 OF 3

COMMENTS; 4/25/2012

5/20/2011

S

Milestone

N

TR

SER

MD 2087 3000

> iermantow 301-8 Fax: 301

Prince George's County Planning Department Environmental Planning Section APPROVAL Date: 04/25/2012 TREE CONSERVATION PLAN Checked: TCP 2 - 111 - 90 Approved by Date NOT TO SCALE 7/9/90 JP MARKOVICK 01 / Ama roject/File No: 02 3 TCP II.dwg 03 Sheet No: 04

05