


TREE CONSERVATION PLAN - TYPE II

STEEPLECHASE BUSINESS PARK

KENT (13TH) ELECTION DISTRICT
PRINCE GEORGE'S COUNTY, MARYLAND

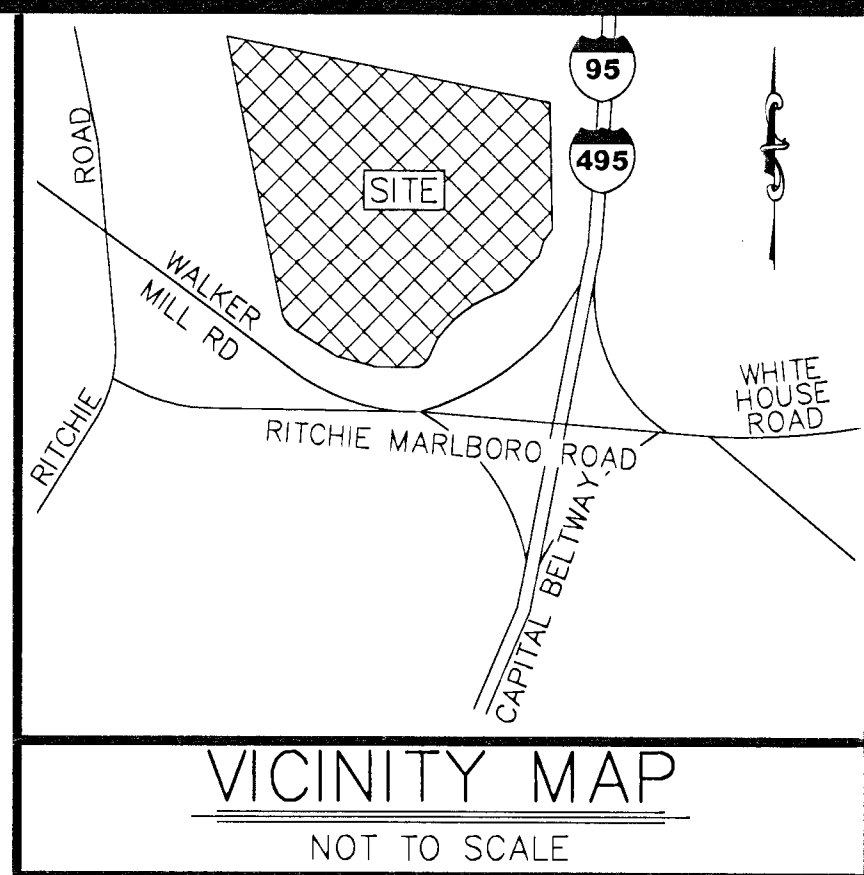

Woodland Conservation Worksheet for Prince George's County			
Zone:	I-1		
Gross Tract:	110.28		
Floodplain:	10.47		
Previously Dedicated Land:	0.00		
Net Tract (NTA):	99.81	0.00	0.00
*Include acreage in the corresponding column for each zone			
Property Description or Subdivision Name: Is this site subject to the 1989 Ordinance? Reforestation Requirement Reduction Questions Is this one (1) single family lot? (y,n) Are there prior TCP approvals which include a combination of this lot and/or other lots. (y,n) Is this a Mitigation Bank Break-even Point (preservation) = Clearing permitted w/o reforestation =			
Woodland Conservation Calculations:		Net Tract (acres)	Off-site (acres)
Existing Woodland		11.84	7.86
Woodland Conservation Threshold (NTA) =	15.00%	14.97	
Smaller of a or b		11.84	
Woodland above WCT		0.00	
Woodland cleared		9.87	1.18
Smaller of d or e		0.00	
Clearing above WCT (0.25 : 1) replacement requirement		0.00	
Clearing below WCT (0.1 replacement requirement)		9.87	
Afforestation Threshold (AFT) =	15.00%	3.13	
Off-site Mitigation being provided on this property		0.00	
Woodland Conservation Required		26.00	
Woodland Conservation Provided:		(acres)	
Woodland Preservation		1.87	
Afforestation / Reforestation		6.73	
Area approved for fee-in-lieu		0.70	\$9,147.80
Credits for Off-site Mitigation on another property		16.70	
Off-site Mitigation (preservation) being provided on this property		0.00	
Off-site Mitigation (afforestation) being provided on this property		0.00	
Total Woodland Conservation Provided		26.00	
Area of woodland not cleared		1.97 acres	
Woodland retained not part of requirements:		0.10 acres	
Prepared by:		Signed	Date
Revised 7.1.06			

PMA DISTURBANCE COMPARISON OF TCP I VS. TCP II			
AREA	TCPI	TCPII	SHI
1	29461 SF	27990 SF	11
2	395 SF	000 SF	10
3	477 SF	000 SF	10
4	517 SF	000 SF	10
5	492 SF	1678 SF	12
6	10758 SF	000 SF	6
7	353 SF	233 SF	5
8	3815 SF	3537 SF	6
9	584 SF	242 SF	6
10	470 SF	4180 SF	4
11	541 SF	2814 SF	4
12	20840 SF	30565 SF	11
13	366 SF	000 SF	2
14	345 SF	2696 SF	11
15	3588 SF	6940 SF	8
16	0 SF	1550 SF	8
AREA	80202 SF	82425 SF	

TREE PRESERVATION AREAS	
NO.	AREA
1	0.09 Ac.
2	0.15 Ac.
3	0.03 Ac.
4	0.22 Ac.
5	0.17 Ac.
6	0.82 Ac.
7	0.39 Ac.
TOTAL	1.87 Ac.

TREE REFORESTATION AREAS	
DESIG.	AREA
A	2.27 Ac.
B	0.78 Ac.
C	0.17 Ac.
D	0.04 Ac.
E	0.09 Ac.
F	0.00 Ac. *
G	0.63 Ac.
H	0.49 Ac.
I	0.40 Ac.
J	1.86 Ac.
TOTAL	6.73 Ac.


* REFORESTATION AREA F HAS BEEN DELETED.

GLWGUTSCHICK LITTLE & WEBER, P.A.

CIVIL ENGINEERS, LAND SURVEYORS, LAND PLANNERS, LANDSCAPE ARCHITECTS
3909 NATIONAL DRIVE - SUITE 200 - BURTSMVILLE OFFICE PARK
BURTSMVILLE, MARYLAND 20866
TEL: 301-421-4024 FAX: 410-880-1820 301-989-2224 FAX: 301-421-4186

OWNER/DEVELOPER


ATAPCO PROPERTIES, INC.
10 EAST BALTIMORE AVE
SUITE 1501
BALTIMORE, MD 21202
CONTACT: KRISTINA MACEK
410-347-7183

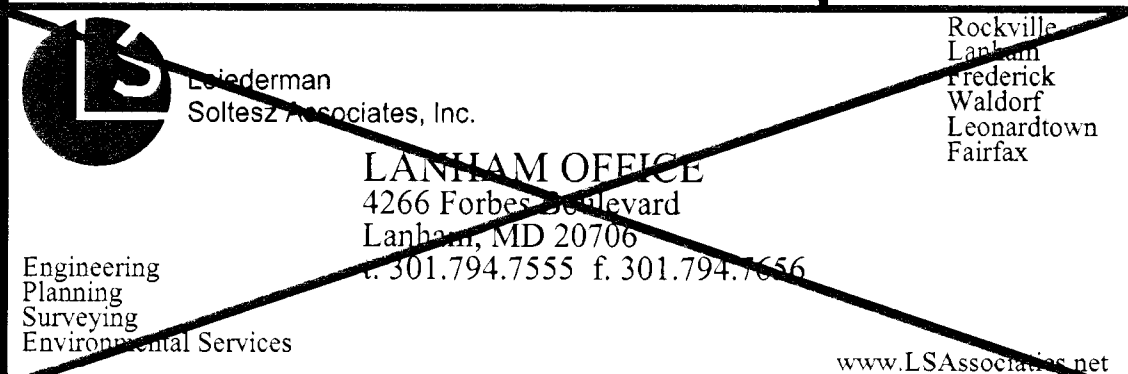

LANHAM OFFICE
4266 Forbes Boulevard
Lanham, MD 20706
P: 301.794.7355 F: 301.794.7656

www.LSAssociates.com

12	REV. PAR. 57 PER DSP, REV. PAR. 65 PER DSP, UPDATED PARCEL NUMBERS & REV. FLOODPLAIN DELINEATION ON PARCEL 57	KAB	1/16/17
11	REVISED BUILDING D	RLG	7/18/14
10	REVISED TREE CONSERVATION EASEMENT	RLG	2/19/14
9	REVISED TREE CONSERVATION EASEMENT	RLG	12/17/13
8	REVISION FOR TIRE PLUS SEWER OUTFALL	CJV	10/20/11
7	REVISION FOR NFOU BLDG.	YOR	2/10/09
6	REVISED PER BUILDING A-4 SITE PLAN, REFORESTATION AREAS B,C,H & J CHANGED.	YOR	4/01/08
5	REVISED TO MATCH PROPOSED FLOODPLAIN, REVISED SWM POND S, AND CUL-DE-SAC & PARKING LOT AT PARCEL 19	CWJ	10/13/05
4	CHANGES DUE TO CLIENT REVISIONS	CWJ	5/25/05
3	ADDED OFFSITE CREDIT SITES	YOR	9/10/04
2	REV. PER FINAL IMPROVEMENT	YOR	8/4/04
1	REV. PER MNCPPC REVIEW COMMENTS DATED 5/10/04	BT	5/11/04
NO.	REVISION		
DATE:	JULY, 2013	CAD STANDARDS VERSION: AUTOCAD CIVIL 3D 2011	
DES:	MAJ	DRN: A.W.	[CHK: MAJ]

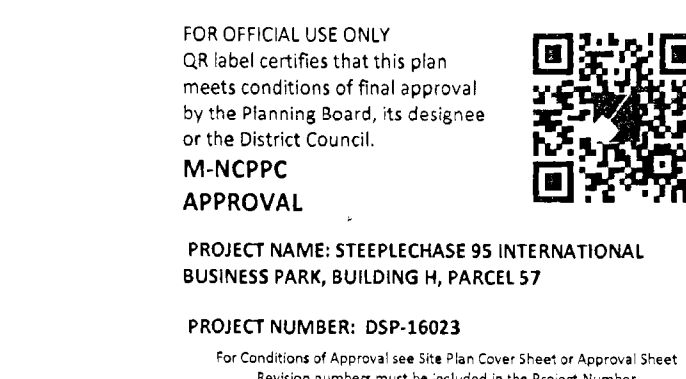

FLOODPLAIN NOTE:

THE 100 YEAR FLOODPLAIN SHOWN ON THIS PLAN IS TAKEN FROM FLOODPLAIN STUDY 990014 WHICH WAS APPROVED ON MARCH 11, 2005. UPDATED FPS APPROVAL APRIL 15, 2016.

COVER SHEET

TREE CONSERVATION PLAN


TYPE II

MISS UTILITY NOTE

INFORMATION CONCERNING EXISTING UNDERGROUND UTILITIES WAS OBTAINED FROM AVAILABLE RECORDS. THE CONTRACTOR MUST DETERMINE THE EXACT LOCATION AND ELEVATION OF ALL EXISTING UTILITIES AND UTILITY CROSSINGS BY DIGGING TEST PITS BY HAND, WELL IN ADVANCE OF THE START OF EXCAVATION. CONTACT MISS UTILITY AT 1-800-227-7777, 48 HOURS PRIOR TO THE START OF EXCAVATION. IF CLEARANCES ARE LESS THAN SHOWN ON THIS PLAN OR TWELVE (12) INCHES, WHICHEVER IS LESS, CONTACT THE ENGINEER AND THE UTILITY COMPANY BEFORE PROCEEDING WITH CONSTRUCTION. CLEARANCES LESS THAN NOTED MAY REQUIRE REVISIONS TO THIS PLAN.

DESCRIPTION	SHEET No.
COVER SHEET	1
TREE CONSERVATION PLAN - TYPE II	2
TREE CONSERVATION PLAN - TYPE II	3
TREE CONSERVATION PLAN - TYPE II	4
TREE CONSERVATION PLAN - TYPE II	5
TREE CONSERVATION PLAN - TYPE II	6
TREE CONSERVATION PLAN - TYPE II	7
TREE CONSERVATION PLAN - TYPE II	8
TREE CONSERVATION PLAN - TYPE II	9
TREE CONSERVATION PLAN - TYPE II	10
TREE CONSERVATION PLAN - TYPE II	11
TREE CONSERVATION PLAN - TYPE II	12
TREE CONSERVATION PLAN - TYPE II	13
DETAILS AND SPECIFICATIONS	14
TREE CONSERVATION PLAN - TYPE II	14-A

LEGEND	
	ULTIMATE LIMITS OF DISTURBANCE
	EXISTING TREE LINE
	PROPOSED TREE LINE
	PRIMARY MANAGEMENT AREA LINE (PMA)
	EXISTING STREAM
	STREAM BUFFER
	NON-TIDAL WETLANDS
	WETLANDS BUFFER
	15%-25% (K FACTOR GREATER THAN 0.35)
	25% SLOPES
	TREE PROTECTION DEVICE (UPHILL)
	SILT FENCE (DOWNHILL TREE PROTECTION DEVICE)
	POST RAIL FENCE
	EARTH DIKE (DOWNHILL TREE PROTECTION DEVICE)
	TREE PRESERVATION AREA SIGN
	SPECIMEN TREE
	EX. NON-SPECIMEN TREE
	TREE PRESERVATION AREAS
	TREE PRESERVATION AREAS NON-CREDIT
	REFORESTATION AREAS
	FLOODPLAIN CLEARING AREAS

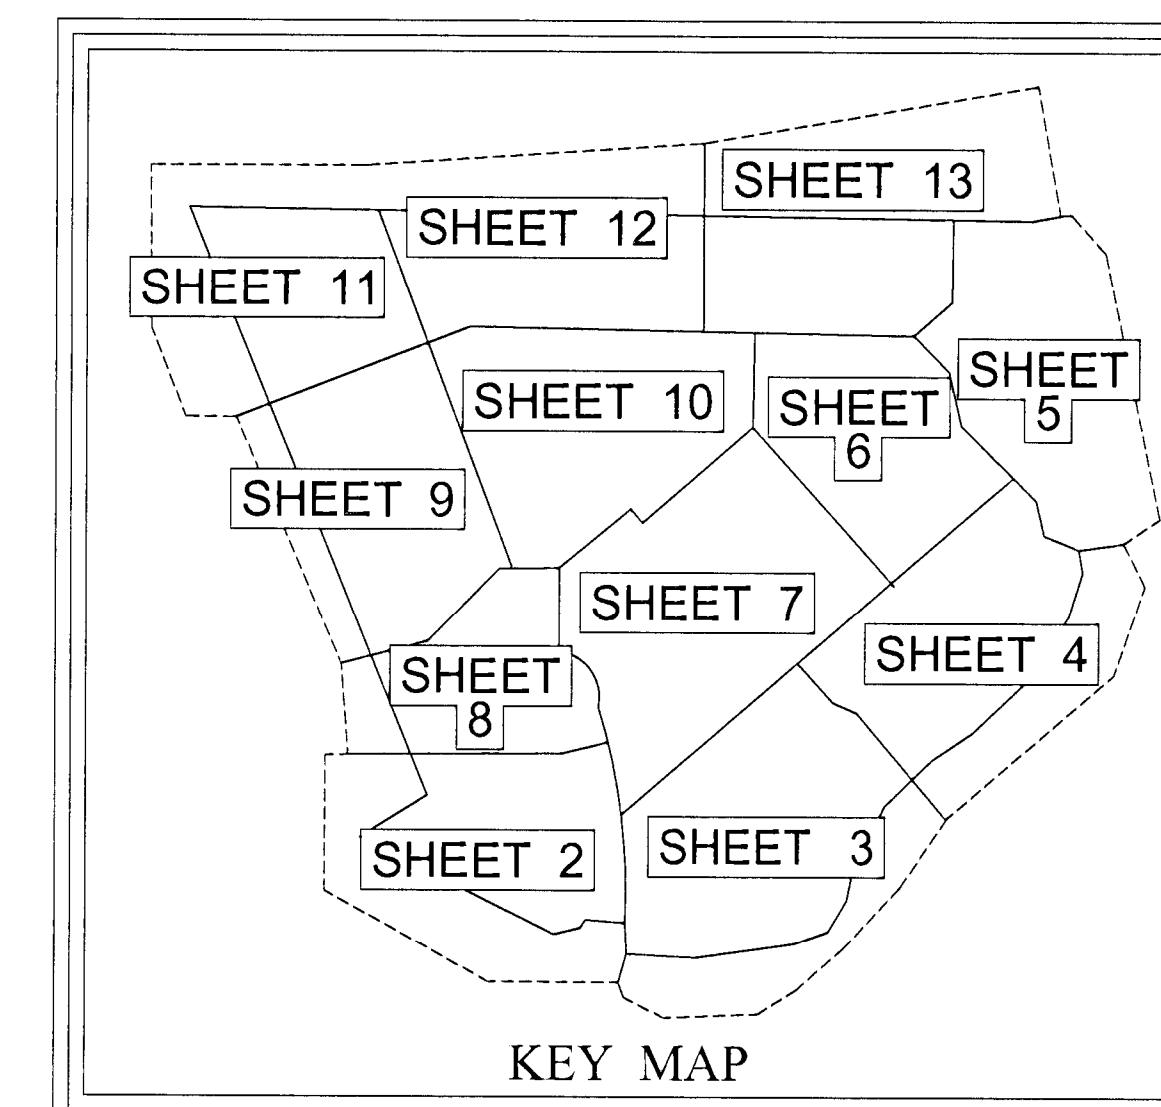


M-NCPPC APPROVALS			
PROJECT NAME: STEEPCCHASE BUSINESS PARK			
PROJECT NUMBER: DSDS-641			
FOR CONDITIONS OF APPROVAL SEE SITE PLAN COVER SHEET OR APPROVAL SHEET REVISED LISTED BELOW APPLY TO THIS SHEET			
APPROVAL OR REVISION #	APPROVAL DATE	REVIEWER'S INITIALS	CERTIFICATION DATE
	7-23-07	SA	11-14-07
M-NCPPC APPROVALS			
PROJECT NAME: STEEPCCHASE BUSINESS PARK			
PROJECT NUMBER: DSP-05044			
FOR CONDITIONS OF APPROVAL SEE SITE PLAN COVER SHEET OR APPROVAL SHEET REVISED LISTED BELOW APPLY TO THIS SHEET			
APPROVAL OR REVISION #	APPROVAL DATE	REVIEWER'S INITIALS	CERTIFICATION DATE
	7-11-08	KW	3-7-07
01	7-23-07	SA	11-14-07

M-NCPPC Prince George's County Planning Department Environmental Planning Section APPROVAL TREE CONSERVATION PLAN TCP II / 128 / 90			
REV. No.	APPROVED BY	DATE	ASSOCIATED CASE
	JIM STASZ	8/07/90	
01	ROBERT E. METZGER	5/20/04	
02	ROBERT E. METZGER	9/22/04	
03	ROBERT E. METZGER	11/10/06	DSP-05044 PGCPB No. 05-240
04	KATINA SHOULARS	6/2/08	DSP-05044/03 PLANNING DIRECTOR
05	KATINA SHOULARS	2/4/10	
06	KATINA SHOULARS	11/15/06	DSP-05044/05
07	KATINA SHOULARS	12/27/13	STAFF LEVEL
08	MEGAN K. REISER	6/30/14	STAFF LEVEL
09	MEGAN K. REISER	11/13/14	STAFF LEVEL
10	Megan K. Reiser	2/4/17	DSP-16023 PGCPB No. 16-139

PARCELS 1, 22, 24, 34-37, 39-41, 50, 53-61 & 63-66
PARCEL 'K', OUTLOT 'A' AND OUTPARCEL 'A'

STEEPLECHASE BUSINESS PARK

13TH / HENT ELECTION DISTRICT
PRINCE GEORGE'S COUNTY, MARYLAND

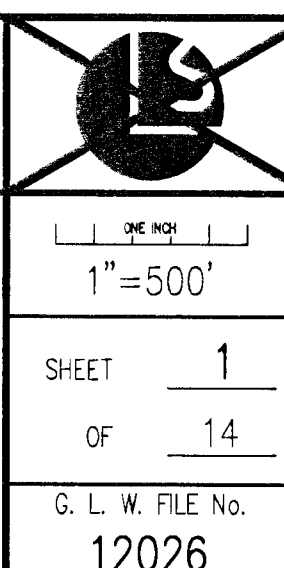

MATCHLINE SHEET 8

PARCEL 60

~~PARCEL K~~

**P/O REFORESTATION
AREA "A"
2.27 Ac. (TOTAL)**

PARCEL 58

PARCEL 24

WALKER
MILL
ROAD

Variable Width R.O.W.

Diagram illustrating a road construction project with a variable width right-of-way (R.O.W.). The road is shown with a centerline and a variable width R.O.W. indicated by a dashed line. The road is labeled "WALKER MILL ROAD". The diagram shows the road's alignment and the variable width R.O.W. along its length.

HAMPTON PARK BOULEVARD
VARIABLE WIDTH ROAD

MATCHLINE SHEET 3

LEGEND

-
- L00 ULTIMATE LIMITS OF DISTURBANCE
 EXISTING TREE LINE
 PROPOSED TREE LINE
 PMA PRIMARY MANAGEMENT AREA LINE (PMA)
 EXISTING STREAM
 S1B STREAM BUFFER
 NON-TIDAL WETLANDS
 W3 WETLANDS BUFFER
 15%-25% (K FACTOR GREATER THAN 0.35)
 25% SLOPES
 TPF TREE PROTECTION DEVICE (UPHILL)
 SF SILT FENCE (DOWNHILL TREE PROTECTION DEVICE)
 SSF SUPER SILT FENCE
 POST RAIL FENCE
 EARTH DIKE (DOWNHILL TREE PROTECTION DEVICE)
 TREE PRESERVATION AREA SIGN
 SPECIMEN TREE
 EX. NON-SPECIMEN TREE
 TREE PRESERVATION AREAS
 REFORESTATION AREAS
 FLOODPLAIN CLEARING AREAS

FOR OFFICIAL USE ONLY
QR label certifies that this plan meets conditions of final approval by the Planning Board, its designee or the District Council.

**M-NCPPC
APPROVAL**

**PROJECT NAME: STEEPLECHASE 95 INTERNATIONAL
BUSINESS PARK, BUILDING H, PARCEL 57**

PROJECT NUMBER: DSP-16023

For Conditions of Approval see Site Plan Cover Sheet or Approval

M-NDPCC APPROVALS				M-NDPCC APPROVALS			
PROJECT NAME: STEEPLECHASE BUSINESS PARK				PROJECT NAME: STEEPLECHASE BUSINESS PARK			
PROJECT NUMBER: DSP-00044				PROJECT NUMBER: DSSB-841			
(FOR CONDITIONS OF APPROVAL, SEE SITE PLAN COVER SHEET OR APPROVAL SHEET REJECTED BELOW APPLY TO THIS SHEET)				(FOR CONDITIONS OF APPROVAL, SEE SITE PLAN COVER SHEET OR APPROVAL SHEET REJECTED BELOW APPLY TO THIS SHEET)			
APPROVAL OR REVISION #	APPROVAL DATE	REVIEWER'S INITIALS	CERTIFICATION DATE	APPROVAL OR REVISION #	APPROVAL DATE	REVIEWER'S INITIALS	CERTIFICATION DATE
	7-11-08	KW	3-7-07		7-23-07	SA	11-14-07
01	7-23-07	SA	11-14-07				

NOTE:
THIS TCP II/128/90-01 IS FOR
FINAL IMPROVEMENT

~~NOTE: THIS TCP II-128/90-01 IS FOR ROUGH GRADING ONLY. THE REFORESTATION AREAS ARE NOT CONSIDERED APPROVED ON THIS PLAN AND MUST BE SHOWN ON A REVISED TCP-II WITH BUILDING LOCATIONS AND GRADING PRIOR TO ISSUANCE OF THE FIRST BUILDING PERMIT.~~

M-NCPPC Prince George's County Planning Department Environmental Planning Section APPROVAL TREE CONSERVATION PLAN TCPII / 128 / 90			
REV. No.	APPROVED BY	DATE	ASSOCIATED CASE
	JIM STASZ	8/07/90	
01	ROBERT E. METZGER	5/20/04	
02	ROBERT E. METZGER	9/22/04	
03	ROBERT E. METZGER	11/10/06	DSP-05044 PGCPB No. 05-2
04	KATINA SHOULARS	6/2/08	DSP-05044/03 PLANNING DIRECT
05	KATINA SHOULARS	2/4/10	
06	KATINA SHOULARS	11/15/08	DSP-05044/05
07	KATINA SHOULARS	12/27/13	STAFF LEVEL
08	MEGAN K. REISER	6/30/14	STAFF LEVEL
09	MEGAN K. REISER	11/13/14	STAFF LEVEL
10	Megan K. Reiser	2/14/17	DSP-16023 PGCPB No. 16-1

PARCELS 1, 22, 24, 34-37, 39-41, 50, 53-61 & 63-66
PARCEL 'K', OUTLOT "A" AND OUTPARCEL "A"

STEEPLECHASE
BUSINESS PARK

13TH / HENT ELECTION DISTRICT
PRINCE GEORGE'S COUNTY, MARYLAND

$$1'' = 30'$$

SHEET _____
OF _____

G. L. W. FILE
12026

GLW GUTSCHICK LITTLE & WEBER, P.A.
CIVIL ENGINEERS, LAND SURVEYORS, LAND PLANNERS, LANDSCAPE ARCHITECTS
3909 NATIONAL DRIVE - SUITE 250 - BURTONSVILLE OFFICE PARK
BURTONSVILLE, MARYLAND 20866
TEL: 301-421-4024 BAL: 410-880-1820 DC/VA: 301-989-2524 FAX: 301-421-4186

OWNER/DEVELOPER

ATAPCO RITCHIE INTERCHANGE, INC
10 EAST BALTIMORE AVE
SUITE 1600
BALTIMORE, MD 21202
CONTACT: KEVIN MCANDREWS
410-347-7185

KEY MESSAGE

Rockville
Lanham
Frederick
Waldorf
Leonardtown
Fairfax

 Soltesz Associates, Inc.
LANHAM OFFICE
4266 Forbes Boulevard
Lanham, MD 20706
T. 301.794.7555 F. 301.794.7655

Engineering
Planning
Surveying
Environmental Services

~~www.LSAssociates.net~~

NO.	REVISION		
DATE: JULY, 2013	CAD STANDARDS VERSION: AUTOCAD CIVIL 3D 2011		
DES. XXX	DRN. XXX	CHK. XX	

ADC MAP	
MAP <u>19</u>	GRID <u>H-6</u>
TAX MAP 74 GRID C-3, D-3, E-3 GRID C-4, D-4, E-4 M-NCPPC 200' SHEET 202 SE 08 WSSC 200' SHEET 202 SE 08	ZONING CATALOG I-1

TREE CONSERVATION PLAN TYPE II


MISS UTILITY NOT

INFORMATION CONCERNING EXISTING UNDERGROUND UTILITIES WAS OBTAINED FROM AVAILABLE RECORDS. THE CONTRACTOR MUST DETERMINE THE EXACT LOCATION AND ELEVATION OF ALL EXISTING UTILITIES AND UTILITY CROSSINGS BY DIGGING TEST PITS BY HAND WELL IN ADVANCE OF THE START OF EXCAVATION. CONTACT "MISS UTILITY" AT 1-800-257-7777, 48 HOURS PRIOR TO THE START OF EXCAVATION. IF CLEARANCES ARE LESS THAN SHOWN ON THIS PLAN OR TWELVE (12) INCHES, WHICHEVER IS LESS, CONTACT THE ENGINEER AND THE UTILITY COMPANY BEFORE PROCEEDING WITH CONSTRUCTION. CLEARANCES LESS THAN NOTED MAY REQUIRE PROTECTIVE TRENCH SHIELDING.

© GLW 201

LEGEND


- LOO ULTIMATE LIMITS OF DISTURBANCE
- EXISTING TREE LINE
- PROPOSED TREE LINE
- PMA PRIMARY MANAGEMENT AREA LINE (PMA)
- EXISTING STREAM
- SVB STREAM BUFFER
- NON-TIDAL WETLANDS
- WB WETLANDS BUFFER
- 15%-25% (K FACTOR GREATER THAN 0.35)
- 25% SLOPES
- TPF TREE PROTECTION DEVICE (UPHILL)
- SF SILT FENCE (DOWNHILL TREE PROTECTION DEVICE)
- SSF SUPER SILT FENCE
- POST RAIL FENCE
- EARTH DIKE (DOWNHILL TREE PROTECTION DEVICE)
- TREE PRESERVATION AREA SIGN
- SPECIMEN TREE
- EX. NON-SPECIMEN TREE
- TREE PRESERVATION AREAS
- REFORESTATION AREAS
- FLOODPLAIN CLEARING AREAS

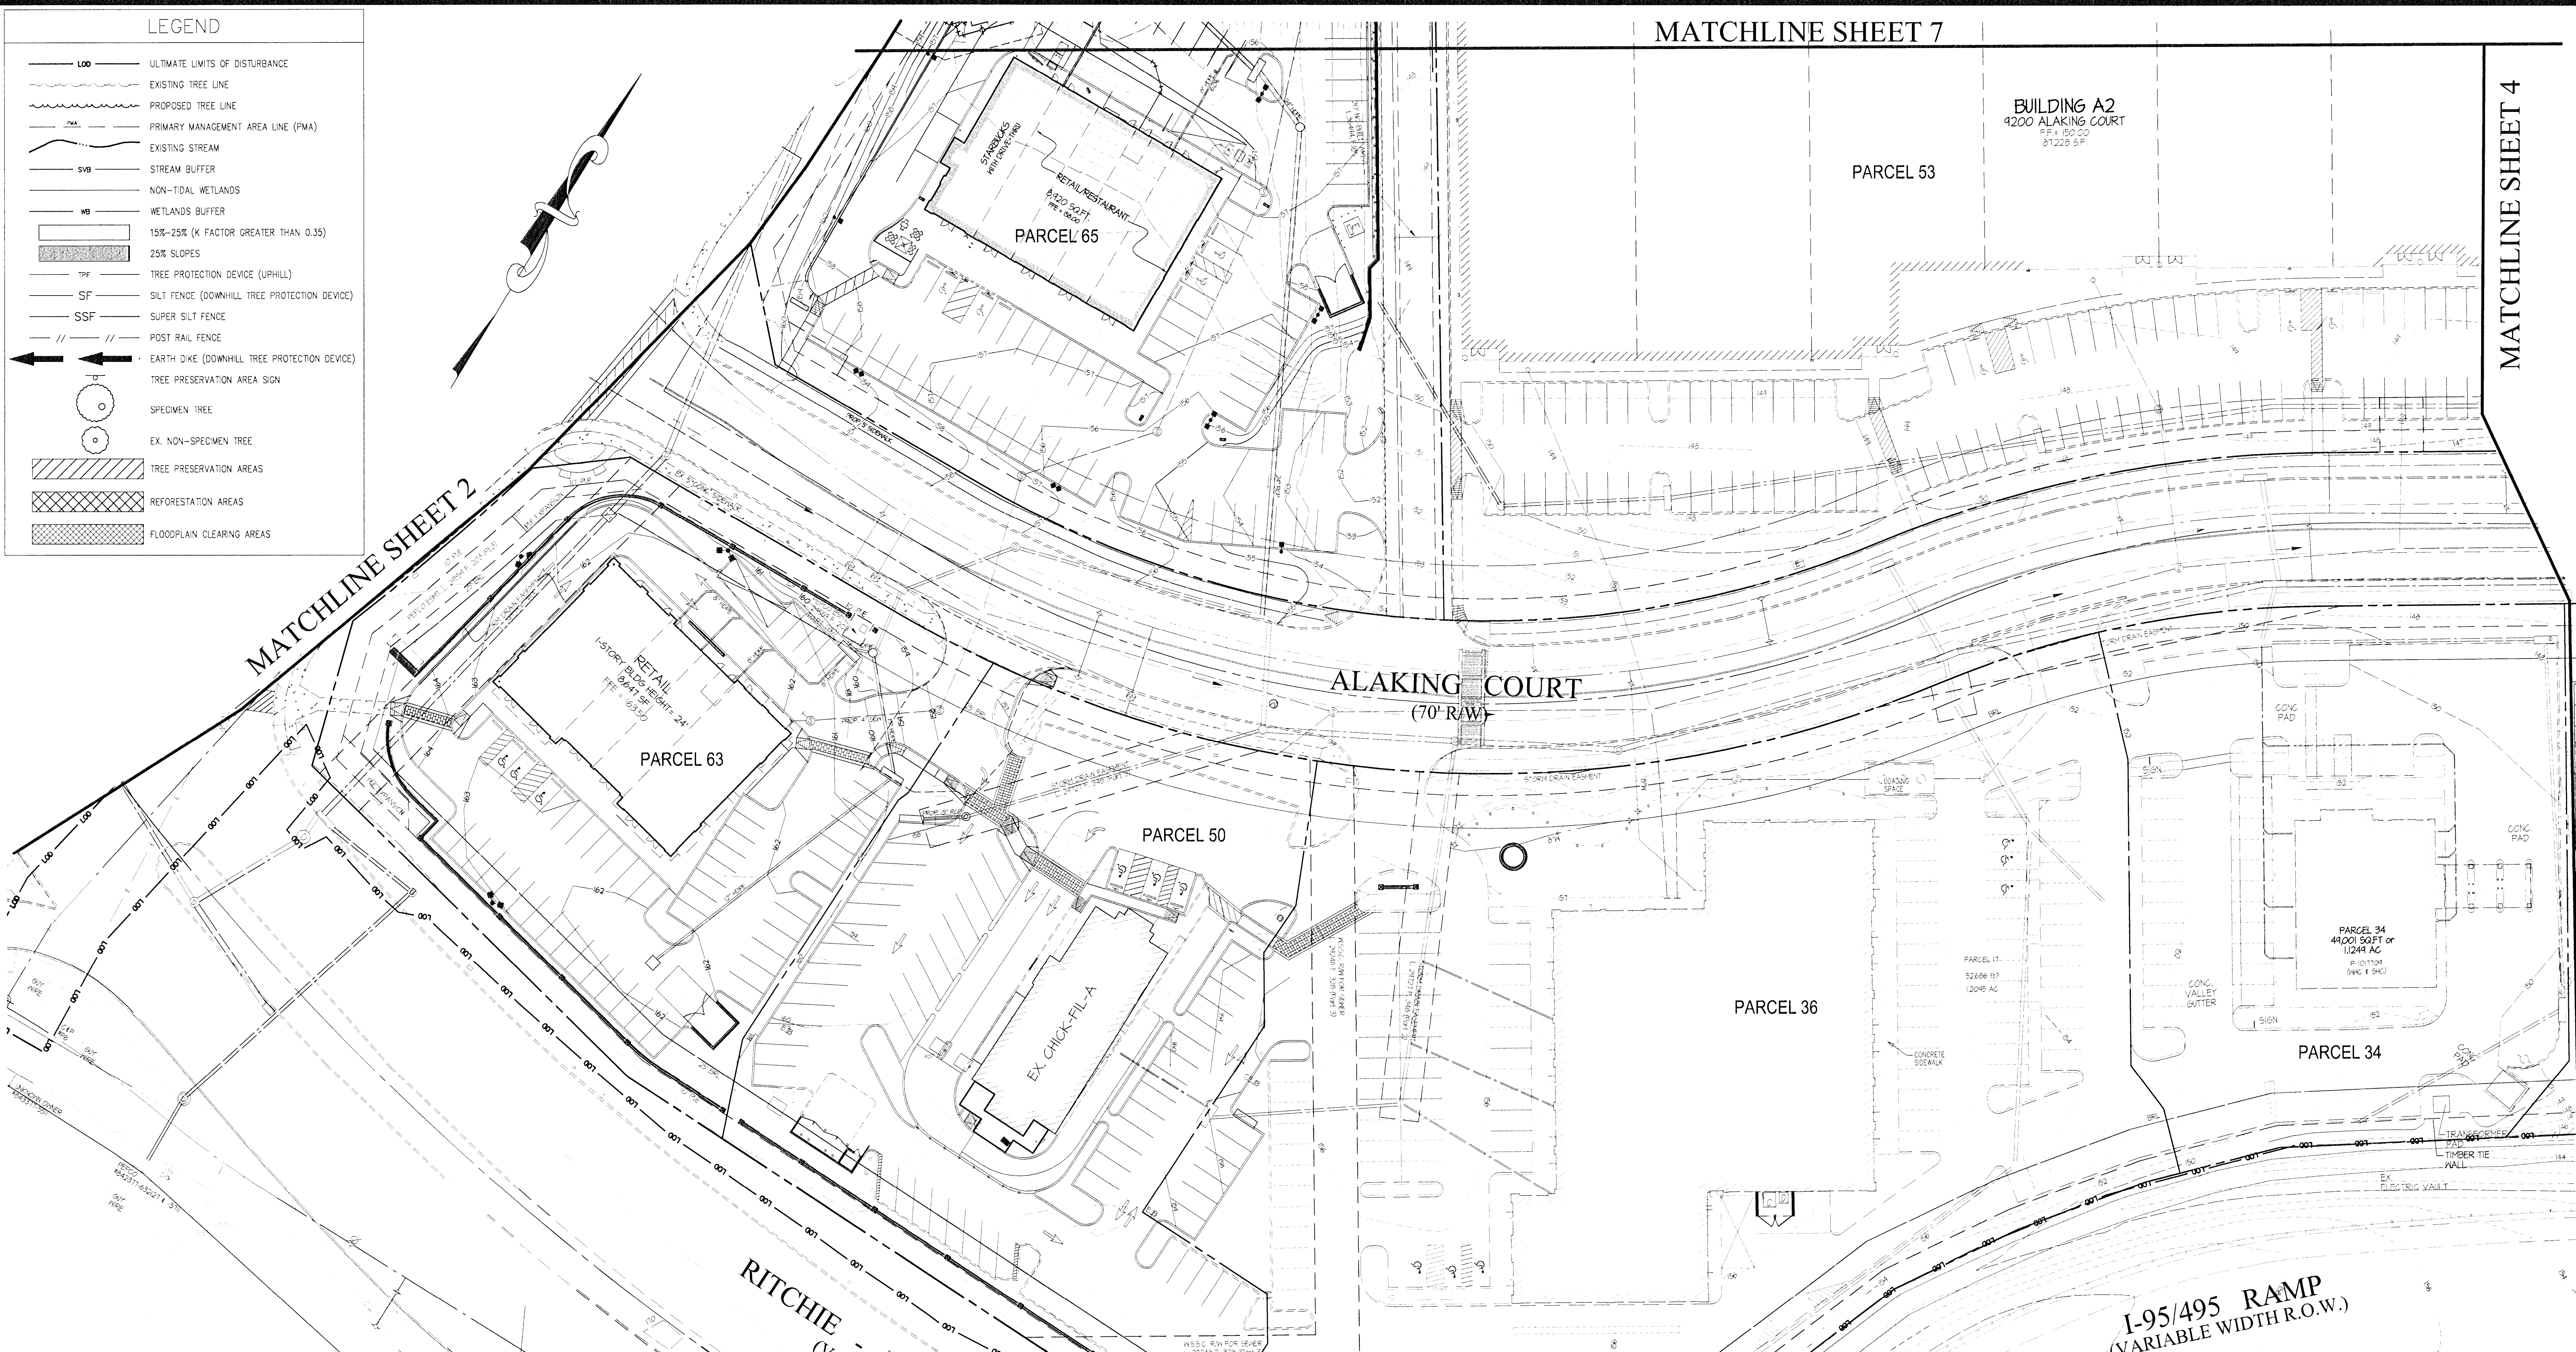

CHANGES TO PARCEL 65
PER DSP-16009

GLWGUTSCHICK LITTLE & WEBER, P.A.
CIVIL ENGINEERS, LAND SURVEYORS, LAND PLANNERS, LANDSCAPE ARCHITECTS
3909 NATIONAL DRIVE - SUITE 250 - BURTINSVILLE OFFICE PARK
BURTINSVILLE, MARYLAND 20866
TEL: 301-421-4024 BAL: 410-963-1820 DC/VA: 301-989-2524 FAX: 301-421-4186

OWNER/DEVELOPER
ATAPCO RITCHIE INTERCHANGE, INC.
10 EAST BALTIMORE AVE
SUITE 1600
BALTIMORE, MD 21202
CONTACT: KEVIN MCANDREWS
410-347-7185

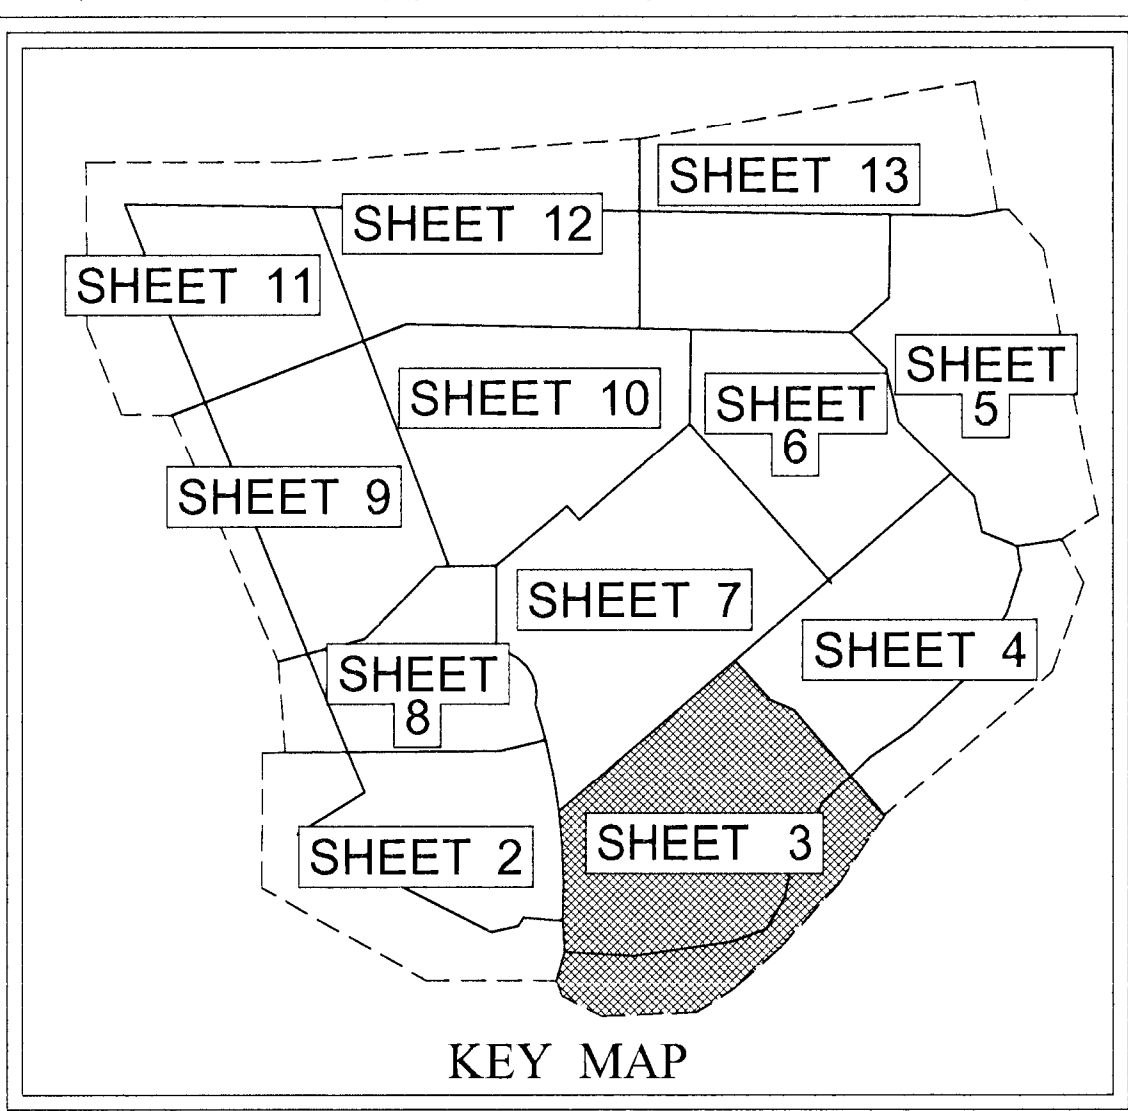

NOTE:
THIS TCP II/128/90-01 IS FOR
FINAL IMPROVEMENT

NOTE:
THIS TCP II/128/90-01 IS FOR ROUGH GRADING
ONLY. THE REFORESTATION AREAS ARE NOT
CONSIDERED APPROVED ON THIS PLAN AND
MUST BE SHOWN ON A REVISED TCP-II WITH
BUILDING LOCATIONS AND GRADING PRIOR TO
ISSUANCE OF THE FIRST BUILDING PERMIT.

M-NCPPC APPROVALS				M-NCPPC APPROVALS			
PROJECT NAME: STEEPLECHASE BUSINESS PARK				PROJECT NAME: STEEPLECHASE BUSINESS PARK			
PROJECT NUMBER: DSP-05044				PROJECT NUMBER: DSP-05044			
FOR CONDITIONS OF APPROVAL, SEE SITE PLAN COVER SHEET OR APPROVAL SHEET REVISED LISTED BELOW APPLY TO THIS SHEET				FOR CONDITIONS OF APPROVAL, SEE SITE PLAN COVER SHEET OR APPROVAL SHEET REVISED LISTED BELOW APPLY TO THIS SHEET			
APPROVAL OF REVISION #	APPROVAL DATE	REVIEWER'S INITIALS	CERTIFICATION DATE	APPROVAL OF REVISION #	APPROVAL DATE	REVIEWER'S INITIALS	CERTIFICATION DATE
01	7-23-07	SA	11-14-07				



M-NCPPC Prince George's County Planning Department Environmental Planning Section APPROVAL TREE CONSERVATION PLAN TCP II / 128 / 90			
REV. No.	APPROVED BY	DATE	ASSOCIATED CASE
	JIM STASZ	8/07/90	
01	ROBERT E. METZGER	5/20/04	
02	ROBERT E. METZGER	9/22/04	
03	ROBERT E. METZGER	11/10/06	DSP-05044 PCCPB No. 05-240
04	KATINA SHOULARS	6/2/08	DSP-05044/03 PLANNING DIRECTOR
05	KATINA SHOULARS	2/4/10	
06	KATINA SHOULARS	11/15/06	DSP-05044/05
07	KATINA SHOULARS	12/27/13	STAFF LEVEL
08	MEGAN K. REISER	6/30/14	STAFF LEVEL
09	MEGAN K. REISER	11/13/14	STAFF LEVEL
10	Megan K. Reiser	2/14/17	DSP-16023 PCCPB No. 16-139

PARCELS 1, 22, 24, 34-37, 39-41, 50, 53-61 & 63-66
PARCEL 'K', OUTLOT 'A' AND OUTPARCEL 'A'

**STEEPLECHASE
BUSINESS PARK**
13TH / HENT ELECTION DISTRICT
PRINCE GEORGE'S COUNTY, MARYLAND

**TREE CONSERVATION PLAN
TYPE II**

MISS UTILITY NOTE
INFORMATION CONCERNING EXISTING UNDERGROUND UTILITIES WAS
OBTAINED FROM AVAILABLE RECORDS. THE CONTRACTOR MUST
DETERMINE THE EXACT LOCATION AND ELEVATION OF ALL EXISTING
UTILITIES AND UTILITY CROSSINGS BY DIGGING TEST PITS BY HAND.
WELL IN ADVANCE OF THE START OF EXCAVATION, CONTACT "MISS
UTILITY" AT 1-800-251-7777, 48 HOURS PRIOR TO THE START OF
EXCAVATION. IF CLEARANCES ARE LESS THAN SHOWN ON THIS PLAN
OR TWELVE (12) INCHES, WHICHEVER IS LESS, CONTACT THE
ENGINEER AND THE UTILITY COMPANY BEFORE PROCEEDING WITH
CONSTRUCTION. CLEARANCES LESS THAN NOTED MAY REQUIRE
REVISIONS TO THIS PLAN.

MATCHLINE SHEET 4


MATCHLINE SHEET 7


MATCHLINE SHEET 2

LS Leander Associates, Inc.
Solese, Frederick, Waidott, Leonardtown, Fairfax
Lanham Office
4266 Fort Belvoir
Lanham, MD 20706
P: 301.794.7555 F: 301.794.7556
www.LSAssociates.com

																																																																																																																																																																																																																																																																																																																																																																																																																																																																																																																																																																																																																																																																																																																																																																																																																																																																																																																																																																																																																																																																																																																																																																																																																																																																																																																																																																																																																					</
--	--	----

ADC MAP	
MAP 19	GRID H-6
TAX MAP 74	ZONING CATEGORY I-1
GRID C-3, D-3, E-3	
GRID C-4, D-4, E-4	
M-NCPPC 200' SHEET	
202 SE 08	
WSSC 200' SHEET	
202 SE 08	

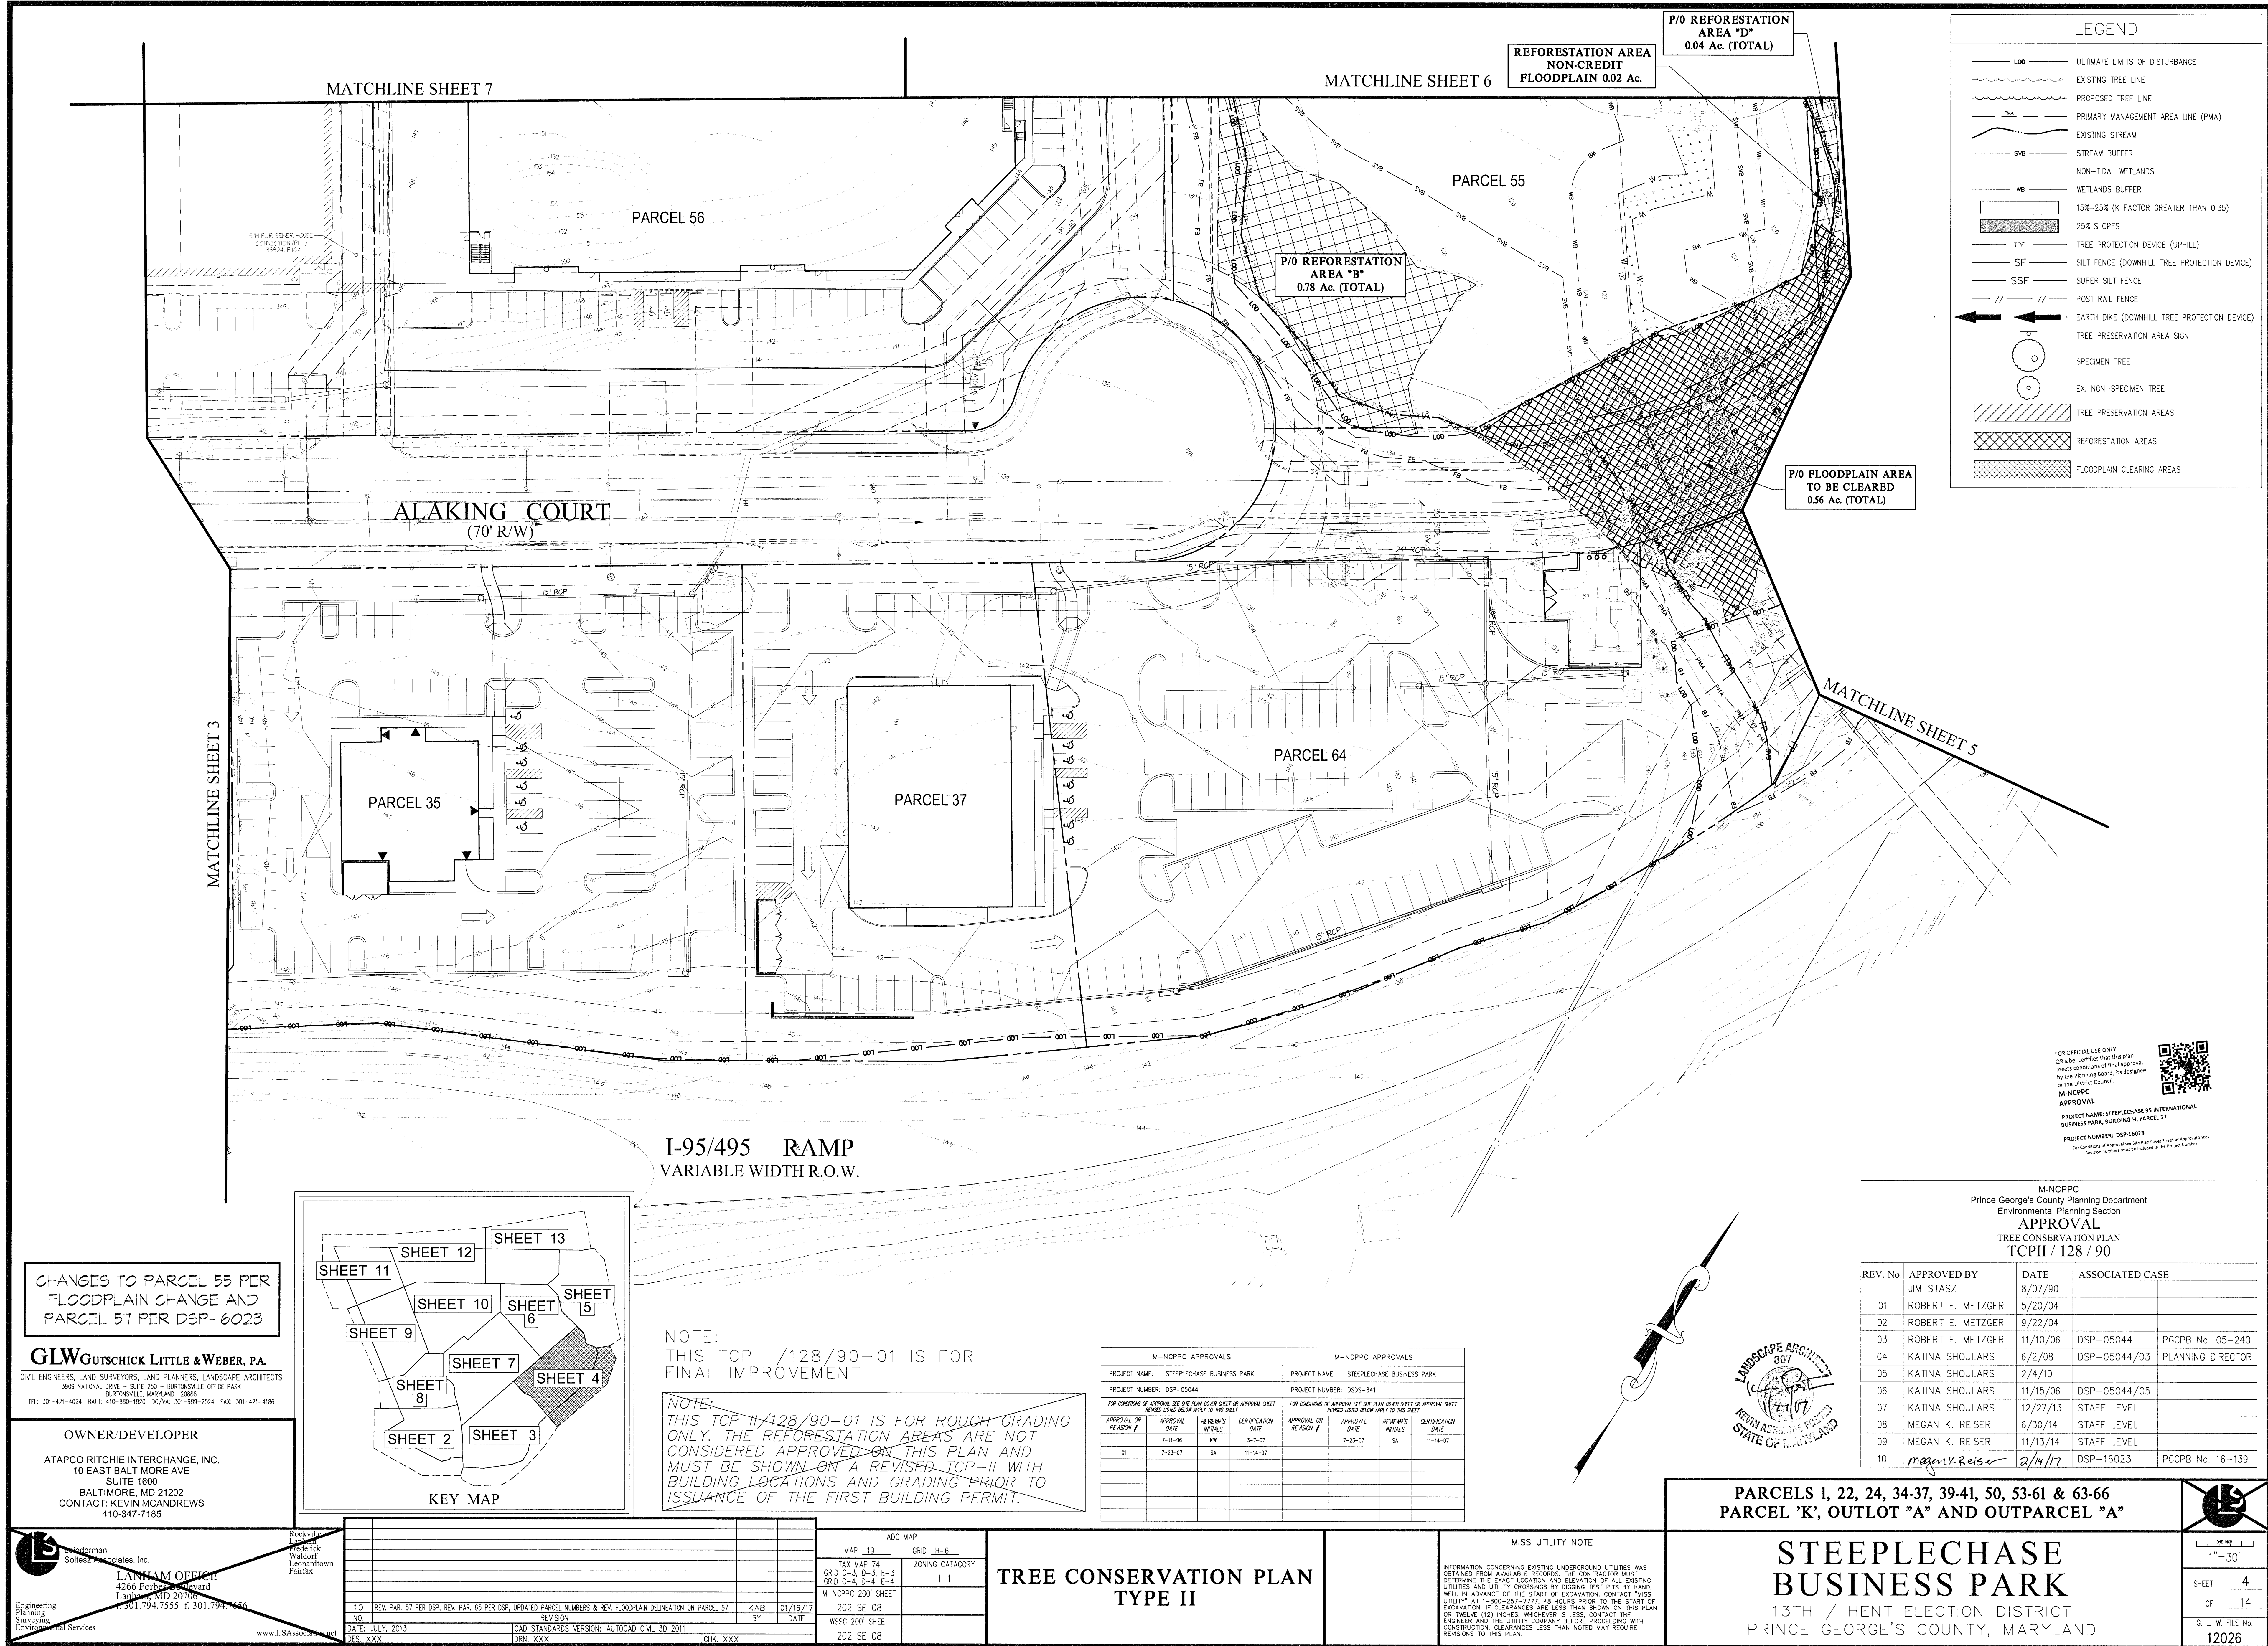

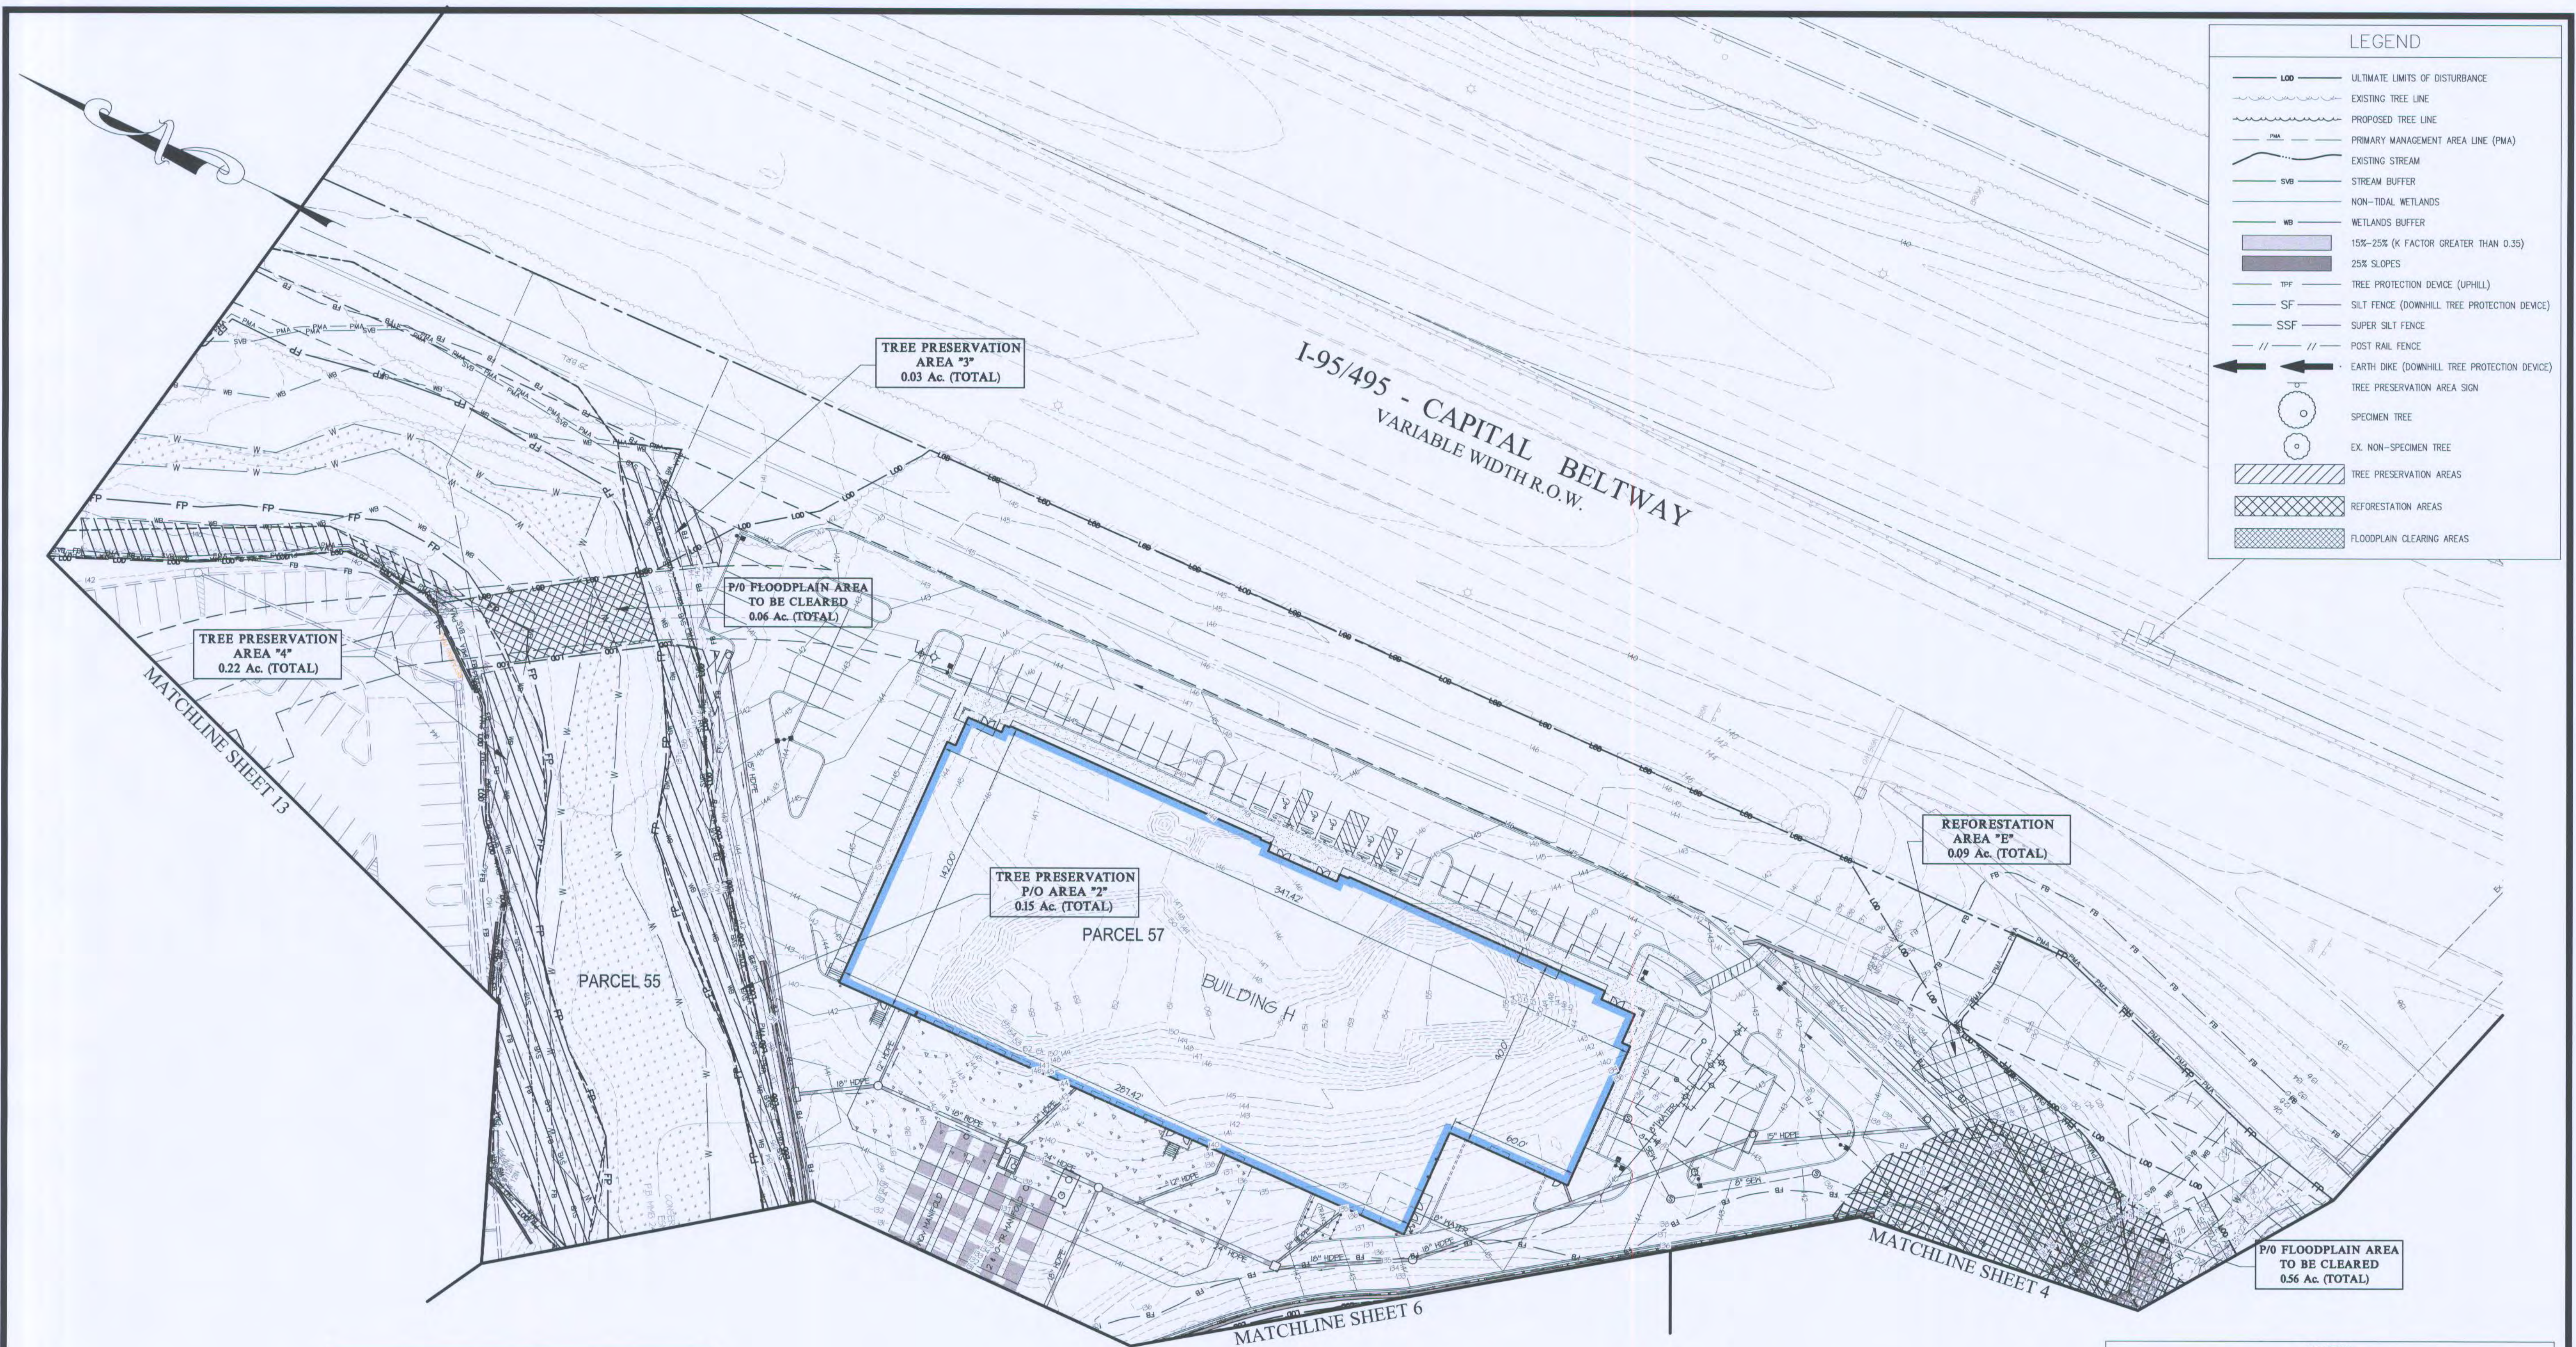


LEGEND	
	ULTIMATE LIMITS OF DISTURBANCE
	EXISTING TREE LINE
	PROPOSED TREE LINE
	PRIMARY MANAGEMENT AREA LINE (PMA)
	EXISTING STREAM
	STREAM BUFFER
	NON-TIDAL WETLANDS
	WETLANDS BUFFER
	15%-25% (K FACTOR GREATER THAN 0.35)
	25% SLOPES
	TREE PROTECTION DEVICE (UPHILL)
	SILTY FENCE (DOWNHILL TREE PROTECTION DEVICE)
	SUPER SILTY FENCE
	POST RAIL FENCE
	EARTH DIKE (DOWNHILL TREE PROTECTION DEVICE)
	TREE PRESERVATION AREA SIGN
	SPECIMEN TREE
	EX. NON-SPECIMEN TREE
	TREE PRESERVATION AREAS
	REFORESTATION AREAS
	FLOODPLAIN CLEARING AREAS

CHANGES TO PARCEL 57
PER DSP-16023

GLWGUTSCHICK LITTLE & WEBER, P.A.
CIVIL ENGINEERS, LAND SURVEYORS, LAND PLANNERS, LANDSCAPE ARCHITECTS
3909 NATIONAL DRIVE - SUITE 200 - BURTCHVILLE OFFICE PARK
BURTCHVILLE, MARYLAND 20866
TEL: 301-421-4024 BAL: 410-880-1820 DC/VA: 301-989-2524 FAX: 301-421-4186

OWNER/DEVELOPER
ATAPCO RITCHIE INTERCHANGE, INC.
10 EAST BALTIMORE AVE
SUITE 1600
BALTIMORE, MD 21202
CONTACT: KEVIN MCANDREWS
410-347-7185

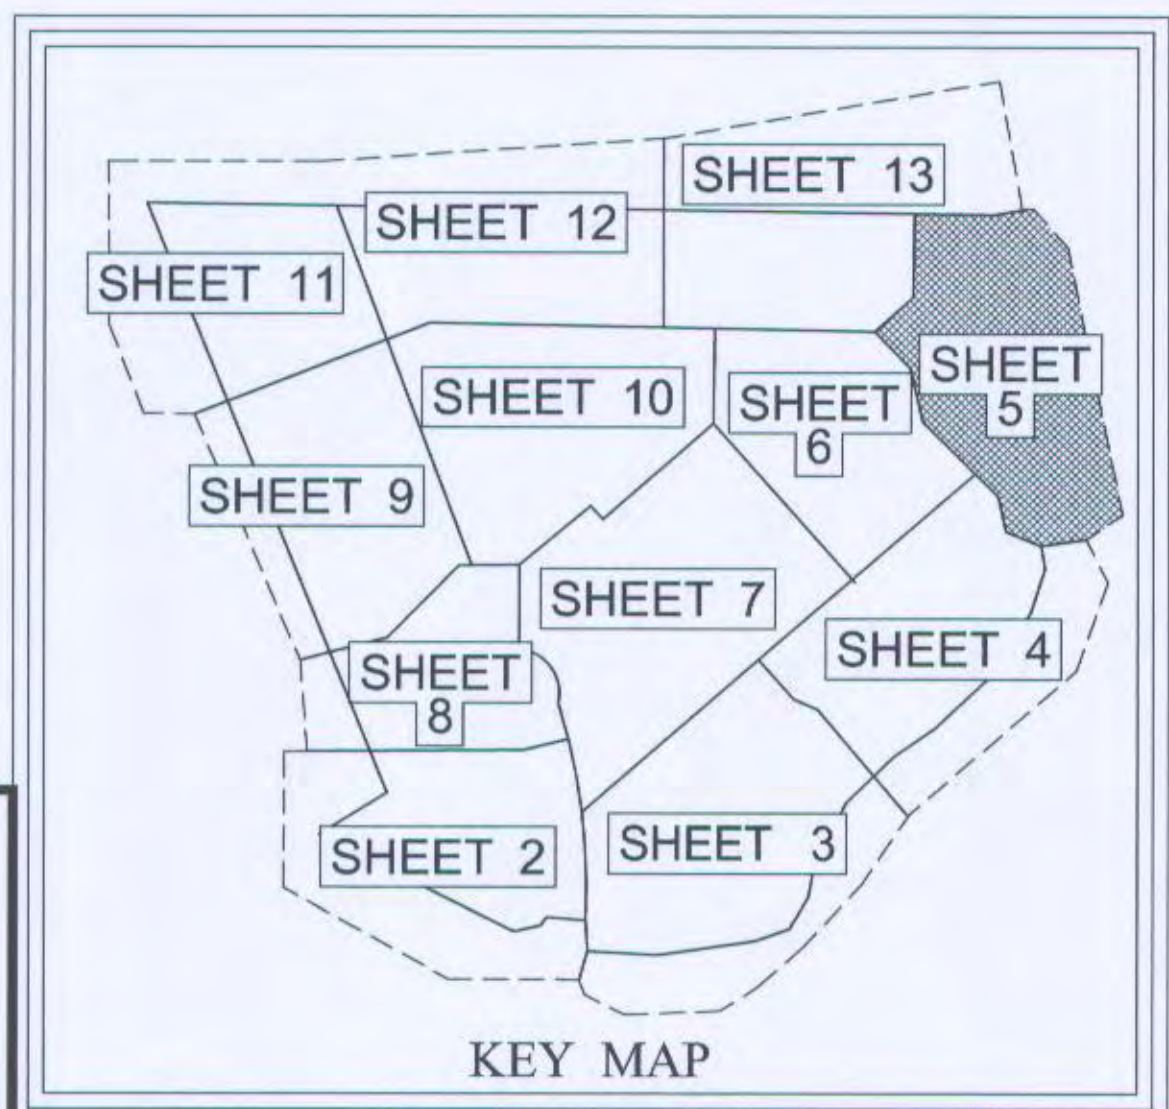

NOTE:
THIS TCP II/128/90-01 IS FOR
FINAL IMPROVEMENT

NOTE:
THIS TCP II/128/90-01 IS FOR ROUGH GRADING
ONLY. THE REFORESTATION AREAS ARE NOT
CONSIDERED APPROVED ON THIS PLAN AND
MUST BE SHOWN ON A REVISED TCP-II WITH
BUILDING LOCATIONS AND GRADING PRIOR TO
ISSUANCE OF THE FIRST BUILDING PERMIT.

M-NCPPC APPROVALS				M-NCPPC APPROVALS			
PROJECT NAME: STEEPLCHASE BUSINESS PARK				PROJECT NAME: STEEPLCHASE BUSINESS PARK			
PROJECT NUMBER: DSP-05044				PROJECT NUMBER: DSP-05044			
FOR CONDITIONS OF APPROVAL, SEE THE PLAN COVER SHEET OR APPROVAL SHEET				FOR CONDITIONS OF APPROVAL, SEE THE PLAN COVER SHEET OR APPROVAL SHEET			
APPROVAL OR REVISION #	APPROVAL DATE	REVIEWER'S INITIALS	CERTIFICATION DATE	APPROVAL OR REVISION #	APPROVAL DATE	REVIEWER'S INITIALS	CERTIFICATION DATE
01	7-23-07	SA	11-14-07	01	7-23-07	SA	11-14-07



M-NCPPC Prince George's County Planning Department Environmental Planning Section APPROVAL TREE CONSERVATION PLAN TCP II / 128 / 90			
REV. No.	APPROVED BY	DATE	ASSOCIATED CASE
	JIM STASZ	8/07/90	
01	ROBERT E. METZGER	5/20/04	
02	ROBERT E. METZGER	9/22/04	
03	ROBERT E. METZGER	11/10/06	DSP-05044 PGCPB No. 05-240
04	KATINA SHOULARS	6/2/08	DSP-05044/03 PLANNING DIRECTOR
05	KATINA SHOULARS	2/4/10	
06	KATINA SHOULARS	11/15/06	DSP-05044/05
07	KATINA SHOULARS	12/27/13	STAFF LEVEL
08	MEGAN K. REISER	6/30/14	STAFF LEVEL
09	MEGAN K. REISER	11/13/14	STAFF LEVEL
10	MEGAN K. REISER	2/14/17	DSP-16023 PGCPB No. 16-139

PARCELS 1, 22, 24, 34-37, 39-41, 50, 53-61 & 63-66
PARCEL 'K', OUTLOT 'A' AND OUTPARCEL 'A'

**STEEPLECHASE
BUSINESS PARK**
13TH / HENT ELECTION DISTRICT
PRINCE GEORGE'S COUNTY, MARYLAND

1"=30'
SHEET 5
OF 14
G. L. W. FILE No. 12026

M-NCPPC Prince George's County Planning Department Environmental Planning Section APPROVAL TREE CONSERVATION PLAN TCPII / 128 / 90			
REV. No.	APPROVED BY	DATE	ASSOCIATED CASE
	JIM STASZ	8/07/90	
01	ROBERT E. METZGER	5/20/04	
02	ROBERT E. METZGER	9/22/04	
03	ROBERT E. METZGER	11/10/06	DSP-05044 PGPB No. 05-240
04	KATINA SHOULARS	6/2/08	DSP-05044/03 PLANNING DIRECTOR
05	KATINA SHOULARS	2/4/10	
06	KATINA SHOULARS	11/15/06	DSP-05044/05
07	KATINA SHOULARS	12/27/13	STAFF LEVEL
08	MEGAN K. REISER	6/30/14	STAFF LEVEL
09	MEGAN K. REISER	11/13/14	STAFF LEVEL
10	Megan K. Reiser	2/14/17	DSP-16023 PGPB No. 16-139


- NOTE:
1. THIS TCP II/128/90-01 IS FOR FINAL IMPROVEMENT
 2. SEE SHEET 14A FOR OVERALL PLAN OF CONSERVATION EASEMENT REVISION.
 3. TCP II REVISION #08 APPLIES TO SHEETS 1, 7, 8, 10, & 14A ONLY

MATCHLINE (SEE SHEET 10)


NOTE:
THIS TCP II/128/90-01 IS FOR ROUGH GRADING ONLY. THE REFORESTATION AREAS ARE NOT CONSIDERED APPROVED ON THIS PLAN AND MUST BE SHOWN ON A REVISED TCP-II WITH BUILDING LOCATIONS AND GRADING PRIOR TO ISSUANCE OF THE FIRST BUILDING PERMIT.

MATCHLINE (SEE SHEET 10)

M-NCPPC APPROVALS				M-NCPPC APPROVALS			
PROJECT NAME: STEEPLECHASE BUSINESS PARK				PROJECT NAME: STEEPLECHASE BUSINESS PARK			
PROJECT NUMBER: DSP-05044				PROJECT NUMBER: DSDS-641			
FOR CONDITIONS OF APPROVAL SEE THE PLAN COVER SHEET OR APPROVAL SHEET REVISED LISTED BELOW APPLY TO THIS SHEET				FOR CONDITIONS OF APPROVAL SEE THE PLAN COVER SHEET OR APPROVAL SHEET REVISED LISTED BELOW APPLY TO THIS SHEET			
APPROVAL OR REVISION #	APPROVAL DATE	REVIEWER'S INITIALS	DATE	APPROVAL OR REVISION #	APPROVAL DATE	REVIEWER'S INITIALS	DATE
01	7-11-06	KW	3-7-07				
	7-23-07	SA	11-14-07				

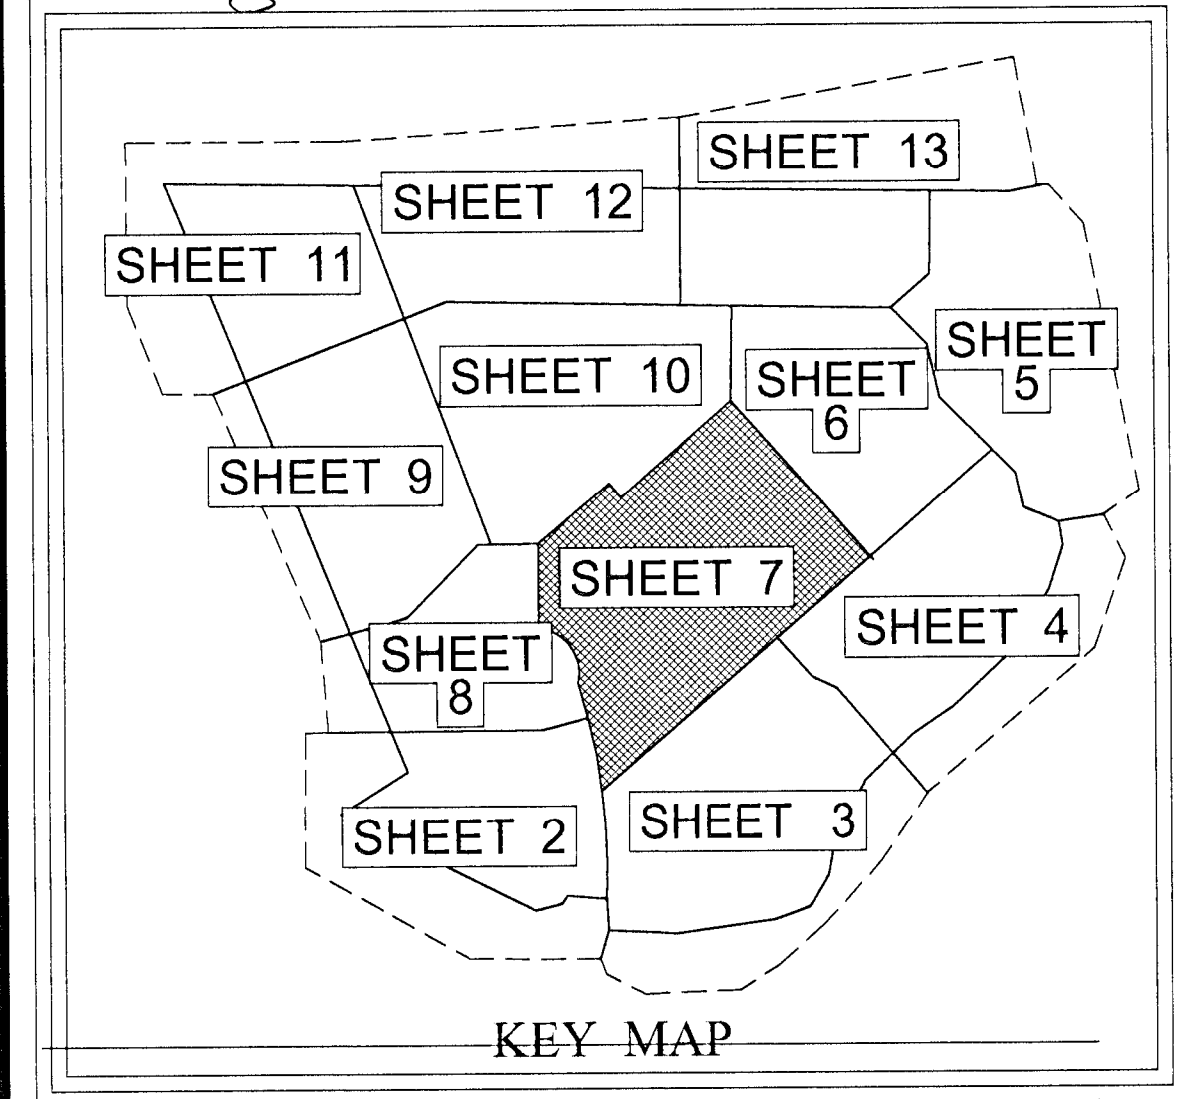

LEGEND	
	ULTIMATE LIMITS OF DISTURBANCE
	EXISTING TREE LINE
	PROPOSED TREE LINE
	PRIMARY MANAGEMENT AREA LINE (PMA)
	EXISTING STREAM
	STREAM BUFFER
	NON-TIDAL WETLANDS
	WETLANDS BUFFER
	15%-25% (K FACTOR GREATER THAN 0.35)
	25% SLOPES
	TREE PROTECTION DEVICE (UPHILL)
	SILT FENCE (DOWNHILL TREE PROTECTION DEVICE)
	SUPER SILT FENCE
	POST RAIL FENCE
	EARTH DIKE (DOWNHILL TREE PROTECTION DEVICE)
	TREE PRESERVATION AREA SIGN
	SPECIMEN TREE
	EX. NON-SPECIMEN TREE
	TREE PRESERVATION AREAS
	REFORESTATION AREAS
	FLOODPLAIN CLEARING AREAS

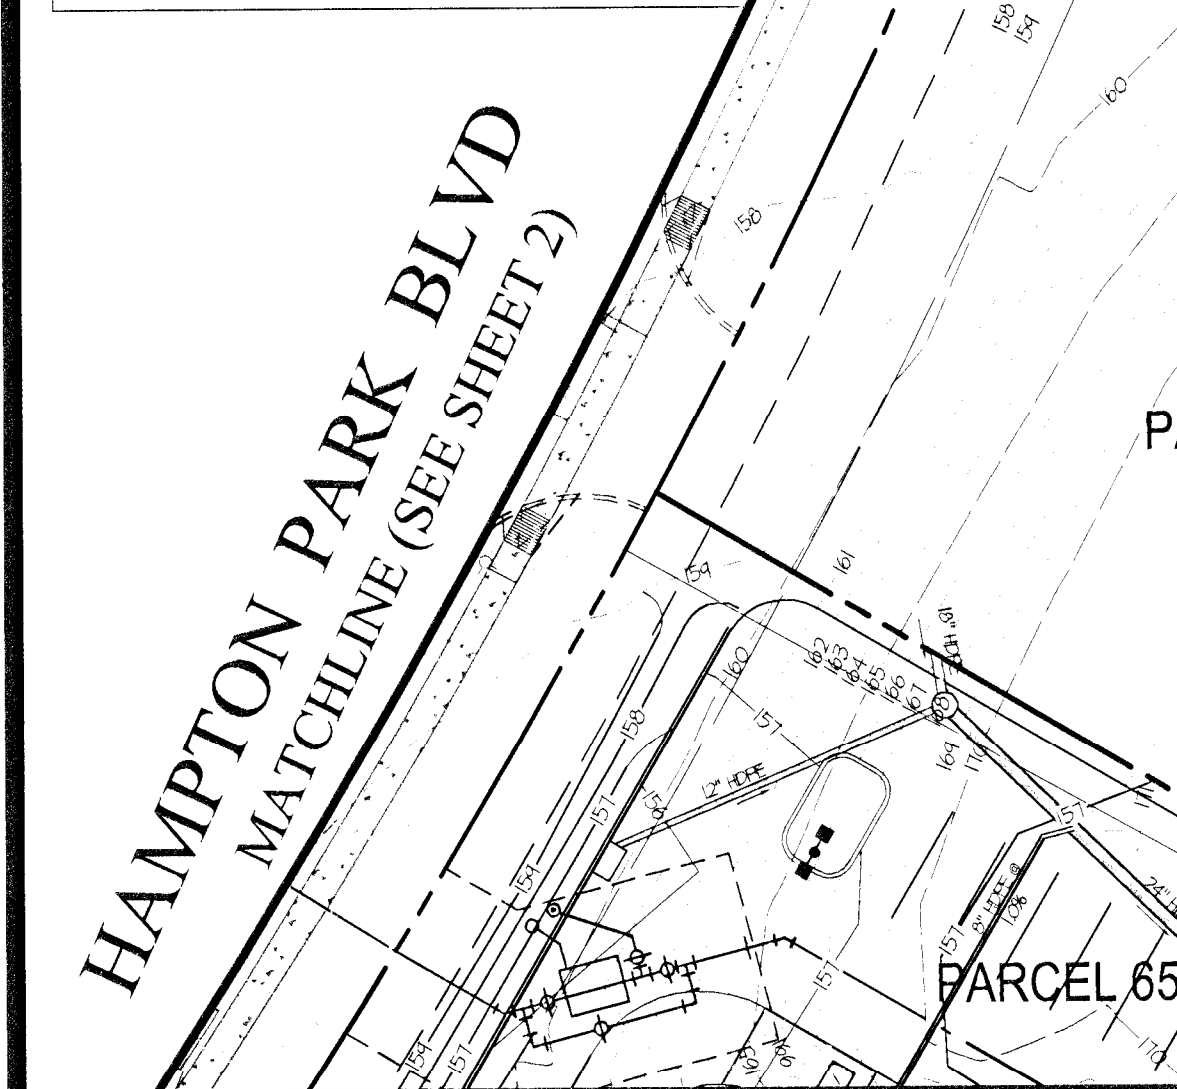

OWNER/DEVELOPER
ATAPCO PROPERTIES, INC.
10 EAST BALTIMORE AVE
SUITE 1501
BALTIMORE, MD 21202
CONTACT: KRISTINA MACEK
410-347-7163

GLWGUTSCHICK LITTLE & WEBER, P.A.
CIVIL ENGINEERS, LAND SURVEYORS, LAND PLANNERS, LANDSCAPE ARCHITECTS
3909 NATIONAL DRIVE - SUITE 250 - BURTONSVILLE OFFICE PARK
BURTONSVILLE, MARYLAND 20866
TEL: 301-421-4024 BALT: 410-850-1803 DC/VA: 301-489-2524 FAX: 301-421-4186

CHANGES TO PARCEL 65
PER DSP-16009

MATCHLINE (SEE SHEET 3)

LS
Landmark
Sotolosa & Associates, Inc.
LAWYER OFFICE
4266 Forbes Boulevard
Lanham, MD 20706
(301) 794-7555 F. (301) 794-7556

10	REV. PAR. 57 PER DSP, REV. PAR. 65 PER DSP, UPDATED PARCEL NUMBERS & REV. FLOODPLAIN DELINEATION ON PARCEL 57	KAB	01/15/17
7	REVISED TREE CONSERVATION EASEMENT	RLG	02/26/16
6	REVISED TREE CONSERVATION EASEMENT	RLG	12/17/13
5	REVISED TO MATCH PROPOSED FLOODPLAIN, REVISED SWM POND 5, AND CUL-DE-SAC &	CWJ	10/13/05
3	PARKING LOT AT PARCEL 19		
3	CHANGES PER CLIENT REVISIONS	CWJ	5/25/05
2	REV. PER FINAL IMPROVEMENT	YOR	8/04/04
1	REV. PER MNCPPC REVIEW COMMENTS DATED 5/10/04	BAM	5/11/04
	NO. REVISION	BY	DATE
1	DATE: JULY, 2013		
	DES. XXX		

ADC MAP	
MAP 19	GRID II-6
TAX MAP 74	ZONING CATEGORY
GRID C-3, D-3, E-3	I-1
GRID C-4, D-4, E-4	
M-NCPPC 200' SHEET	
WSSC 200' SHEET	
202 SE 08	



TREE CONSERVATION PLAN
TYPE II

MISS UTILITY NOTE
INFORMATION CONCERNING EXISTING UNDERGROUND UTILITIES WAS OBTAINED FROM AVAILABLE RECORDS. THE CONTRACTOR MUST DETERMINE THE EXACT LOCATION AND ELEVATION OF ALL EXISTING UTILITIES AND UTILITY CROSSINGS BY DIGGING TEST PITTS BY HAND, WELL IN ADVANCE OF THE START OF EXCAVATION. CONTACT "MISS UTILITY" AT 1-800-857-7777, 48 HOURS PRIOR TO THE START OF EXCAVATION. IF CLEARANCES ARE LESS THAN SHOWN ON THIS PLAN OR TWELVE (12) INCHES, WHICHEVER IS LESS, CONTACT THE ENGINEER AND THE UTILITY COMPANY BEFORE PROCEEDING WITH CONSTRUCTION. CLEARANCES LESS THAN NOTED MAY REQUIRE REVISIONS TO THIS PLAN.

PARCELS 1, 22, 24, 34-37, 39-41, 50, 53-61 & 63-66
PARCEL 'K', OUTLOT 'A' AND OUTPARCEL 'A'

STEPPLECHASE
BUSINESS PARK
13TH / HENT ELECTION DISTRICT
PRINCE GEORGE'S COUNTY, MARYLAND

1"=30'
SHEET 7
OF 14
G. L. W. FILE NO.
12026

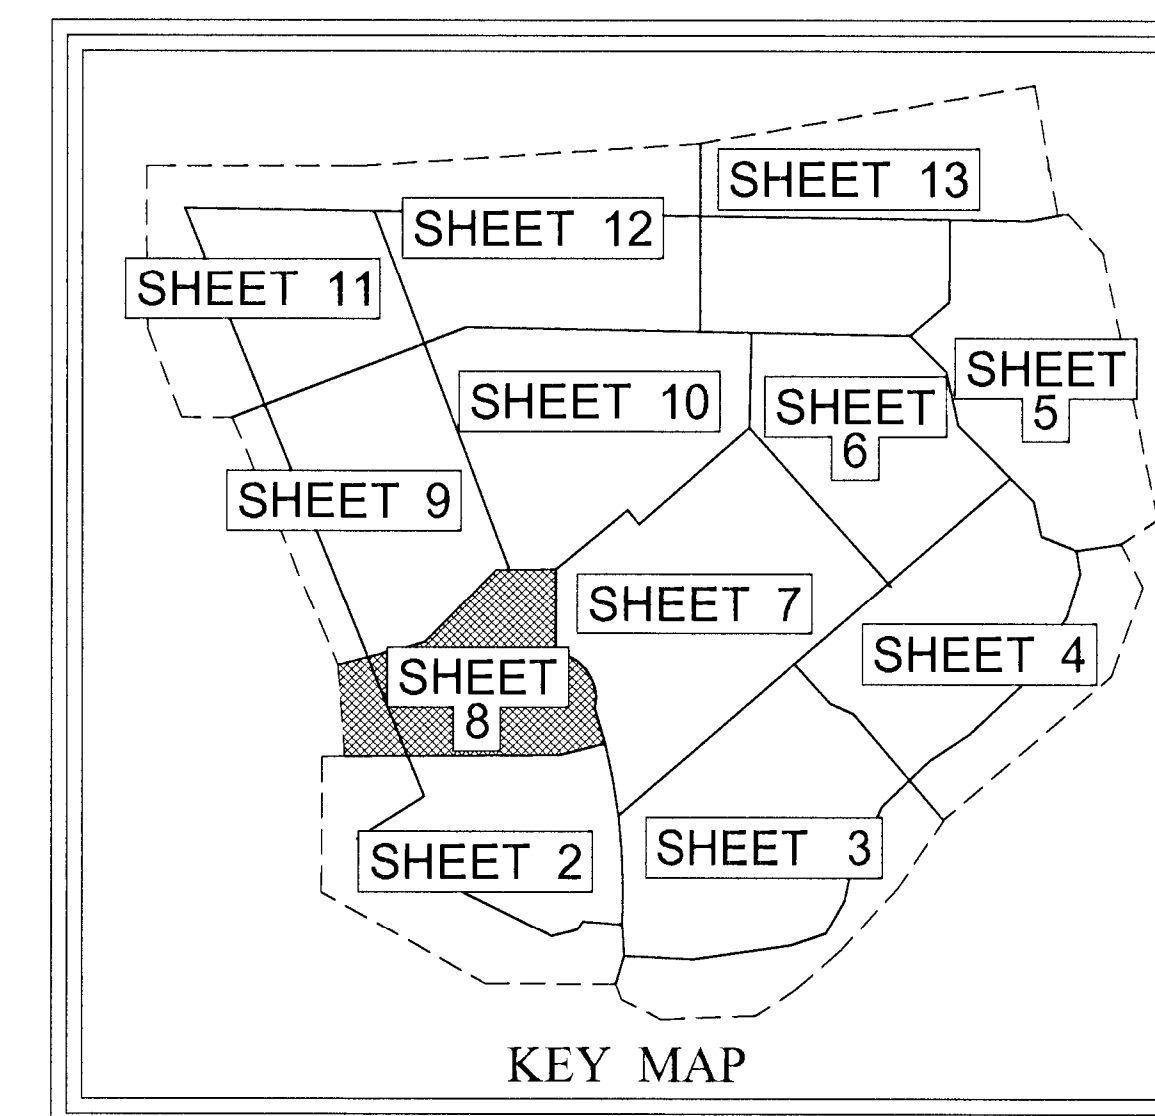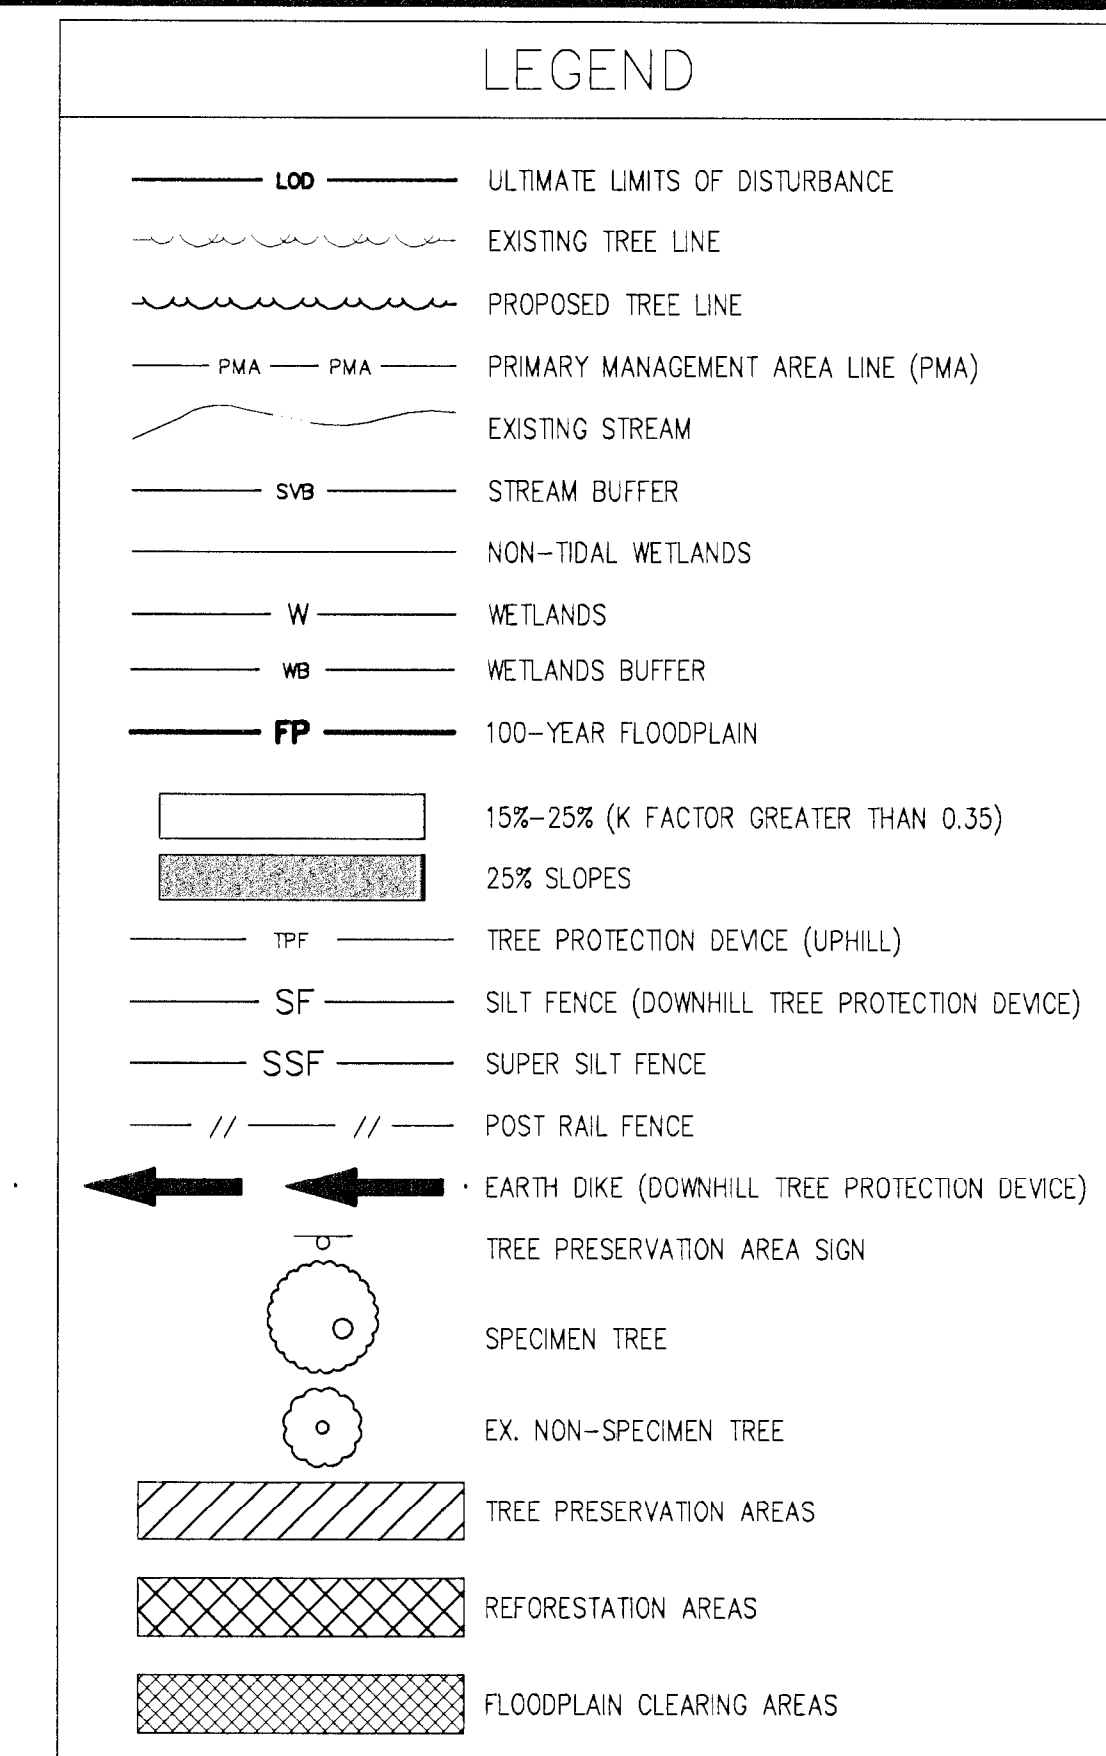[illegible]

Prince George's County Planning Department Environmental Planning Section APPROVAL TREE CONSERVATION PLAN TCPII / 128 / 90			
REV. No.	APPROVED BY	DATE	ASSOCIATED CASE
	JIM STASZ	8/07/90	
01	ROBERT E. METZGER	5/20/04	
02	ROBERT E. METZGER	9/22/04	
03	ROBERT E. METZGER	11/10/06	DSP - 05044 PGCPB No. 05-240
04	KATINA SHOULARS	6/2/08	DSP - 05044/03 PLANNING DIRECTOR
05	KATINA SHOULARS	2/4/10	
06	KATINA SHOULARS	11/15/08	DSP - 05044/05
07	KATINA SHOULARS	12/27/13	STAFF LEVEL
08	MEGAN K. REISER	6/30/14	STAFF LEVEL
09	MEGAN K. REISER	11/13/14	STAFF LEVEL
10	<i>Megan K. Reiser</i>	<i>2/14/17</i>	DSP - 16023 PGCPB No. 16-139


NOTE:
THIS TCP #128/90-01 IS FOR ROUGH GRADING ONLY. THE REFORESTATION AREAS ARE NOT CONSIDERED APPROVED ON THIS PLAN AND MUST BE SHOWN ON A REVISED TCP-11 WITH BUILDING LOCATIONS AND GRADING PRIOR TO ISSUANCE OF THE FIRST BUILDING PERMIT.

NOTE: TCPII REVISION #08 APPLIES TO SHEETS 1, 7, 8, 10, & 14A ONLY.

GLWGUTSCHICK LITTLE & WEBER, P.A.
CIVIL ENGINEERS, LAND SURVEYORS, LAND PLANNERS, LANDSCAPE ARCHITECTS
3909 NATIONAL DRIVE • SUITE 250 • BURTONTVILLE OFFICE PARK
BURTONTVILLE, MARYLAND 20866
TEL: X01-421-4024 RAI T: 410-880-1820 DC/VA: X01-989-2524 FAX: X01-421-4186

OWNER/DEVELOPER

ATAPCO PROPERTIES, INC.
10 EAST BALTIMORE AVE
SUITE 1501
BALTIMORE, MD 21202
CONTACT: KRISTINA MACEK
410-347-7163

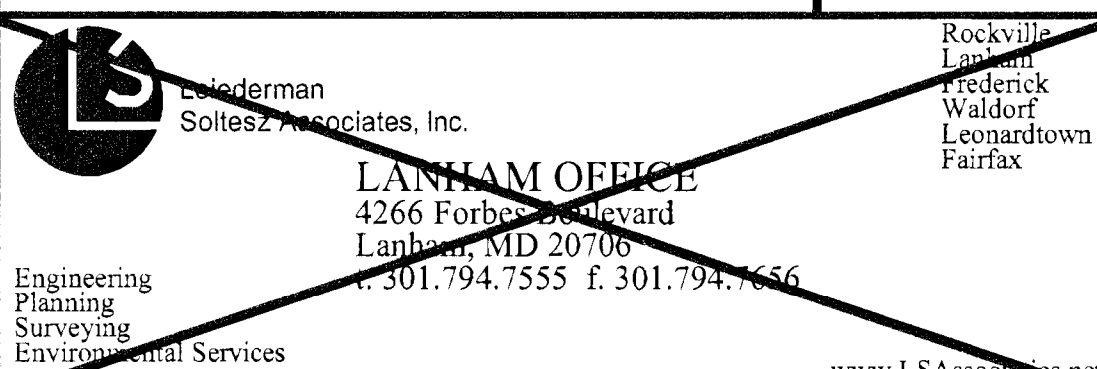

9	REVISED TREE CONSERVATION EASEMENT	RLG	2/28/14
8	REVISED TREE CONSERVATION EASEMENT	RLG	12/17/13
7	REVISED TREE CONSERVATION AREA 6 FOR TREE PLUS SEWER OUTFALL	CWJ	10/29/13
6	REVISED BUILDING AREA 4 COMMENTS, RESTORATION AREAS 5,6,7 AND 4 CHANGED	CWJ	10/29/13
5	REVISED TO MATCH PROPOSED FLOODPLAIN, REVISED SWM POND 5, AND CUL-DE-SAC & PARKING LOT AT PARCEL 19	CWJ	10/29/13
4	CHANGES PER CLIENT REVISIONS	CWJ	5/25/10
3	REV. PER FINAL IMPROVEMENT	YCR	8/04/04
1	REV. PER MNCPPRC REVIEW COMMENTS DATED 5/10/04	BAM	5/10/04
	REVISION	BT	DATE
NO	DATE: JULY, 2013	CDL STANFORD VERSION: AUTOCAD CIVIL 3D 2011	

ADC MAP	
MAP 19	GRID H-6
TAX MAP 74 GRID C-3, D-3, E-3 GRID C-4, D-4, E-4	ZONING CATEGORY I-1
M-NCPPC 200' SHEET 202 SE 08	
WSSC 200' SHEET	


**TREE CONSERVATION PLAN
TYPE II**

MISS UTILITY NOTE

INFORMATION CONCERNING EXISTING UNDERGROUND UTILITIES WAS OBTAINED FROM AVAILABLE RECORDS. THE CONTRACTOR MUST DETERMINE THE EXACT LOCATION AND ELEVATION OF ALL EXISTING UTILITIES AND UTILITY CROSSINGS BY DIGGING TEST PITS BY HAND WELL IN ADVANCE OF THE START OF EXCAVATION. CONTACT "MIS UTILITY" AT 1-800-257-7777, 48 HOURS PRIOR TO THE START OF EXCAVATION. IF CLEARANCES ARE LESS THAN SHOWN ON THIS PLAN OR TWELVE (12) INCHES, WHICHEVER IS LESS, CONTACT THE ENGINEER AND THE UTILITY COMPANY BEFORE PROCEEDING WITH CONSTRUCTION. CLEARANCES LESS THAN NOTED MAY REQUIRE

PARCELS 1, 22, 24, 34-37, 39-41, 50, 53-61 & 63-66
PARCEL 'K', OUTLOT "A" AND OUTPARCEL "A"

**STEEPLECHASE
BUSINESS PARK**
13TH / HENT ELECTION DISTRICT
PRINCE GEORGE'S COUNTY, MARYLAND

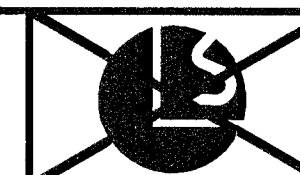

ONE INCH
1"=30'

SHEET 8
OF 14


G. L. W. FILE No.
12026

NOTE:
THIS TCP II/128/90-01 IS FOR ROUGH GRADING ONLY. THE REFORESTATION AREAS ARE NOT CONSIDERED APPROVED ON THIS PLAN AND MUST BE SHOWN ON A REVISED TCP-II WITH BUILDING LOCATIONS AND GRADING PRIOR TO ISSUANCE OF THE FIRST BUILDING PERMIT.

NOTE:
THIS TCP II/128/90-01 IS FOR FINAL IMPROVEMENT

LEGEND


- LOO ——— ULTIMATE LIMITS OF DISTURBANCE
- EXISTING TREE LINE
- PROPOSED TREE LINE
- PMA ——— PRIMARY MANAGEMENT AREA LINE (PMA)
- EXISTING STREAM
- SVB ——— STREAM BUFFER
- NON-TIDAL WETLANDS
- WBL ——— WETLANDS BUFFER
- 15%-25% (K FACTOR GREATER THAN 0.35)
- 25% SLOPES
- TPF ——— TREE PROTECTION DEVICE (UPHILL)
- SF ——— SILT FENCE (DOWNHILL TREE PROTECTION DEVICE)
- SSF ——— SUPER SILT FENCE
- POST RAIL FENCE
- EARTH DIKE (DOWNHILL TREE PROTECTION DEVICE)
- TREE PRESERVATION AREA SIGN
- SPECIMEN TREE
- EX. NON-SPECIMEN TREE
- TREE PRESERVATION AREAS
- REFORESTATION AREAS
- FLOODPLAIN CLEARING AREAS

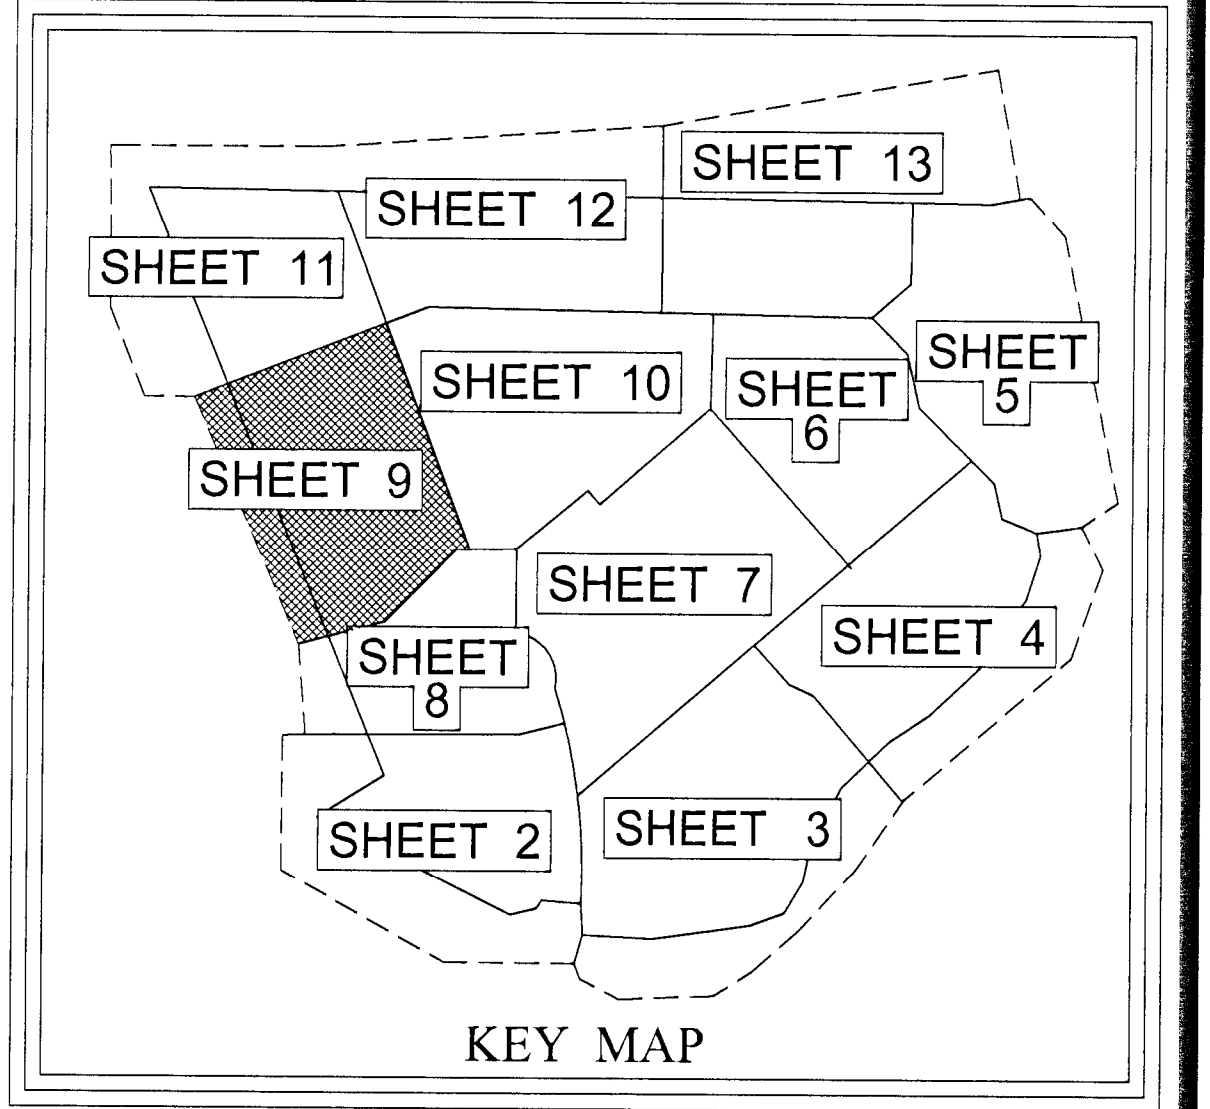

FOR OFFICIAL USE ONLY
OR label certifies that this plan meets conditions of final approval by the Planning Board, its designee or the District Council.
M-NCPPC APPROVAL
PROJECT NAME: STEEPLECHASE BUSINESS PARK, BUILDING IN PARCELS 1, 22, 24, 34-37, 39-41, 50, 53-61 & 63-66
PROJECT NUMBER: DSP-16023
For Conditions of Approval, see Site Plan Cover Sheet or Approval Sheet
Revision numbers must be included in the Project Number

M-NCPPC APPROVALS				M-NCPPC APPROVALS			
PROJECT NAME: STEEPLECHASE BUSINESS PARK				PROJECT NAME: STEEPLECHASE BUSINESS PARK			
PROJECT NUMBER: DSP-05044				PROJECT NUMBER: DSP-05044			
FOR CONDITIONS OF APPROVAL, SEE SITE PLAN COVER SHEET OR APPROVAL SHEET. REVISED LISTED BELOW APPLY TO THIS SHEET.				FOR CONDITIONS OF APPROVAL, SEE SITE PLAN COVER SHEET OR APPROVAL SHEET. REVISED LISTED BELOW APPLY TO THIS SHEET.			
APPROVAL OF REVISION /	APPROVAL DATE	REVISIONS INITIALS	CERTIFICATION DATE	APPROVAL OF REVISION /	APPROVAL DATE	REVISIONS INITIALS	CERTIFICATION DATE
01	7-23-07	SA	11-14-07	01	7-23-07	SA	11-14-07

M-NCPPC Prince George's County Planning Department Environmental Planning Section APPROVAL TREE CONSERVATION PLAN TCP II / 128 / 90			
REV. No.	APPROVED BY	DATE	ASSOCIATED CASE
01	JIM STASZ	8/07/90	
02	ROBERT E. METZGER	5/20/04	
03	ROBERT E. METZGER	9/22/04	
04	ROBERT E. METZGER	11/10/06	DSP-05044 PGCPB No. 05-240
05	KATINA SHOULARS	6/2/08	DSP-05044/03 PLANNING DIRECTOR
06	KATINA SHOULARS	2/4/10	
07	KATINA SHOULARS	11/15/06	DSP-05044/05
08	KATINA SHOULARS	12/27/13	STAFF LEVEL
09	MEGAN K. REISER	6/30/14	STAFF LEVEL
10	MEGAN K. REISER	11/13/14	STAFF LEVEL
		8/14/17	DSP-16023 PGCPB No. 16-139

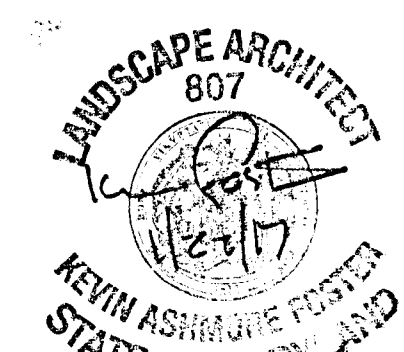

P/O PRESERVATION AREA "6"
0.82 Ac. (TOTAL)

REFORESTATION AREA "1"
0.46 Ac. (TOTAL)

P/O FLOODPLAIN AREA TO BE CLEARED
0.41 Ac. (TOTAL)

PARCEL 22

MATCHLINE SHEET 10
HAMPTON PARK BOULEVARD

MATCHLINE SHEET 11

MATCHLINE SHEET 8

GLWGUTSCHICK LITTLE & WEBER, P.A.
CIVIL ENGINEERS, LAND SURVEYORS, LAND PLANNERS, LANDSCAPE ARCHITECTS
3509 NATIONAL DRIVE - SUITE 220 - BURTONTOWN, MARYLAND 20866
TEL: 301-421-4024 FAX: 301-421-4196

OWNER/DEVELOPER
ATAPCO RITCHIE INTERCHANGE, INC.
10 EAST BALTIMORE AVE
SUITE 1600
BALTIMORE, MD 21202
CONTACT: KEVIN MCANDREWS
410-347-7185

LANHAM OFFICE
4266 Fort Belvoir Road
Lanham, MD 20706
TEL: 301.794.7555 F: 301.794.7556

NO.	REVISION	BY	DATE
6	REVISED TREE CONSERVATION AREA "6" FOR TIRE PLUS SEWER OUTFALL	CJV	10/20/11
5	REVISED TO MATCH PROPOSED FLOODPLAIN, REVISED SWM POND S, AND CUL-DE-SAC & PARKING LOT AT PARCEL 19	CWJ	10/13/05
3	CHANGES PER CLIENT REVISIONS	CWJ	5/25/05
2	REV. PER FINAL IMPROVEMENT	YOR	8/04/04
1	REV. PER MNCPPC REVIEW COMMENTS DATED 5/10/04	BAM	5/10/04

ADC MAP	
MAP 19	GRID H-6
TAX MAP 74	ZONING CATEGORY I-1
GRID C-3, D-3, E-3	
GRID C-4, D-4, E-4	
M-NCPPC 2007 SHEET	
202 SE 08	
WSSC 2007 SHEET	
202 SE 08	

TREE CONSERVATION PLAN TYPE II

MISS UTILITY NOTE
INFORMATION CONCERNING EXISTING UNDERGROUND UTILITIES WAS OBTAINED FROM AVAILABLE RECORDS. THE CONTRACTOR MUST DETERMINE THE EXACT LOCATION AND ELEVATION OF ALL EXISTING UTILITIES AND UTILITY CROSSINGS BY DIGGING TEST PITS BY HAND, WELL IN ADVANCE OF THE START OF EXCAVATION. CONTACT "MISS UTILITY" AT 1-800-367-7777, 48 HOURS PRIOR TO THE START OF EXCAVATION. IF CLEARANCES ARE LESS THAN SHOWN ON THIS PLAN OR TWELVE (12) INCHES, WHICHEVER IS LESS, CONTACT THE ENGINEER AND THE UTILITY COMPANY BEFORE PROCEEDING WITH CONSTRUCTION. CLEARANCES LESS THAN NOTED MAY REQUIRE REVISIONS TO THIS PLAN.

PARCELS 1, 22, 24, 34-37, 39-41, 50, 53-61 & 63-66
PARCEL "K", OUTLOT "A" AND OUTPARCEL "A"

STEEPLECHASE
BUSINESS PARK
13TH / HENT ELECTION DISTRICT
PRINCE GEORGE'S COUNTY, MARYLAND

1" = 30'
SHEET 9
OF 14
G. L. W. FILE No. 12026

MATCHLINE (SEE SHEET 12)

MATCHLINE (SEE SHEET 12)

MATCHLINE (SEE SHEET 13)

MATCHLINE (SEE SHEET 11)

MATCHLINE (SEE SHEET 6)

P/O REFORESTATION
AREA "J"
1.86 Ac. (TOTAL)

PARCEL 39


P/O TREE
PRESERVATION
AREA 7
0.39 Ac. (TOTAL)FLOODPLAIN
AREA TO BE
CLEARED
0.01 Ac.

PARCEL 55


P/O REFORESTATION
AREA "J"
1.86 Ac. (TOTAL)P/O REFORESTATION
AREA "H"
0.49 Ac. (TOTAL)P/O REFORESTATION
AREA "H"
0.49 Ac. (TOTAL)P/O FLOODPLAIN
AREA TO BE
CLEARED
0.01 Ac.P/O REFORESTATION
AREA "H"
0.49 Ac. (TOTAL)

PARCEL 54

MATCHLINE (SEE SHEET 7)

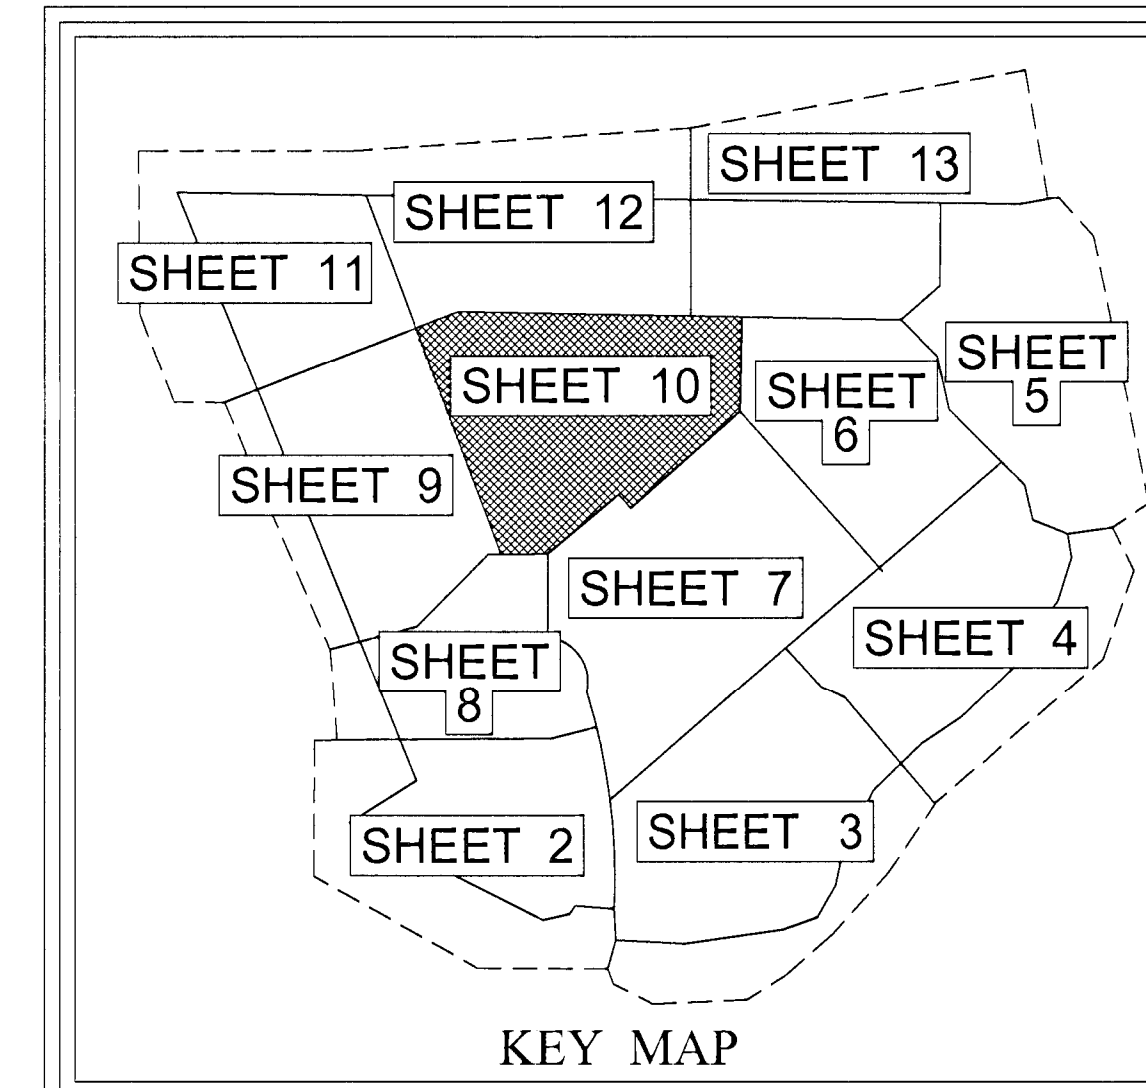FOR OFFICIAL USE ONLY
QR label certifies that this plan
meets conditions of final approval
by the Planning Board, its designee
or the District Council.
M-NCPPC
APPROVALPROJECT NAME: STEEPLECHASE 85 INTERNATIONAL
BUSINESS PARK, BUILDING H, PARCEL 57
PROJECT NUMBER: DSP-16023
For Direction of Approval see the Tree Conservation Approval Sheet
Revision numbers must be included in the Project Number

M-NCPPC APPROVALS				M-NCPPC APPROVALS			
PROJECT NAME: STEEPLECHASE BUSINESS PARK				PROJECT NAME: STEEPLECHASE BUSINESS PARK			
PROJECT NUMBER: DSOS-641				PROJECT NUMBER: DSP-05044			
FOR CONDITIONS OF APPROVAL SEE SITE PLAN COVER SHEET OR APPROVAL SHEET REVISED LISTED BELOW APPLY TO THIS SHEET				FOR CONDITIONS OF APPROVAL SEE SITE PLAN COVER SHEET OR APPROVAL SHEET REVISED LISTED BELOW APPLY TO THIS SHEET			
APPROVAL OF REVISION #	APPROVAL DATE	REVIEWER'S INITIALS	CERTIFICATION DATE	APPROVAL OF REVISION #	APPROVAL DATE	REVIEWER'S INITIALS	CERTIFICATION DATE
	7-23-07	SA	11-14-07	01	7-23-07	SA	11-14-07

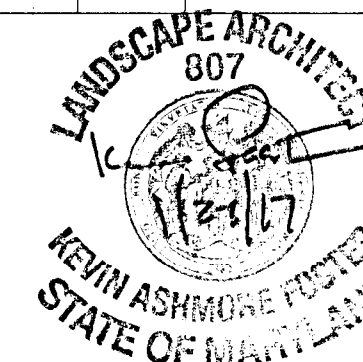

M-NCPPC Prince George's County Planning Department Environmental Planning Section APPROVAL TREE CONSERVATION PLAN TCPH / 128 / 90			
REV. No.	APPROVED BY	DATE	ASSOCIATED CASE
	JIM STASZ	8/07/90	
01	ROBERT E. METZGER	5/20/04	
02	ROBERT E. METZGER	9/22/04	
03	ROBERT E. METZGER	11/10/06	DSP-05044 PGCPB No. 05-240
04	KATINA SHOULARS	6/2/08	DSP-05044/03 PLANNING DIRECTOR
05	KATINA SHOULARS	2/4/10	
06	KATINA SHOULARS	11/15/06	DSP-05044/05
07	KATINA SHOULARS	12/27/13	STAFF LEVEL
08	MEGAN K. REISER	6/30/14	STAFF LEVEL
09	MEGAN K. REISER	11/13/14	STAFF LEVEL
10	Megan K. Reiser	2/14/17	DSP-16023 PGCPB No. 16-139

PARCELS 1, 22, 24, 34-37, 39-41, 50, 53-61 & 63-66
PARCEL "K", OUTLOT "A" AND OUTPARCEL "A"STEEPLECHASE
BUSINESS PARK13TH / HENT ELECTION DISTRICT
PRINCE GEORGE'S COUNTY, MARYLAND

1"=30'

SHEET 10
OF 14G. L. W. FILE No.
12026

LEGEND

---	LOO	ULTIMATE LIMITS OF DISTURBANCE
---	---	EXISTING TREE LINE
---	---	PROPOSED TREE LINE
---	PMA	PRIMARY MANAGEMENT AREA LINE (PMA)
---	---	EXISTING STREAM
---	SVB	STREAM BUFFER
---	---	NON-TIDAL WETLANDS
---	W	WETLANDS
---	WB	WETLANDS BUFFER
---	FP	100-YEAR FLOODPLAIN
---	---	15%-25% (K FACTOR GREATER THAN 0.35)
---	---	25% SLOPES
---	TPF	TREE PROTECTION DEVICE (UPHLL)
---	SF	SILT FENCE (DOWNHILL TREE PROTECTION DEVICE)
---	SSF	SUPER SILT FENCE
---	---	POST RAIL FENCE
---	---	EARTH DIKE (DOWNHILL TREE PROTECTION DEVICE)
---	---	TREE PRESERVATION AREA SIGN
---	---	SPECIMEN TREE
---	---	EX. NON-SPECIMEN TREE
---	---	TREE PRESERVATION AREAS
---	---	REFORESTATION AREAS
---	---	FLOODPLAIN CLEARING AREAS

GLWGUTSCHICK LITTLE & WEBER, P.A.

CIVIL ENGINEERS, LAND SURVEYORS, LAND PLANNERS, LANDSCAPE ARCHITECTS
3909 NATIONAL DRIVE - SUITE 200 - BURTONTOWN, MARYLAND 20866
TEL: 301-421-4024 FAX: 410-880-1820 DC/VA: 301-989-2524 FAX: 301-421-4186

OWNER/DEVELOPER

ATAPCO PROPERTIES, INC.
10 EAST BALTIMORE AVE
SUITE 1501
BALTIMORE, MD 21202
CONTACT: KRISTINA MAKEK
410-347-7163LANHAM OFFICE
4266 Forbes Boulevard
Lanham, MD 20706
P. 301.794.7555 F. 301.794.7556Engineering
Planning
Surveying
Environmental Services

www.LSAssociates.com

10	REV. PAR. 57 PER DSP, REV. PAR. 65 PER DSP, UPDATED PARCEL NUMBERS & REV. FLOODPLAIN DELINEATION ON PARCEL 57	KAB	07/15/17
9	REVISED TREE CONSERVATION EASEMENT	RLG	2/26/14
8	REVISED TREE CONSERVATION EASEMENT	RLG	12/17/13
7	REVISED PER BUILDING A-4 SITE PLAN, REFORESTATION AREAS B, C, H & J CHANGED	YOR	4/01/08
6	REVISED TO MATCH PROPOSED FLOODPLAIN, REVISED SWM POND 5, AND	CWJ	10/13/05
5	CUL-DE-SAC & PARKING LOT AT PARCEL 19		
4	CHANGES PER CLIENT REVISIONS	CWJ	5/25/05
3	REV. PER FINAL IMPROVEMENT	YOR	8/04/04
2	REV. PER MNCPPC REVIEW COMMENTS DATED 5/10/04	BAM	5/10/04
1	NO. DATE: JULY 2013	BY	DATE
NO.	DATE: JULY 2013	BY	DATE
REV. XXX	REV. XXX	REV. XXX	REV. XXX

MATCHLINE (SEE SHEET 8)

MAP	ADC MAP	GRID	H-6
TAX MAP 74			
GRID C-3, D-3, E-3			
GRID C-4, D-4, E-4			
M-NOPPC 200 SHEET			
202 SE 08			
WSSC 200 SHEET			
202 SE 08			

TREE CONSERVATION PLAN
TYPE II

MISS UTILITY NOTE

INFORMATION CONCERNING EXISTING UNDERGROUND UTILITIES WAS
OBTAINED FROM AVAILABLE RECORDS. THE CONTRACTOR MUST
DETERMINE THE EXACT LOCATION AND ELEVATION OF ALL EXISTING
UTILITIES AND UTILITY CROSSINGS BY DIGGING TEST PITS BY HAND,
WELL IN ADVANCE OF THE START OF EXCAVATION. CONTACT "MISS
UTILITY" AT 1-800-257-7777, 48 HOURS PRIOR TO THE START OF
EXCAVATION. IF CLEARANCES ARE LESS THAN SHOWN ON THIS PLAN
OR TWELVE (12) INCHES, WHICHEVER IS LESS, CONTACT THE
ENGINEER AND THE UTILITY COMPANY BEFORE PROCEEDING WITH
CONSTRUCTION. CLEARANCES LESS THAN NOTED MAY REQUIRE
REVISIONS TO THIS PLAN.NOTE:
THIS TCP II/128/90-01 IS FOR ROUGH GRADING ONLY.
THE REFORESTATION AREAS ARE NOT CONSIDERED
APPROVED ON THIS PLAN AND MUST BE SHOWN ON A
REVISED TCP-II WITH BUILDING LOCATIONS AND GRADING
PRIOR TO ISSUANCE OF THE FIRST BUILDING PERMIT.


NOTE: TCPH REVISION #08 APPLIES TO SHEETS 1, 7, 8, 10, & 14A ONLY.



LEGEND	
	ULTIMATE LIMITS OF DISTURBANCE
	EXISTING TREE LINE
	PROPOSED TREE LINE
	PRIMARY MANAGEMENT AREA LINE (PMA)
	EXISTING STREAM
	STREAM BUFFER
	NON-TIDAL WETLANDS
	WETLANDS BUFFER
	15%-25% (K FACTOR GREATER THAN 0.35)
	25% SLOPES
	TREE PROTECTION DEVICE (UPHILL)
	SILT FENCE (DOWNHILL TREE PROTECTION DEVICE)
	SUPER SILT FENCE
	POST RAIL FENCE
	EARTH DIKE (DOWNHILL TREE PROTECTION DEVICE)
	TREE PRESERVATION AREA SIGN
	SPECIMEN TREE
	EX. NON-SPECIMEN TREE
	TREE PRESERVATION AREAS
	TREE PRESERVATION AREAS NON-CREDIT
	REFORESTATION AREAS
	FLOODPLAIN CLEARING AREAS

NOTE:
THIS TCP II/128/90-01 IS FOR ROUGH GRADING ONLY. THE REFORESTATION AREAS ARE NOT CONSIDERED APPROVED ON THIS PLAN AND MUST BE SHOWN ON A REVISED TCP-II WITH BUILDING LOCATIONS AND GRADING PRIOR TO ISSUANCE OF THE FIRST BUILDING PERMIT.

NOTE:
THIS TCP II/128/90-01 IS FOR FINAL IMPROVEMENT

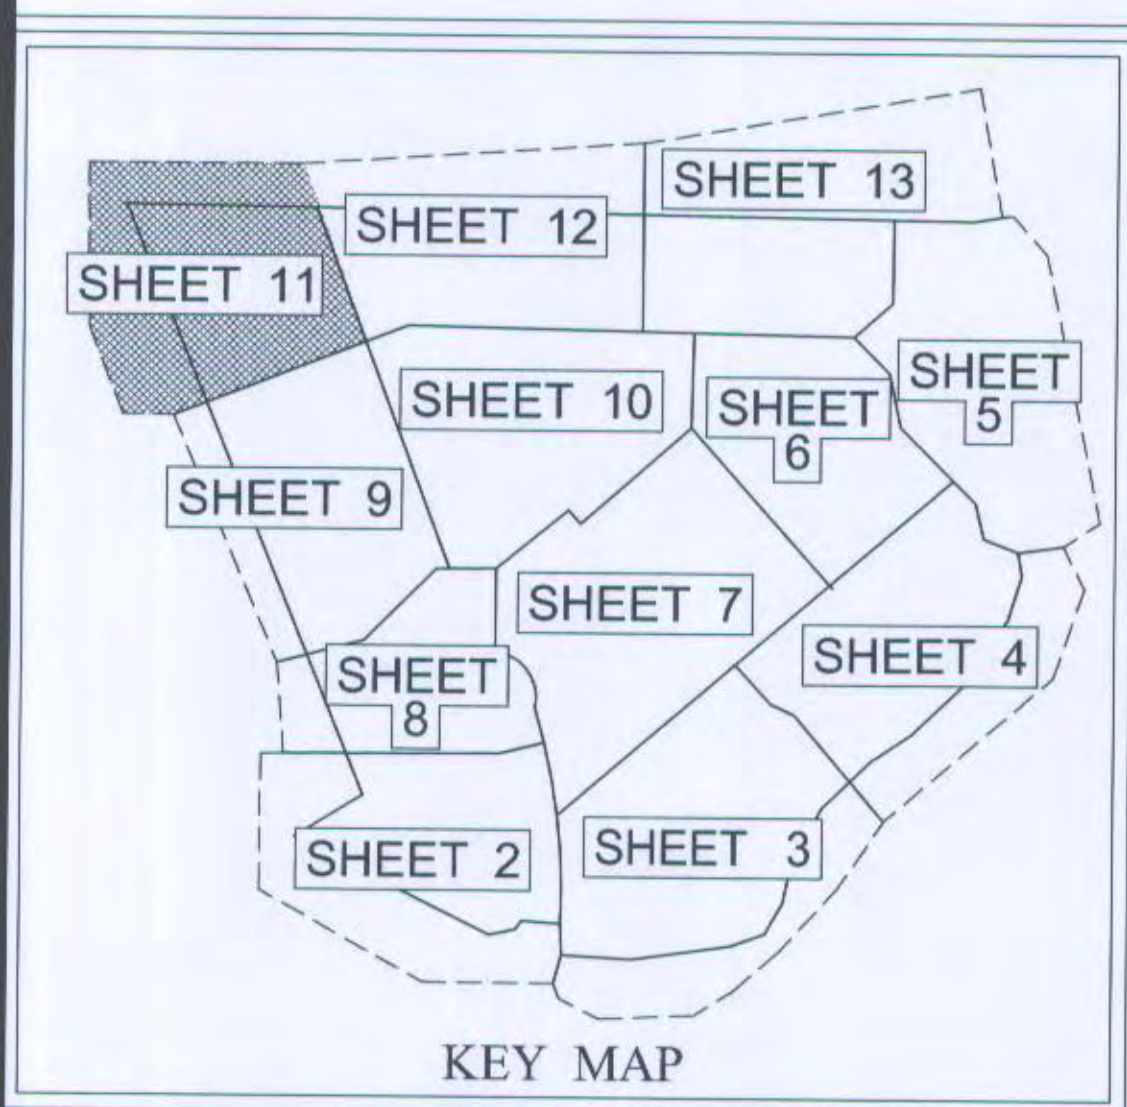

GLWGUTSCHICK LITTLE & WEBER, P.A.
CIVIL ENGINEERS, LAND SURVEYORS, LAND PLANNERS, LANDSCAPE ARCHITECTS
3909 NATIONAL DRIVE - SUITE 250 - BURTONTOWN, MARYLAND 20866
TEL: 301-421-4024 FAX: 301-421-4186

OWNER/DEVELOPER
ATAPCO RITCHIE INTERCHANGE, INC.
10 EAST BALTIMORE AVE
SUITE 1600
BALTIMORE, MD 21202
CONTACT: KEVIN MCANDREWS
410-347-7185

LANHAM OFFICE
4266 FORBES BOULEVARD
LANHAM, MD 20706
TEL: 301.794.7555 FAX: 301.794.7556

Rockville
Frederick
Waldorf
Leonardtown
Fairfax

www.LSAssociates.net

NO.	REVISION	DATE	BY
1	REV. PER MNCPPC REVIEW COMMENTS DATED 5/10/04	5/11/04	YOR
2	REV. PER FINAL IMPROVEMENT	8/4/04	YOR
3	ADDED OFF-SITE CREDITS	9/10/04	YOR
5	REVISED TO MATCH PROPOSED FLOODPLAIN, REVISED SWM POND 5, AND CUL-DE-SAC	7/18/14	RLG
11	REVISED BUILDING D	7/18/14	RLG

MAP	GRID	ZONING CATEGORY
MAP 19	GRID C-3, D-3, E-3	I-1
TAX MAP 74	GRID C-4, D-4, E-4	
M-NCPPC 200' SHEET	202 SE 08	
WSSC 200' SHEET	202 SE 08	

TREE CONSERVATION PLAN TYPE II

MISS UTILITY NOTE
INFORMATION CONCERNING EXISTING UNDERGROUND UTILITIES WAS OBTAINED FROM AVAILABLE RECORDS. THE CONTRACTOR MUST DETERMINE THE EXACT LOCATION AND ELEVATION OF ALL EXISTING UTILITIES AND UTILITY CROSSINGS BY DIGGING TEST PITS BY HAND WELL IN ADVANCE OF THE START OF EXCAVATION. CONTACT "MISS UTILITY" AT 1-800-287-7777, 48 HOURS PRIOR TO THE START OF EXCAVATION. IF CLEARANCES ARE LESS THAN SHOWN ON THIS PLAN OR TWELVE (12) INCHES, WHICHEVER IS LESS, CONTACT THE ENGINEER AND THE UTILITY COMPANY BEFORE PROCEEDING WITH CONSTRUCTION. CLEARANCES LESS THAN NOTED MAY REQUIRE REVISIONS TO THIS PLAN.

PARCELS 1, 22, 24, 34-37, 39-41, 50, 53-61 & 63-66
PARCEL 'K', OUTLOT 'A' AND OUTPARCEL 'A'

STEEPLECHASE BUSINESS PARK


13TH / HENT ELECTION DISTRICT
PRINCE GEORGE'S COUNTY, MARYLAND

SHEET	11
OF	14
G. L. W. FILE NO.	12026

M-NCPPC APPROVALS				M-NCPPC APPROVALS			
PROJECT NAME: STEEPLCHASE BUSINESS PARK				PROJECT NAME: STEEPLCHASE BUSINESS PARK			
PROJECT NUMBER: DSP-05044				PROJECT NUMBER: DSP-05044			
FOR CONDITIONS OF APPROVAL, SEE SITE PLAN COVER SHEET OR APPROVAL SHEET				FOR CONDITIONS OF APPROVAL, SEE SITE PLAN COVER SHEET OR APPROVAL SHEET			
APPROVAL OR REVISION #	APPROVAL DATE	REVIEWER INITIALS	CERTIFICATION DATE	APPROVAL OR REVISION #	APPROVAL DATE	REVIEWER INITIALS	CERTIFICATION DATE
01	7-23-07	SA	11-14-07				

M-NCPPC Princo George's County Planning Department Environmental Planning Section APPROVAL TREE CONSERVATION PLAN TCP II / 128 / 90			
REV. No.	APPROVED BY	DATE	ASSOCIATED CASE
01	ROBERT E. METZGER	5/20/04	
02	ROBERT E. METZGER	9/22/04	
03	ROBERT E. METZGER	11/10/06	DSP-05044 PGCPB No. 05-240
04	KATINA SHOULARS	6/2/08	DSP-05044/03 PLANNING DIRECTOR
05	KATINA SHOULARS	2/4/10	
06	KATINA SHOULARS	11/15/06	DSP-05044/05
07	KATINA SHOULARS	12/27/13	STAFF LEVEL
08	MEGAN K. REISER	6/30/14	STAFF LEVEL
09	MEGAN K. REISER	11/13/14	STAFF LEVEL
10	MEGAN K. REISER	2/4/17	DSP-16023 PGCPB No. 16-139



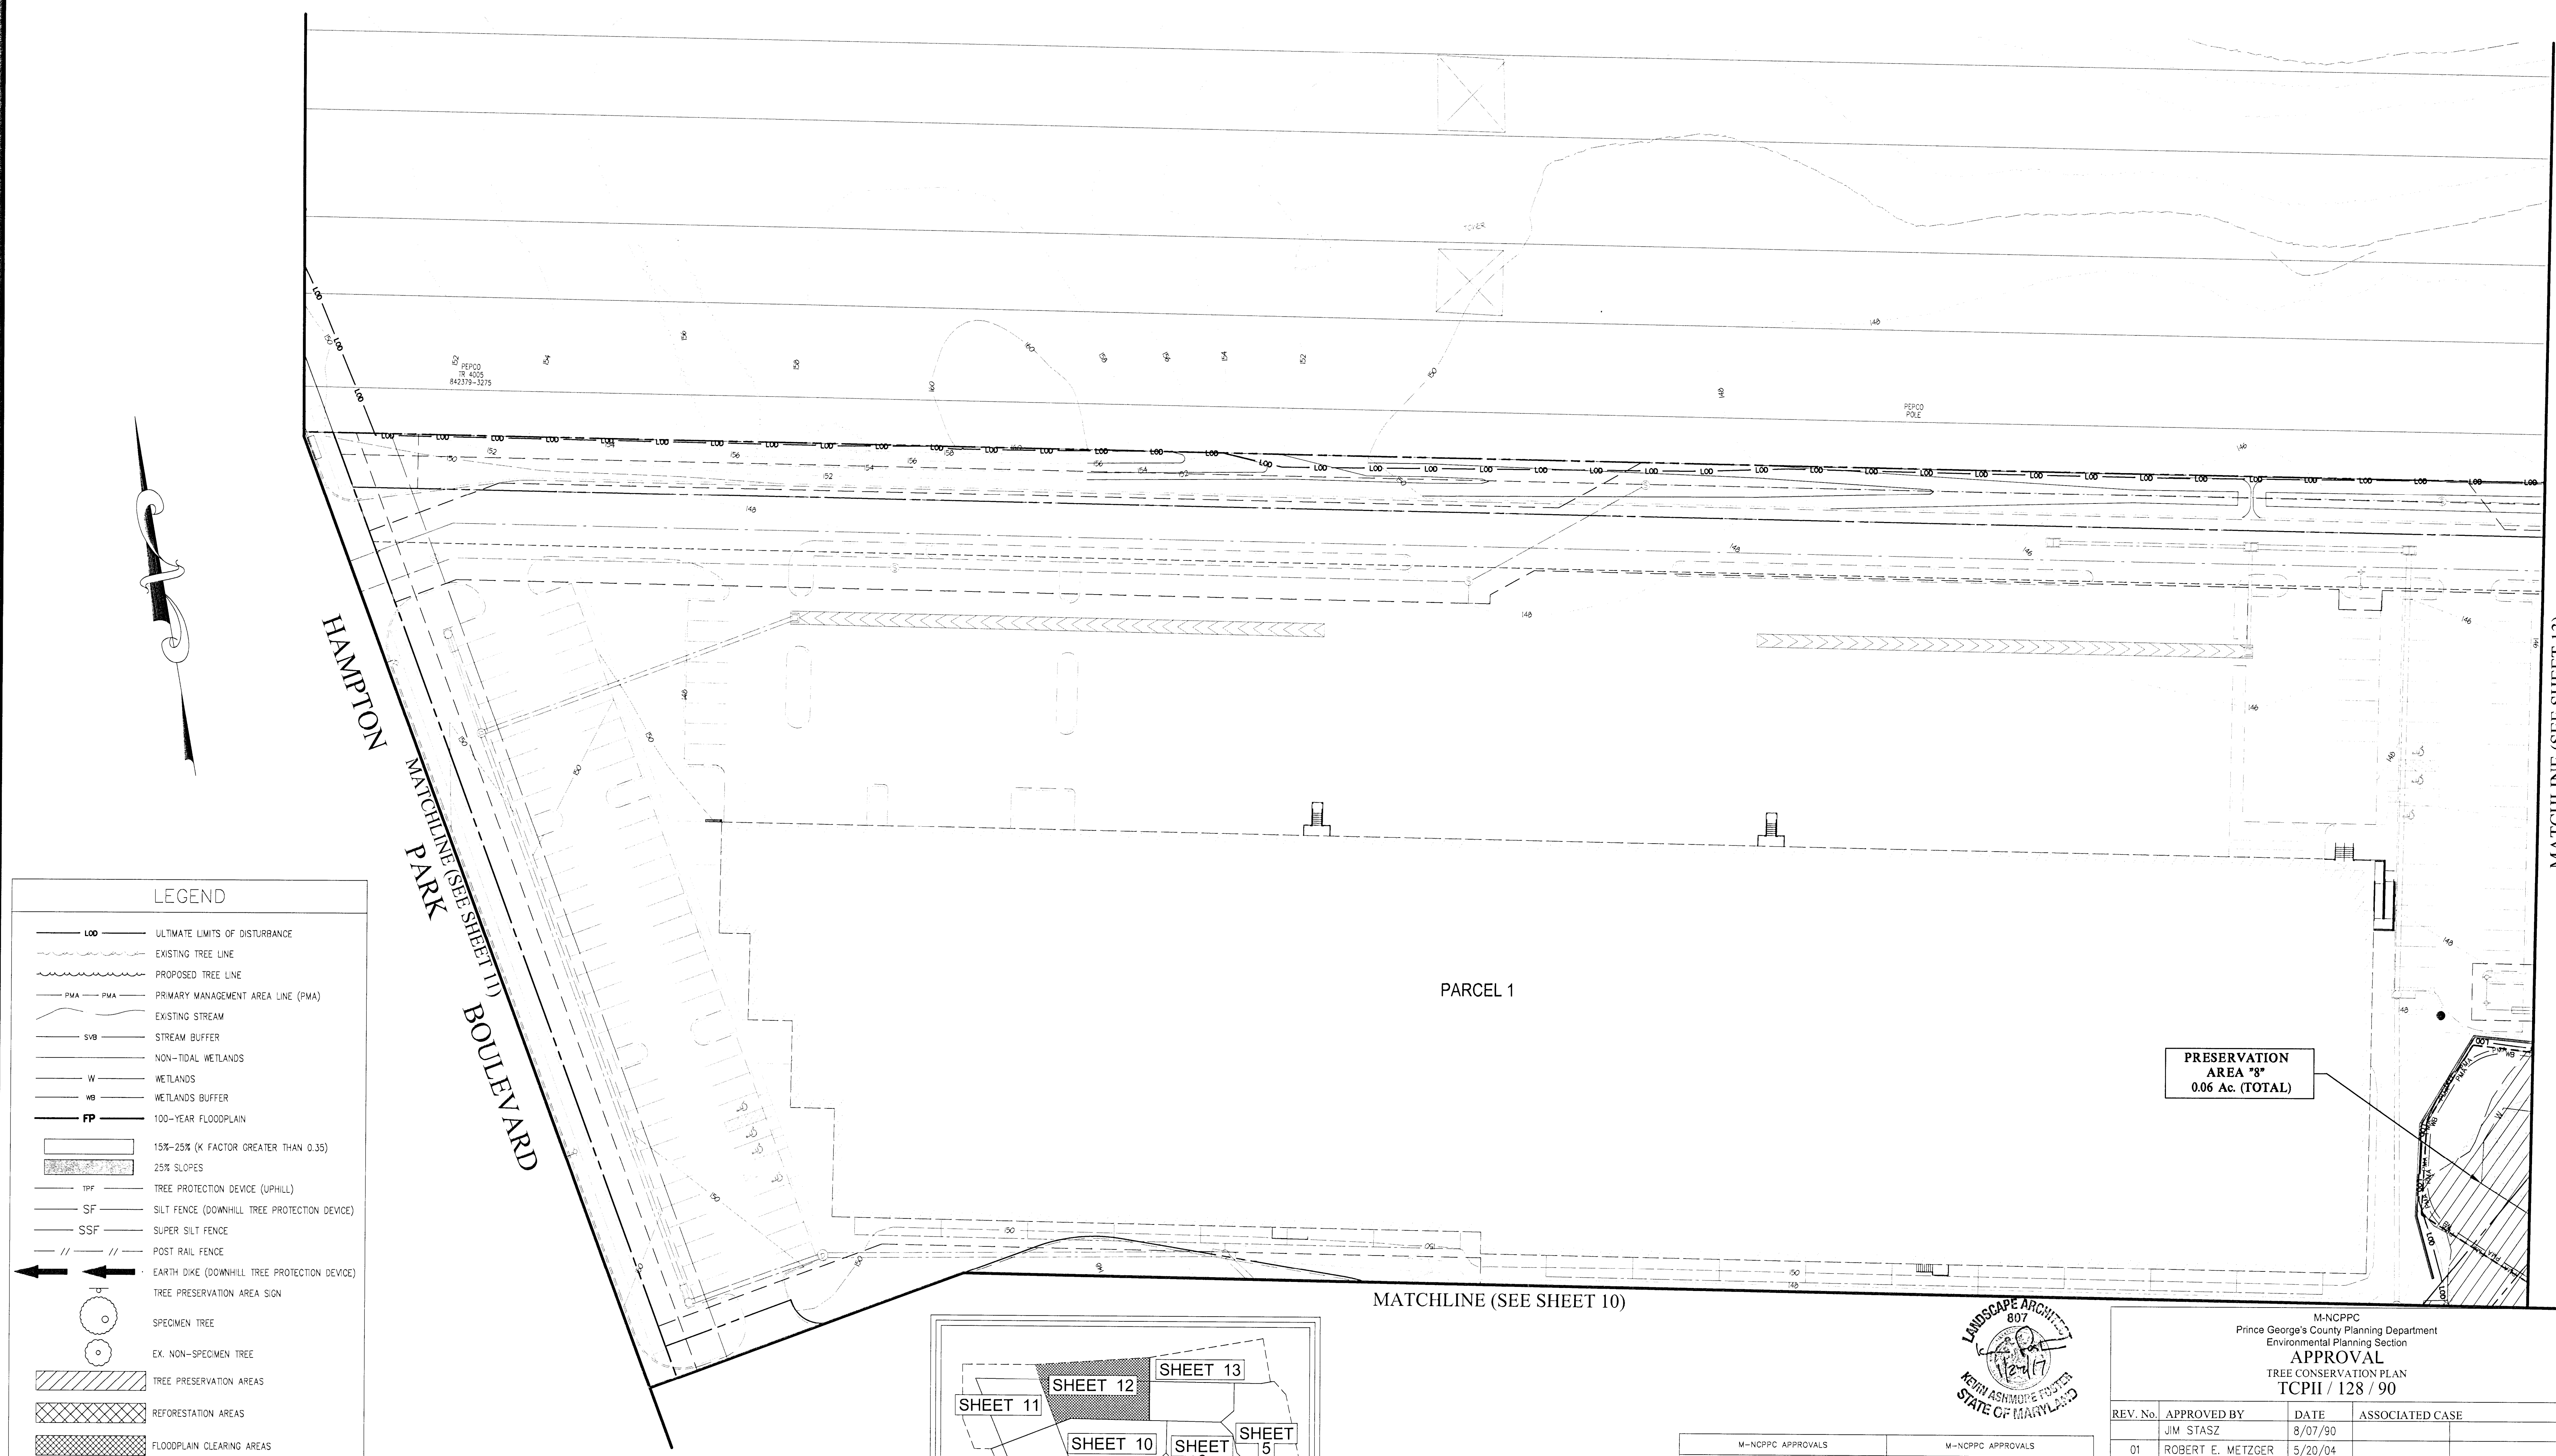

LEGEND


- LOO — ULTIMATE LIMITS OF DISTURBANCE
- — — — — EXISTING TREE LINE
- - - - - PROPOSED TREE LINE
- PMA — PMA — PRIMARY MANAGEMENT AREA LINE (PMA)
- — — — — EXISTING STREAM
- SVB — STREAM BUFFER
- — — — — NON-TIDAL WETLANDS
- W — WETLANDS
- WB — WETLANDS BUFFER
- FP — 100-YEAR FLOODPLAIN
- 15%-25% (K FACTOR GREATER THAN 0.35)
- 25% SLOPES
- TPF — TREE PROTECTION DEVICE (UPHILL)
- SF — SILT FENCE (DOWNHILL TREE PROTECTION DEVICE)
- SSF — SUPER SILT FENCE
- — — — — POST RAIL FENCE
- — — — — EARTH DIKE (DOWNHILL TREE PROTECTION DEVICE)
- — — — — TREE PRESERVATION AREA SIGN
- — — — — SPECIMEN TREE
- — — — — EX. NON-SPECIMEN TREE
- — — — — TREE PRESERVATION AREAS
- — — — — REFORESTATION AREAS
- — — — — FLOODPLAIN CLEARING AREAS

GLWGUTSCHICK LITTLE & WEBER, P.A.
CIVIL ENGINEERS, LAND SURVEYORS, LAND PLANNERS, LANDSCAPE ARCHITECTS
3909 NATIONAL DRIVE - SUITE 150 - BURTNSVILLE OFFICE PARK
BURTNSVILLE, MARYLAND 20866
TEL: 301-421-4024 FAX: 410-860-1820 DC/VA: 301-989-2524 FAX: 301-421-4198

OWNER/DEVELOPER
ATAPCO PROPERTIES, INC.
10 EAST BALTIMORE AVE
SUITE 1501
BALTIMORE, MD 21202
CONTACT: KRISTINA MACEK
410-347-7183

NOTE:
THIS TCP II/128/90-01 IS FOR ROUGH GRADING ONLY. THE REFORESTATION AREAS ARE NOT CONSIDERED APPROVED ON THIS PLAN AND MUST BE SHOWN ON A REVISED TCP-II WITH BUILDING LOCATIONS AND GRADING PRIOR TO ISSUANCE OF THE FIRST BUILDING PERMIT.

NOTE: TCP II REVISION #08 APPLIES TO SHEETS 1, 7, 8, 10, & 14A ONLY.

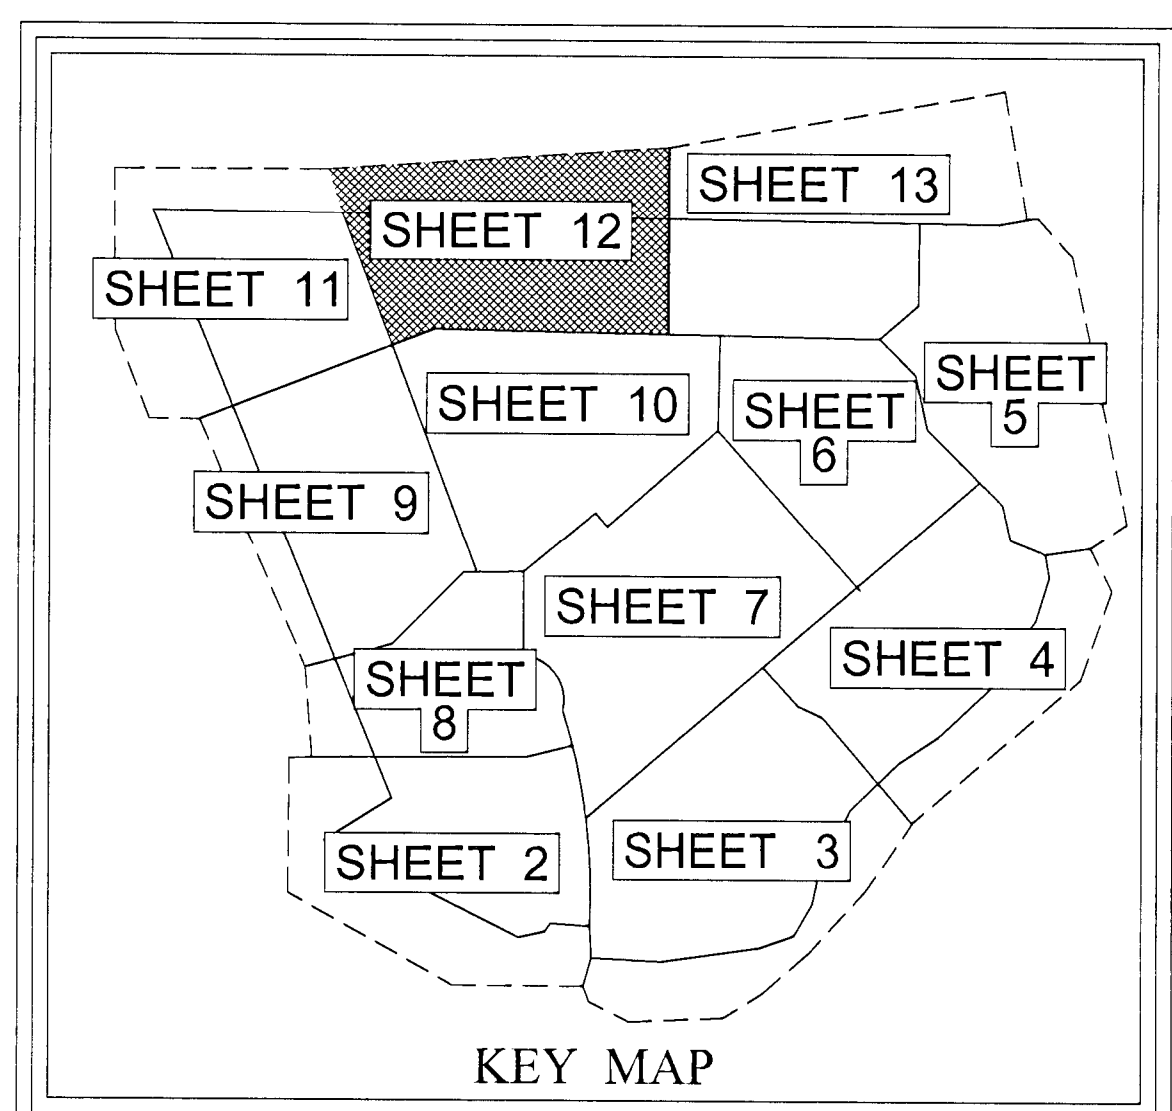

FOR OFFICIAL USE ONLY
This label certifies that this plan meets conditions of final approval by the Planning Board, its designee or the District Council.

M-NCPPC APPROVAL
PROJECT NAME: STEEPLCHASE BUSINESS PARK
PROJECT NUMBER: DSP-16023
For Conditions of Approval See Site Plan Cover Sheet or Approved Sheet
Revision Numbers must be included in the Project Number

M-NCPPC APPROVALS				M-NCPPC APPROVALS			
PROJECT NAME: STEEPLCHASE BUSINESS PARK				PROJECT NAME: STEEPLCHASE BUSINESS PARK			
PROJECT NUMBER: DSP-541				PROJECT NUMBER: DSP-05044			
FOR CONDITIONS OF APPROVAL SEE SITE PLAN COVER SHEET OR APPROVAL SHEET REVISED LISTED BELOW APPLY TO THIS SHEET				FOR CONDITIONS OF APPROVAL SEE SITE PLAN COVER SHEET OR APPROVAL SHEET REVISED LISTED BELOW APPLY TO THIS SHEET			
APPROVAL OR REVISION #	APPROVAL DATE	REVIEWER'S INITIALS	CERTIFICATION DATE	APPROVAL OR REVISION #	APPROVAL DATE	REVIEWER'S INITIALS	CERTIFICATION DATE
	7-23-07	SA	11-14-07	01	7-23-07	SA	11-14-07

M-NCPPC Prince George's County Planning Department Environmental Planning Section APPROVAL TREE CONSERVATION PLAN TCP II / 128 / 90			
REV. No.	APPROVED BY	DATE	ASSOCIATED CASE
01	JIM STASZ	8/07/90	
02	ROBERT E. METZGER	5/20/04	
03	ROBERT E. METZGER	9/22/04	
04	ROBERT E. METZGER	11/10/06	DSP-05044 PCCPB No. 05-240
05	KATINA SHOULARS	6/2/08	DSP-05044/03 PLANNING DIRECTOR
06	KATINA SHOULARS	2/4/10	
07	KATINA SHOULARS	11/15/06	DSP-05044/05
08	KATINA SHOULARS	12/27/13	STAFF LEVEL
09	MEGAN K. REISER	6/30/14	STAFF LEVEL
10	MEGAN K. REISER	11/13/14	STAFF LEVEL
	Megan K. Reiser	8/14/17	DSP-16023 PCCPB No. 16-139



PARCELS 1, 22, 24, 34-37, 39-41, 50, 53-61 & 63-66
PARCEL 'K', OUTLOT 'A' AND OUTPARCEL 'A'

STEEPLECHASE BUSINESS PARK
13TH / HENT ELECTION DISTRICT
PRINCE GEORGE'S COUNTY, MARYLAND

SHEET 12 OF 14	
G. L. W. FILE No. 12026	


LANDAM OFFICE
4266 Forbes Boulevard
Lanham, MD 20706
P: 301.794.7555 F: 301.794.1656

REVISIONS			
NO.	DATE	REVISION	BY
5	10/13/05	REVISED TO MATCH PROPOSED FLOODPLAIN, REVISED SWM POND S, AND CUL-DE-SAC & PARKING LOT AT PARCEL 19	CWJ
3	5/25/05	CHANGES PER CLIENT REVISIONS	CWJ
2	8/04/04	REV. PER FINAL IMPROVEMENT	YOR
1	5/10/04	REV. PER MNCPPC REVIEW COMMENTS DATED 5/10/04	BAM

ADC MAP	
MAP 19	GRID H-6
TAX MAP 74	ZONING CATEGORY I-1
GRID C-3, D-3, E-3	
GRID C-4, D-4, E-4	
M-NCPPC 200' SHEET	
202 SE 08	
WSSC 200' SHEET	
202 SE 08	


TREE CONSERVATION PLAN TYPE II

MISS UTILITY NOTE
INFORMATION CONCERNING EXISTING UNDERGROUND UTILITIES WAS OBTAINED FROM AVAILABLE RECORDS. THE CONTRACTOR MUST DETERMINE THE EXACT LOCATION AND ELEVATION OF ALL EXISTING UTILITIES AND UTILITY CROSSINGS BY DIGGING TEST PITS BY HAND, WELL IN ADVANCE OF THE START OF EXCAVATION. CONTACT "MISS UTILITY" AT 1-800-287-7777, 48 HOURS PRIOR TO THE START OF EXCAVATION. IF CLEARANCES ARE LESS THAN SHOWN ON THIS PLAN OR TWELVE (12) INCHES, WHICHEVER IS LESS, CONTACT THE ENGINEER AND THE UTILITY COMPANY BEFORE PROCEEDING WITH CONSTRUCTION. CLEARANCES LESS THAN NOTED MAY REQUIRE REVISIONS TO THIS PLAN.

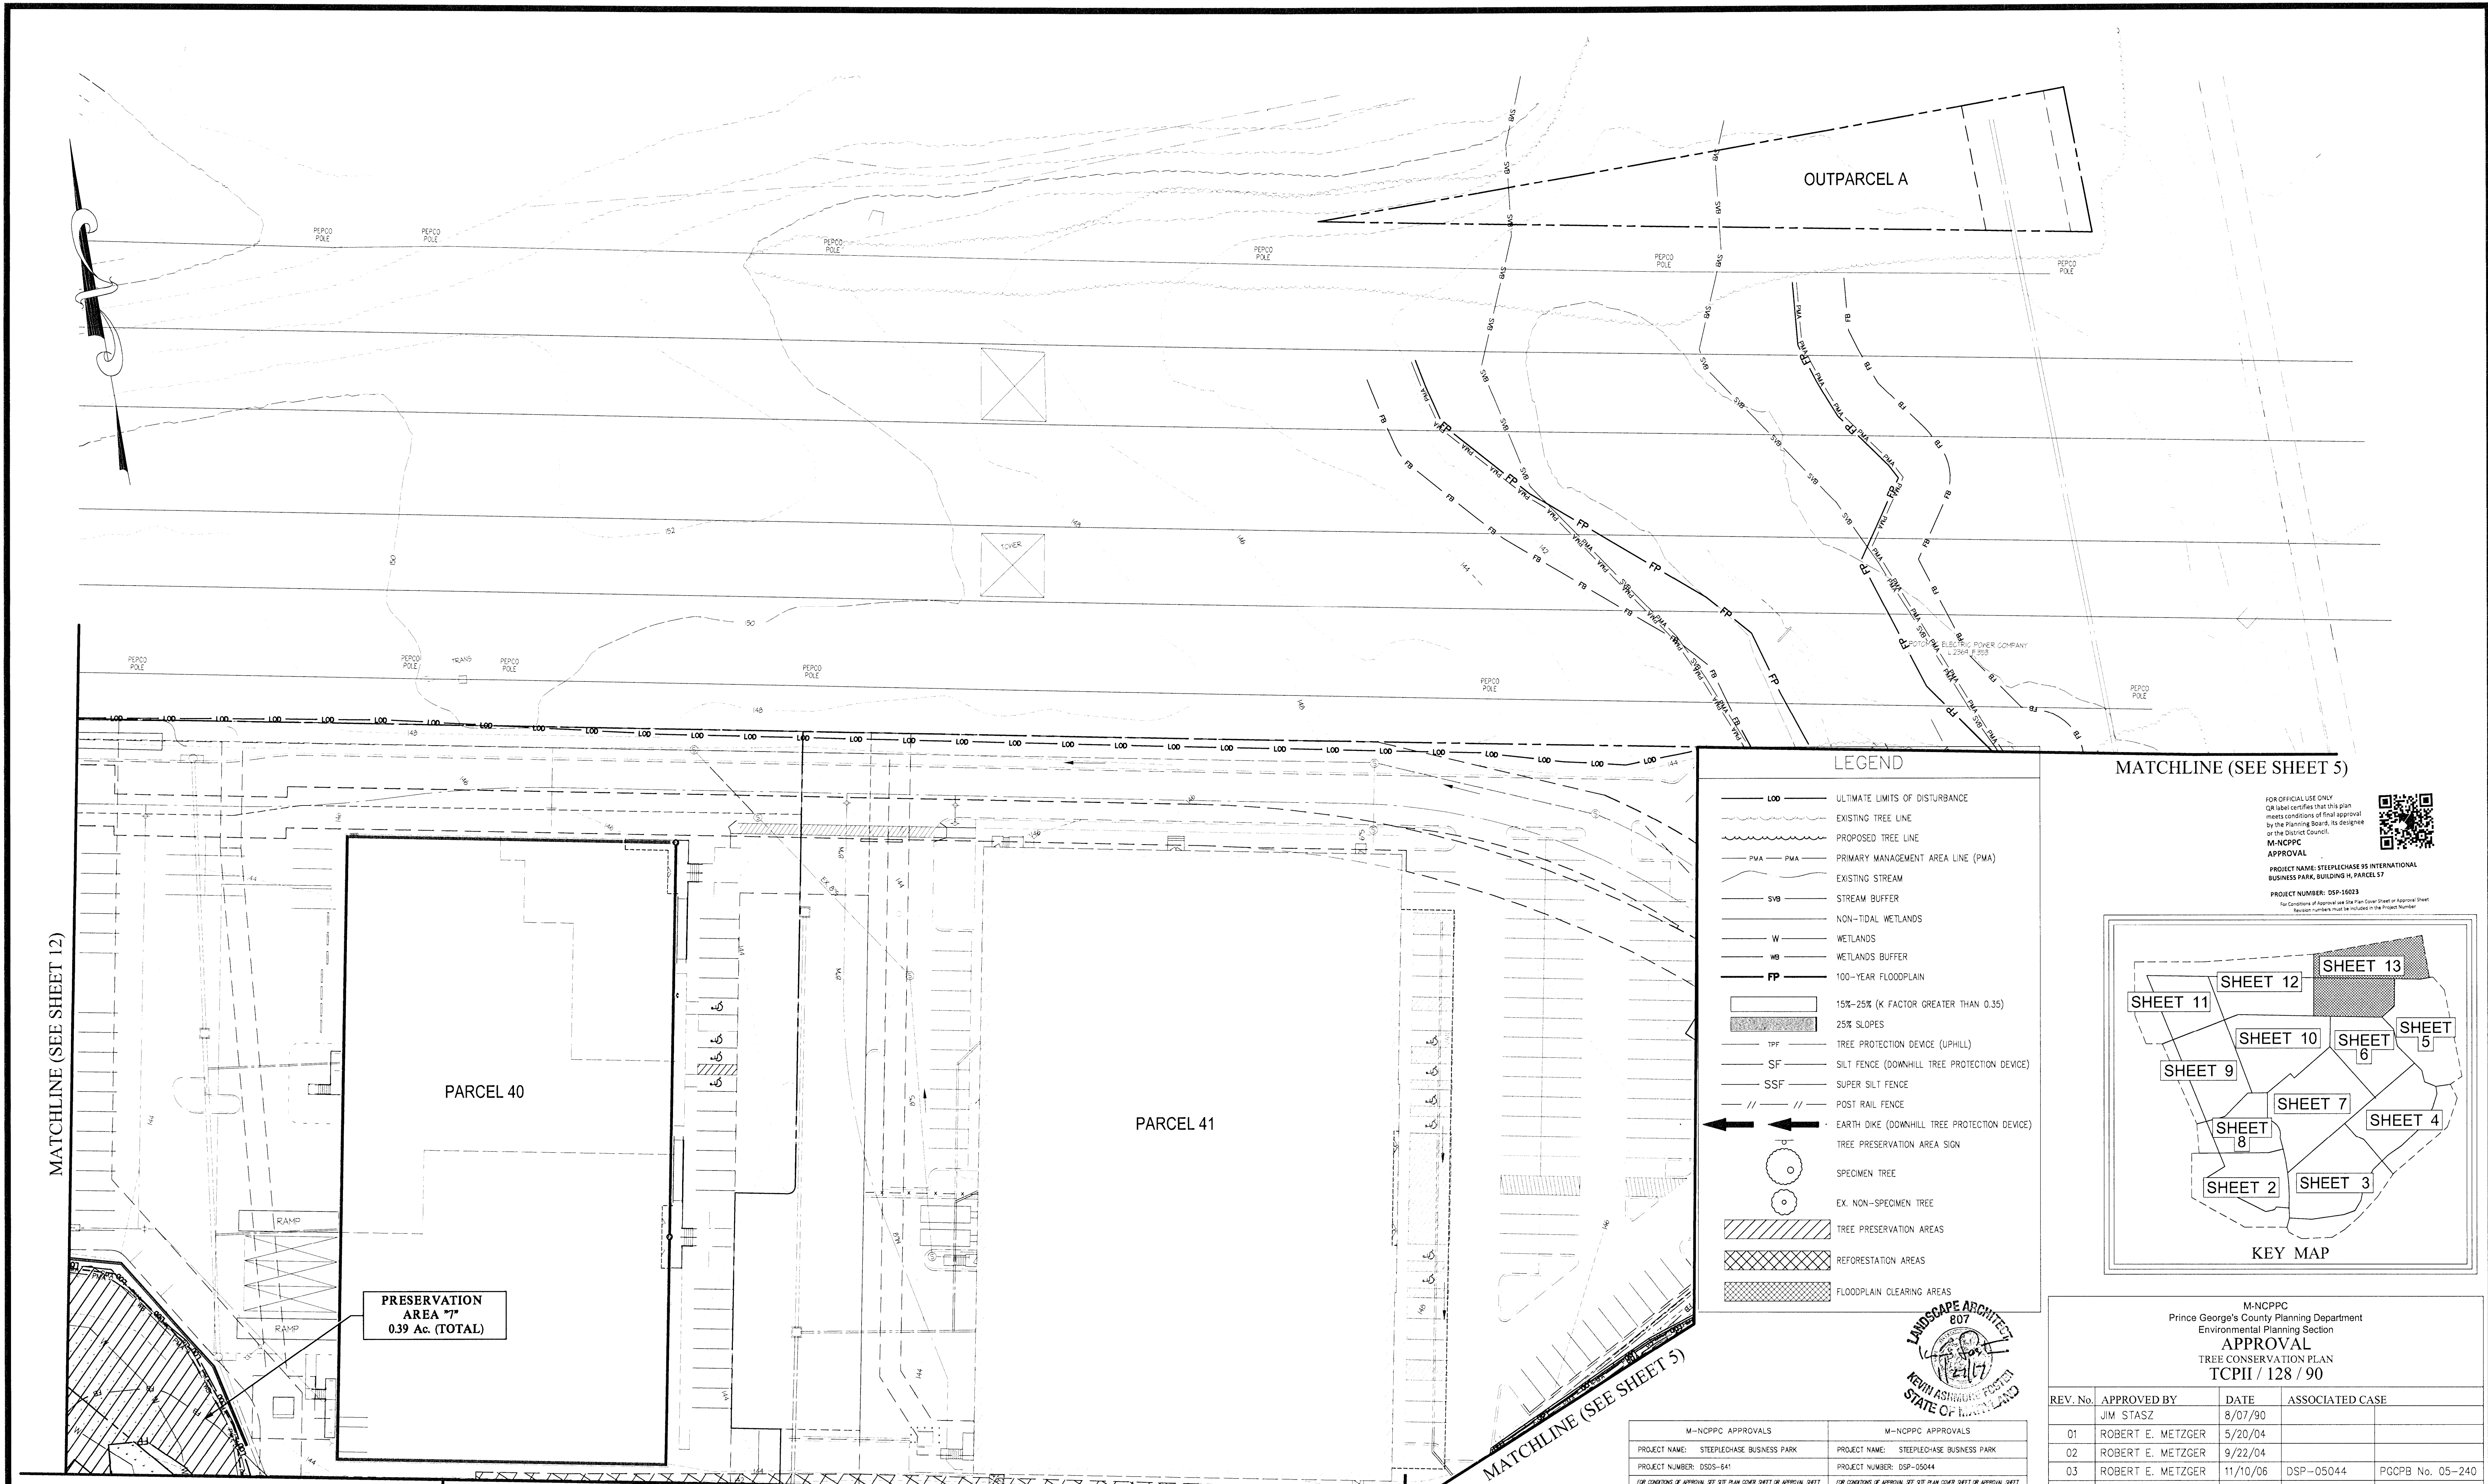

LEGEND

- LOO ——— ULTIMATE LIMITS OF DISTURBANCE
- EXISTING TREE LINE
- - - - - PROPOSED TREE LINE
- PMA — PMA — PRIMARY MANAGEMENT AREA LINE (PMA)
- EXISTING STREAM
- SVB ——— STREAM BUFFER
- W ——— NON-TIDAL WETLANDS
- WB ——— WETLANDS BUFFER
- FP ——— 100-YEAR FLOODPLAIN
- 15%-25% (K FACTOR GREATER THAN 0.35)
- 25% SLOPES
- TPF ——— TREE PROTECTION DEVICE (UPHILL)
- SF ——— SILT FENCE (DOWNHILL TREE PROTECTION DEVICE)
- SSF ——— SUPER SILT FENCE
- // —— POST RAIL FENCE
- EARTH DIKE (DOWNHILL TREE PROTECTION DEVICE)
- ——— TREE PRESERVATION AREA SIGN
- ——— SPECIMEN TREE
- ——— EX. NON-SPECIMEN TREE
- TREE PRESERVATION AREAS
- REFORESTATION AREAS
- FLOODPLAIN CLEARING AREAS

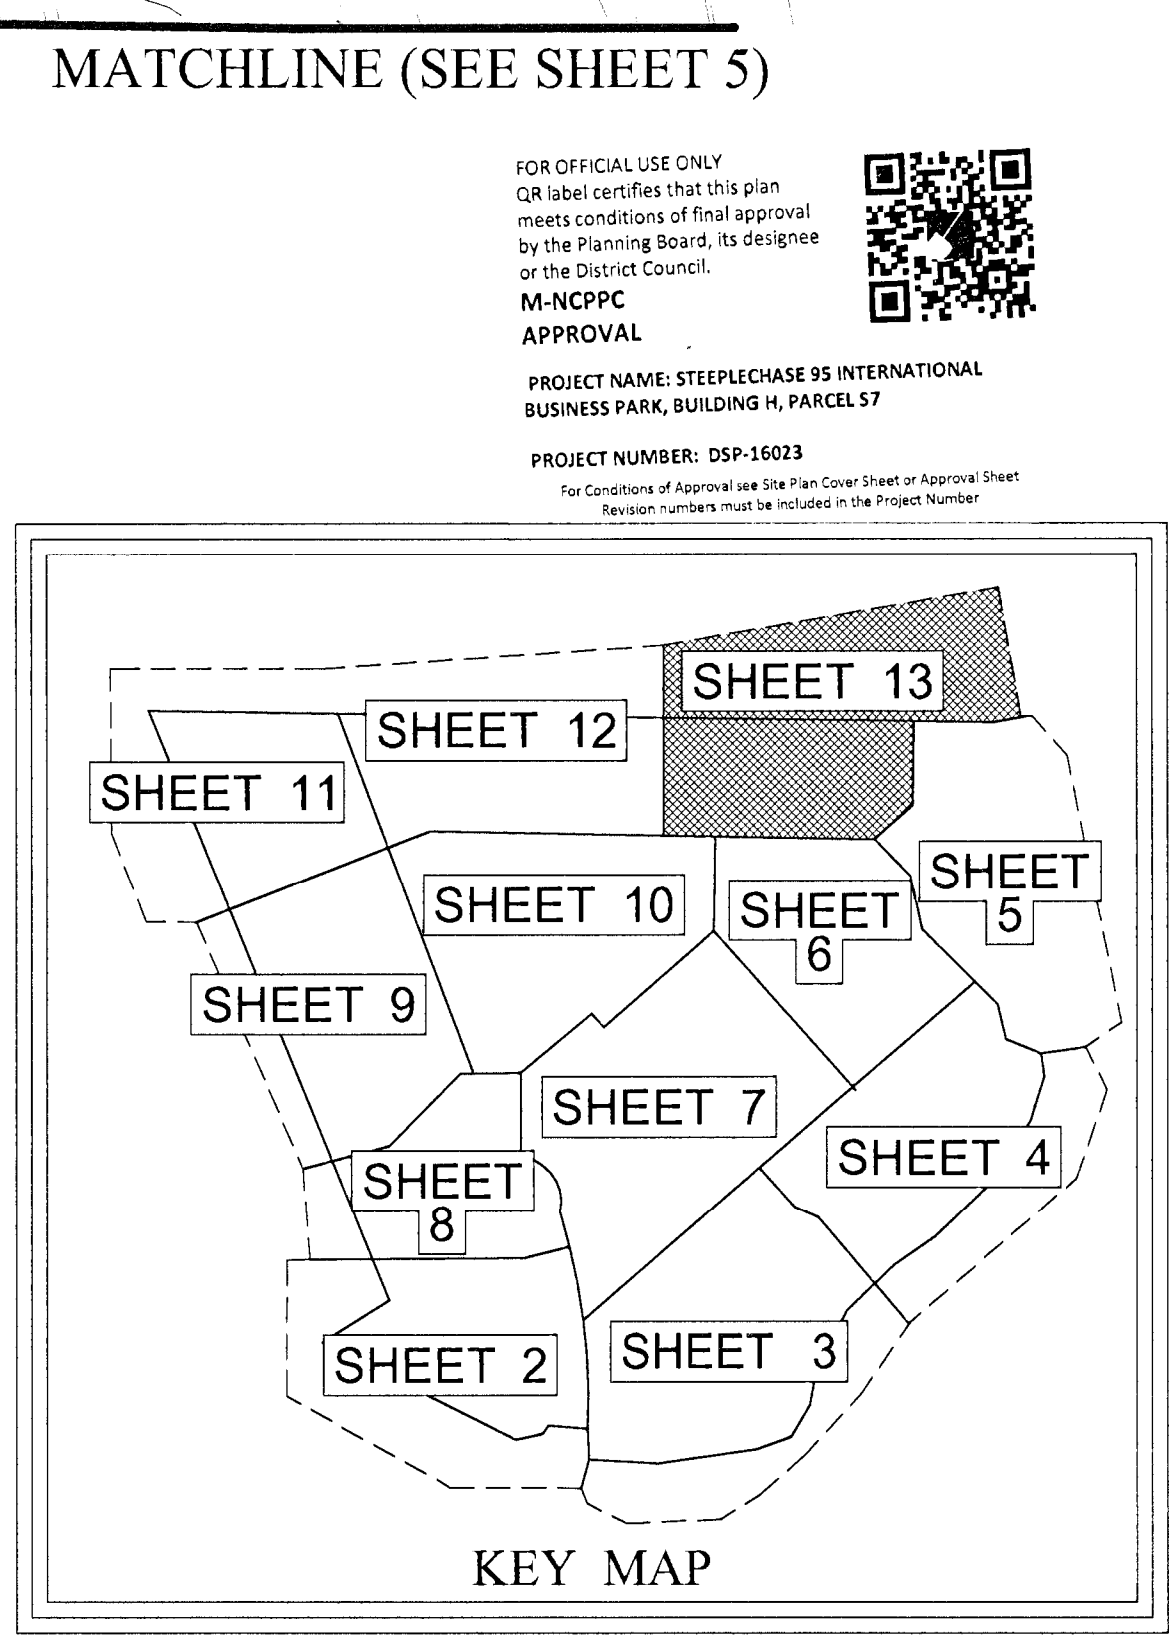

M-NCPPC APPROVALS				M-NCPPC APPROVALS			
PROJECT NAME: STEEPLCHASE BUSINESS PARK				PROJECT NAME: STEEPLCHASE BUSINESS PARK			
PROJECT NUMBER: DSDS-641				PROJECT NUMBER: DSP-05044			
FOR CONDITIONS OF APPROVAL, SEE SITE PLAN COVER SHEET OF APPROVAL SHEET				FOR CONDITIONS OF APPROVAL, SEE SITE PLAN COVER SHEET OF APPROVAL SHEET			
REVISED UNDER REVIEW PER TO THE SHEET				REVISED UNDER REVIEW PER TO THE SHEET			
APPROVAL / REVISION	DATE	REVIEWER INITIALS	CERTIFICATION DATE	APPROVAL / REVISION	DATE	REVIEWER INITIALS	CERTIFICATION DATE
	7-23-07	SA	11-14-07		7-11-08	KW	3-7-07
					7-23-07	SA	11-14-07

M-NCPPC
Prince George's County Planning Department
Environmental Planning Section

APPROVAL
TREE CONSERVATION PLAN
TCP11 / 128 / 90

REV. No.	APPROVED BY	DATE	ASSOCIATED CASE
01	JIM STASZ	8/07/90	
02	ROBERT E. METZGER	5/20/04	
03	ROBERT E. METZGER	9/22/04	
04	ROBERT E. METZGER	11/10/06	DSP-05044 PGCPB No. 05-240
05	KATINA SHOULARS	6/2/08	DSP-05044/03 PLANNING DIRECTOR
06	KATINA SHOULARS	2/4/10	
07	KATINA SHOULARS	11/15/06	DSP-05044/05
08	KATINA SHOULARS	12/27/13	STAFF LEVEL
09	MEGAN K. REISER	6/30/14	STAFF LEVEL
10	MEGAN K. REISER	11/13/14	STAFF LEVEL
	Megan K. Reiser	2/14/17	DSP-16023 PGCPB No. 16-139

OWNER/DEVELOPER
ATAPCO PROPERTIES, INC.
10 EAST BALTIMORE AVE
SUITE 1501
BALTIMORE, MD 21202
CONTACT: KRISTINA MACEK
410-347-7163

GLWGUTSCHICK LITTLE & WEBER, P.A.
CIVIL ENGINEERS, LAND SURVEYORS, LAND PLANNERS, LANDSCAPE ARCHITECTS
3909 NATIONAL DRIVE - SUITE 250 - BURTONTOWNE OFFICE PARK
BURTONTOWNE, MARYLAND 20866
TEL: 301-421-4024 BAL: 410-880-1820 DC/VA: 301-989-2524 FAX: 301-421-4186

NOTE:
THIS TCP 11/128/90-01 IS FOR ROUGH GRADING ONLY.
THE REFORESTATION AREAS ARE NOT CONSIDERED
APPROVED ON THIS PLAN AND MUST BE SHOWN ON A
REVISED TCP-II WITH BUILDING LOCATIONS AND GRADING
PRIOR TO ISSUANCE OF THE FIRST BUILDING PERMIT.

NOTE: TCP11 REVISION #08 APPLIES TO SHEETS 1, 7, 8, 10, & 14A ONLY.

REVISION			
NO.	DATE	BY	DATE
5	10/13/05	CWJ	
3	5/25/05	CWJ	
2	8/04/04	YOR	
1	5/10/04	BAM	

DATE: JULY, 2013
DTS: XXX

CAD STANDARDS VERSION: AUTOCAD CIVIL 3D 2011
DTS: XXX

CHK: XXX

TAX MAP 74	
GRID C-3, D-3, E-3	GRID C-4, D-4, E-4
M-NCPPC 200' SHEET	
202 SE DB	
WSSC 200' SHEET	
202 SE DB	


**TREE CONSERVATION PLAN
TYPE II**

MISS UTILITY NOTE
INFORMATION CONCERNING EXISTING UNDERGROUND UTILITIES WAS OBTAINED FROM AVAILABLE RECORDS. THE CONTRACTOR MUST DETERMINE THE EXACT LOCATION AND ELEVATION OF ALL EXISTING UTILITIES AND UTILITY CROSSINGS BY DIGGING TEST PITS BY HAND, WELL IN ADVANCE OF THE START OF EXCAVATION. CONTACT "MISS UTILITY" AT 1-800-285-7777, 48 HOURS PRIOR TO THE START OF EXCAVATION. IF CLEARANCES ARE LESS THAN SHOWN ON THIS PLAN OR TWELVE (12) INCHES, WHICHEVER IS LESS, CONTACT THE ENGINEER AND THE UTILITY COMPANY BEFORE PROCEEDING WITH CONSTRUCTION. CLEARANCES LESS THAN NOTED MAY REQUIRE REVISIONS TO THIS PLAN.

**PARCELS 1, 22, 24, 34-37, 39-41, 50, 53-61 & 63-66
PARCEL 'K', OUTLOT 'A' AND OUTPARCEL 'A'**

**STEEPLECHASE
BUSINESS PARK**
13TH / HENT ELECTION DISTRICT
PRINCE GEORGE'S COUNTY, MARYLAND


1" = 30'
SHEET 13
OF 14
G. L. W. FILE No.
12026

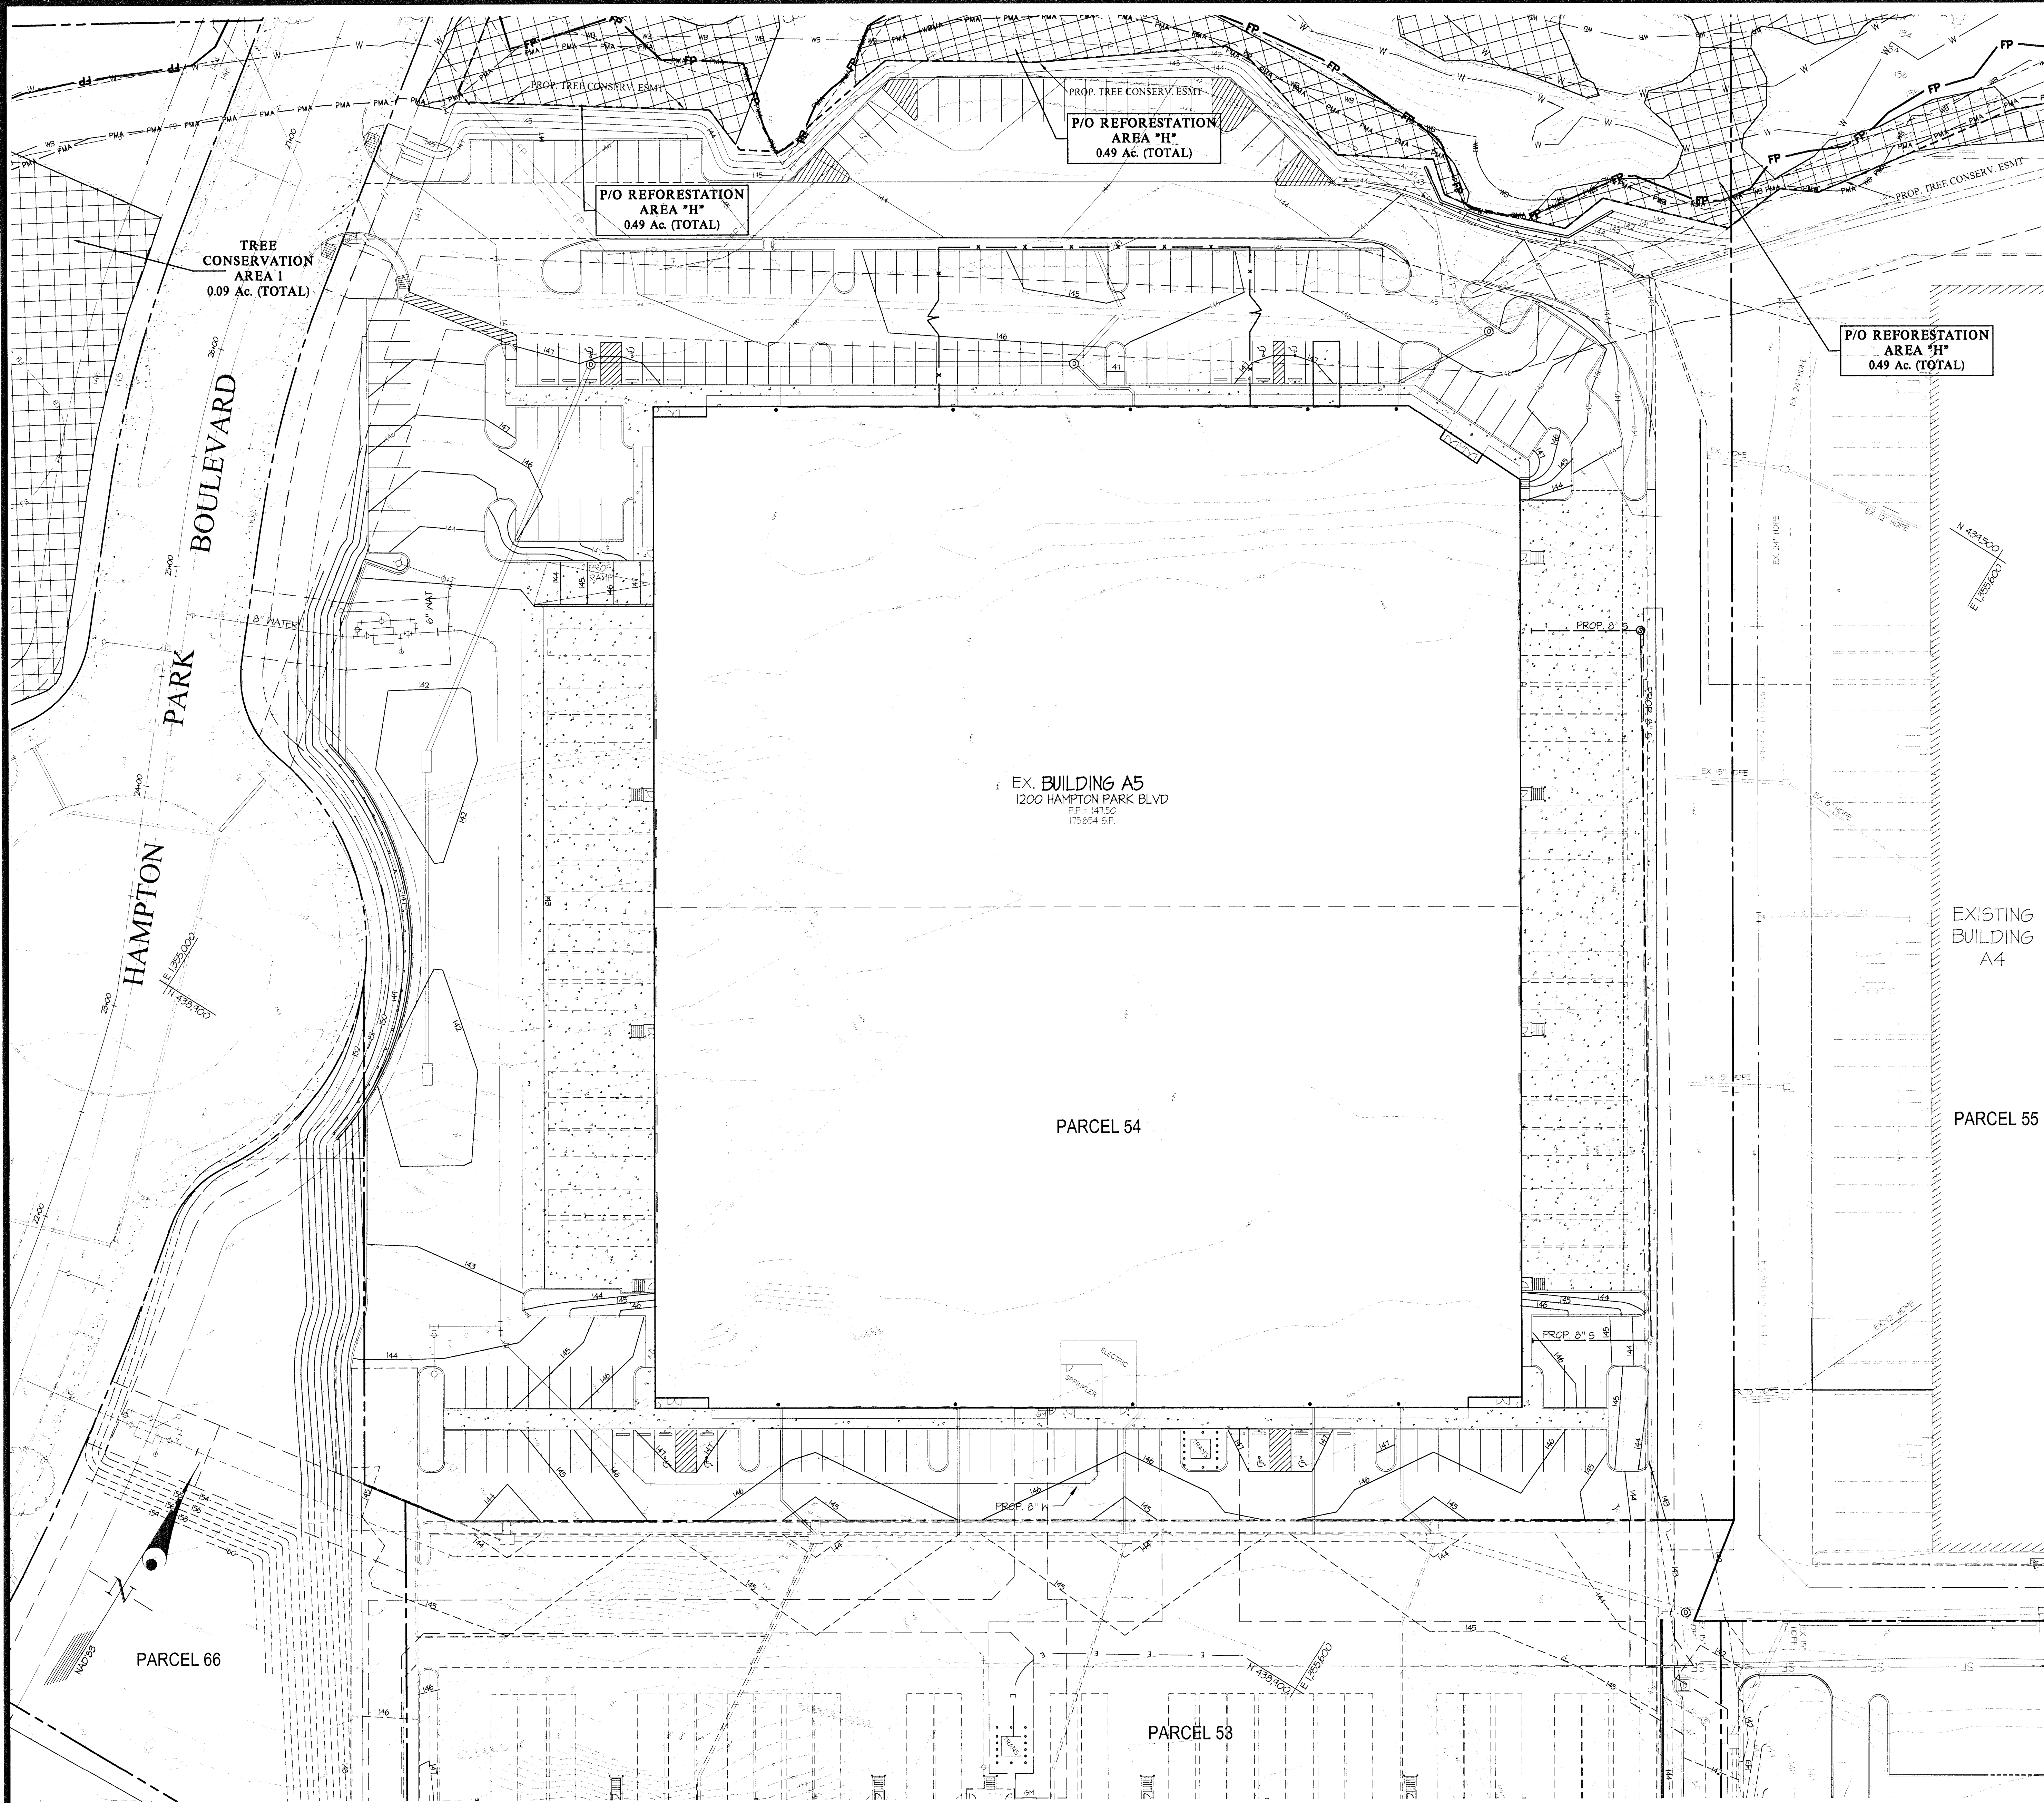

48 Hours
Before You Dig
Call
"MISS UTILITY"
Service Protection Center

MEMBER
ONE CALL SYSTEMS INTERNATIONAL

CALL TOLL FREE
1-800-257-7777

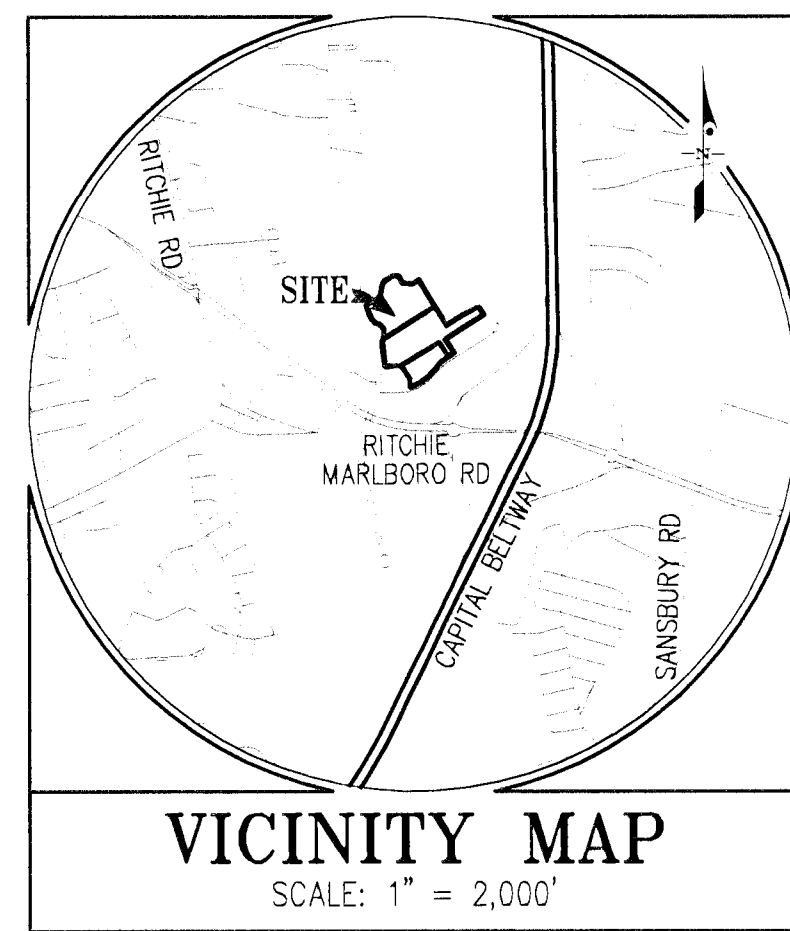

LEGEND

EX. EXISTING	EX. GUTB & GUTTER
PRCP. PROPOSED	PRCP. GUTB & GUTTER
LIMIT OF DISTURBANCE	EX. CONTOUR
EX. STORM DRAIN	PRCP. CONTOUR
PRCP. STORM DRAIN	EX. ELEVATION
SEWER	PRCP. ELEVATION
WATER	EX. BUILDING
OVERHEAD WIRE	PROPOSED BUILDING
FIRE HYDRANT	PRCP. CONC.
WATER VALVE	PRCP. ASPHALT PAVEMENT
WATER METER	EX. EDGE OF PAVEMENT
GAS	WOOD FENCE
GAS VALVE	CHAIN LINK FENCE
ELECTRIC	BARBED WIRE FENCE
POLE W/ LIGHT	SOIL DELINEATION
ELECTRIC POLE	
TRANSFORMER	
SIGN	
HANDICAP	
100-YR OVERFLOW PATH	
PROPERTY LINE	

STABILIZATION PRACTICES ON ALL PROJECTS MUST BE IN COMPLIANCE WITH THE REQUIREMENTS OF COMAR 26.11.06 G REGULATIONS BY JANUARY 1, 2013. REGARDLESS OF WHEN AN EROSION AND SEDIMENT CONTROL PLAN HAS APPROVED. FOLLOWING INITIAL SOIL DISTURBANCE OR RE-DISTURBANCE, PERMANENT OR TEMPORARY STABILIZATION MUST BE COMPLETED WITHIN:

A) THREE (3) CALENDAR DAYS AS TO THE SURFACE OF ALL PERIMETER DIKES, SWALES, DITCHES, PERIMETER SLOPES, AND ALL SLOPES STEEPER THAN 3 HORIZONTAL TO 1 VERTICAL (3:1); AND

B) SEVEN (7) CALENDAR DAYS AS TO ALL OTHER DISTURBED OR GRADED AREAS ON THE PROJECT SITE NOT UNDER ACTIVE GRADING.

M-NCPPC APPROVALS

PROJECT NAME:	STEEPLECHASE BUSINESS PARK		
PROJECT NUMBER:	DSOS-641		
FOR CONDITIONS OF APPROVAL, SEE SITE PLAN COVER SHEET OR APPROVAL SHEET REVISED LISTED BELOW APPLY TO THIS SHEET			
APPROVAL OR REVISION #	APPROVAL DATE	REVIEWER'S INITIALS	CERTIFICATION DATE

M-NCPPC APPROVALS

PROJECT NAME:	STEEPLECHASE BUSINESS PARK		
PROJECT NUMBER:	DSP-05044		
FOR CONDITIONS OF APPROVAL, SEE SITE PLAN COVER SHEET OR APPROVAL SHEET REVISED LISTED BELOW APPLY TO THIS SHEET			
APPROVAL OR REVISION #	APPROVAL DATE	REVIEWER'S INITIALS	CERTIFICATION DATE

FOR OFFICIAL USE ONLY
OR label certifies that this plan meets conditions of final approval by the Planning Board, its designee or the District Council.


M-NCPPC APPROVAL

PROJECT NAME: STEEPLECHASE BUSINESS PARK
BUSINESS PARK BUILDING H-PARCELS 57

PROJECT NUMBER: DSP-16023

For Conditions of Approval, see Site Plan Cover Sheet or Approval Sheet. Revision numbers must be included in the Project Number.

NOTE: TCPII REVISION #08 APPLIES TO SHEETS 1, 7, 8, 10, & 14A ONLY.

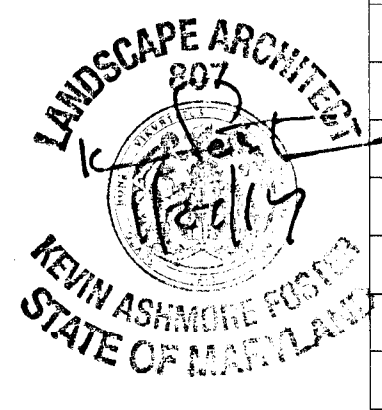

GLWGUTSCHICK LITTLE & WEBER, P.A.
CIVIL ENGINEERS, LAND SURVEYORS, LAND PLANNERS, LANDSCAPE ARCHITECTS
3909 NATIONAL DRIVE - SUITE 250 - BARTONVILLE OFFICE PARK
BARTONVILLE, MARYLAND 20866
TEL: 301-421-4024 FAX: 410-880-1800 DC/VA: 301-989-2524 FAX: 301-421-4186

01/16/17	REV. PAR. 57 PER DSP, REV. PA. 65 PER DSP, UPDATED PARCEL NUMBERS & REV. FLOODPLAIN DELINEATION ON PARCEL 57.	KAB	KAF
07/11/2016	REV. PAR. 57 PER DSP, REV. PAR. 65 PER DSP, UPDATED PARCEL NUMBERS & REV. FLOODPLAIN DELINEATION ON PARCEL 57	KAB	MFC
02/26/2014	REVISED TREE CONSERVATION EASEMENT	RLG	MFC
DATE	REVISION	BY	APPR.



PREPARED FOR: ATAPCO PROPERTIES, INC. ONE SOUTH STREET SUITE 2800 BALTIMORE, MD 21202 ATTN: KRISTINA MACEK PH: 410.347.7163	SCALE: 1"=30'	ZONING: I-1	BUILDING A5 - TYPE II TREE CONSERVATION PLAN STEEPLECHASE BUSINESS PARK PARCELS 1, 22, 24, 34-37, 39-41, 50, 53-61 & 63-66 PARCELS 'K', OUTLOT 'A' AND OUTPARCEL 'A' PLAT BK. MMB 233 No. 62 & 86; BK. MMB 234 No. 46; BK. MMB No. 98; BK. PM 219 No. 70; BK. PM 225 No. 68; PLAT BK. PM 226 No. 64 & 65; BK. PM 231 No. 99; PM 232 No. 33; BK. REP 305 No. 95 KENT ELECTION DISTRICT No. 13 PRINCE GEORGE'S COUNTY, MARYLAND	G. L. W. FILE No. 12026 SHEET 14-A OF 14
---	------------------	----------------	--	--