


## PRE-CONSTRUCTION ACTIVITIES

- Prior to any disturbance of the site, the tree save lines shall be field located by surveying techniques and the appropriate tree protective device (see detail) shall be erected along those lines. Only one (1) tree protection device shall be used for each tree. The device shall be installed by cutting or other clearing, grubbing or grading operations begin. All protection devices should remain in place until all construction has ceased in the immediate vicinity. Deviation shall be prohibited. No equipment, machinery, vehicles, material or excessive pedestrian traffic shall be allowed within the tree protection device.
- After the boundaries of the retention area have been staked and flagged and before any disturbance has taken place on site, a pre-construction meeting at the construction site shall take place. The developer, contractor or project manager, and appropriate local inspectors shall be present.
- Erosion and Sediment Control Notes as well as the Construction Schedule can be found on sheet \_\_\_\_\_.
- Only after final grading, stabilization, and removal of controls has been accomplished may reforestation begin. Reforestation techniques and methods must comply with the details and specifications provided for in the Construction Schedule.

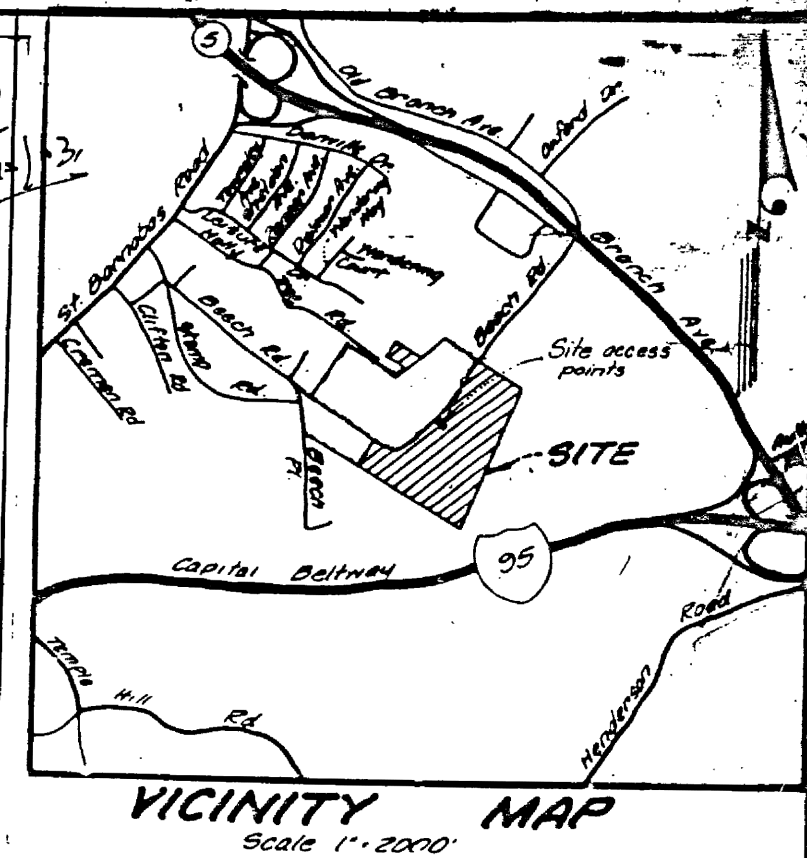

PLANTING SPECIFICATIONS (FOR REFORESTATION AND AFFORESTATION AREAS)





- |     |                                      |  |
|-----|--------------------------------------|--|
| 1.  | <b>Quantity:</b>                     | (see Plant Schedule)   |
| 2.  | <b>Tree:</b>                         | (see Plant Schedule)   |
| 3.  | <b>Plant Quality/Description:</b>    | The plants selected shall be healthy and sturdy representative of their species. Seedlings shall have a minimum top growth of 18". The diameter of the top of the part of the tree below ground level shall be at least 3". The roots shall be well developed and extend to at least 25% of the circumference of the top of the system. Both the primary and secondary/bottom show evidence of being supported or pruned from the plant and the saplings produced from these trees shall be present.   |
| 4.  | <b>Planting:</b>                     | Plants that do not have an abundance of well developed terminal buds on the leaves and branches shall be rejected.   |
| 5.  | <b>Planting:</b>                     | Plants shall be moved by the nursery immediately after fitting from the field or removal from the greenhouse, and immediately upon receipt by the landscape contractor.  |
| 6.  | <b>Planting:</b>                     | Plants shall be planted immediately after delivery to the restoration site; they shall be stored in the shade until they can be planted. Plants shall be kept in direct exposure to sun and wind by the use of straw, peat, moss, or other suitable material and shall be maintained through the winter.   |
| 7.  | <b>Plant Handling:</b>               | The quantity of seedlings taken to the field shall not exceed the quantity that can be planted in a day. Seedlings, once removed from the nursery or temporary storage site, shall not be stored for more than 14 days.  |
| 8.  | <b>Timing of Planting:</b>           | The time to plant seedlings is while they are dormant, prior to spring budbreak. The most suitable months for planting are March and April, when the soil is warm and the plants are dormant. Planting should be completed by June 1st. Plants should be kept in cold storage (and therefore dormant) until planting. November and early December are acceptable planting times for this region as cold and dry weather is common.   |
| 9.  | <b>Seedling Planting:</b>            | Tree seedlings may be hand planted using a dibble bar or a shapshotor. Seedlings shall be planted with the root system in the soil. The roots must not be exposed; they should not be twisted, bent, or in bags. Moles not used should not be packed tightly into the soil. Seedlings should be planted at a depth where the cotyledons lie just below the ground surface. Air pockets should never be left in the hole while allowing the roots to settle. The planting dibble should be inserted and the contractor should be allowed to move the dibble. The Landscape Architect must be contacted and give his approval before allowing the contractor to plant seedlings. |
| 10. | <b>Readings:</b>                     | See Plant Schedule and the Planting Schedule for specific readings. Also refer to the Planting Layout detail for a description of the specific planting types.   |
| 11. | <b>Soil:</b>                         | Upon the completion of all groundworks, a soil test shall be conducted to determine what amendments and soil grades are necessary. If any, are necessary to create good growing conditions. Soil amendments shall be applied to the soil in the areas where the soil test has been done. A different soil type for the entire area requires uniform, then only one area is necessary, and submitted for acceptance by the Landscape Architect.   |
| 12. | <b>Soil:</b>                         | The Soil Testing Laboratory<br>University Department<br>H. P. Pofford Hall<br>Agriculture of Maryland<br>College Park, Maryland 20742  |
| 13. | <b>Field tests:</b>                  | These field tests will be performed for 18 weeks, which includes the soil water-saturated testing to the Cooperative Extension Service of Prince George's County at the University of Maryland. The tests will be performed for recommendations for improving the existing soil. The soil will be tested for nutrient concentrations for all nutrients, pH, magnesium, potassium, calcium and organic matter.  |
| 14. | <b>Soil Improvement:</b>             | (see the soil test) shall be improved according to the recommendations of the Cooperative Extension Service of Prince George's County.   |
| 15. | <b>Fencing &amp; Signage:</b>        | (see Restoration Area Fence Detail)  |
| 16. | <b>Planting Map:</b>                 | Consult the Planting Details drawn on this plan.   |
| 17. | <b>Mulching:</b>                     | Apply 2" deep wood chips or shredded hardwood mulch (as needed) to each planting site (see detail shown on this plan).   |
| 18. | <b>Goodwill/Post-Planting:</b>       | The remaining disturbed area between seedling plantings shall be covered and stabilized with white clover seed at the rate of 5 lbs./acre.   |
| 19. | <b>Revised:</b>                      | The stabilized area within the seedling planting area is to be moved once a year during the growing season. The seedling planting area shall be moved once a year to identify seedlings for weeding and/or flagging seedlings prior to moving activity.  |
| 20. | <b>Smiley Check for Landscaping:</b> | The seedling planting to be checked at the end of each year for each year to assess survival. At least 75% of the original seedling quantities.  |
| 21. | <b>Source of Seedlings:</b>          | W. H. Pofford, Potomac & Wildlife Service Inc. Bowie, Md. Phone (201) 468-4600.<br>2005, Ruppert & Associates Inc.   |

5 YEAR MANAGEMENT PLAN FOR RE/AFFORESTATION

Field check the re-afforestation area according to the following schedule:

- ~~Star 1: Site Preparation and Tree Planting  
Survival check 3 times (March-April, July-August,  
October-November, see Note 1)  
Watering if needed (2 x month)  
Control of undesirable vegetation as needed (1 x in June &  
1 x in September min.)~~
- ~~Star 2-3: Reinforcement planting if needed (see Note 2)  
Survival check twice annually (April-May),  
(September-October)  
Control of undesirable vegetation if needed (1 x in May &  
1 x in August min.)~~
- ~~Star 4-5: Reinforcement planting if needed (See Note 2)~~

- 1) ~~Survival Check: Check plant stock against plant list (or as-built) by walking the site and taking inventory. Plants must show signs of vitality. Submit field data forms (Condition Check-Sheets) to owner after each inspection. Remove all dead plants.~~
- 2) ~~Reinforcement Planting: Replace dead or missing plants in sufficient quantity to bring the total number of live plants to at least 10% of the number originally planted. If a particular species shows unusually high mortality, replace with an alternate plant type.~~
- 3) ~~Miscellaneous: Fertilization or watering during years 1 through 3 will be done on an as needed basis. Special return operations/recommendations will be conducted on an as needed basis. Remove perimeter fencing and signage after year 5 based on the date planted.~~

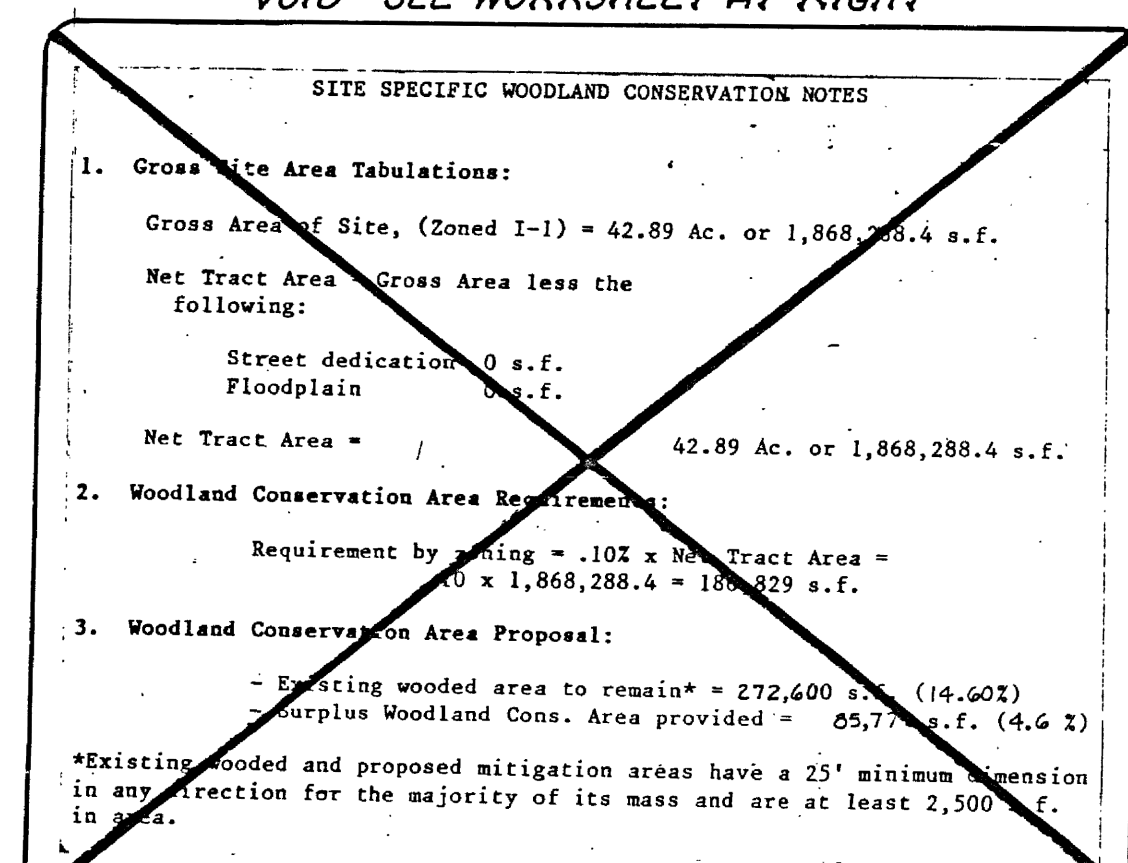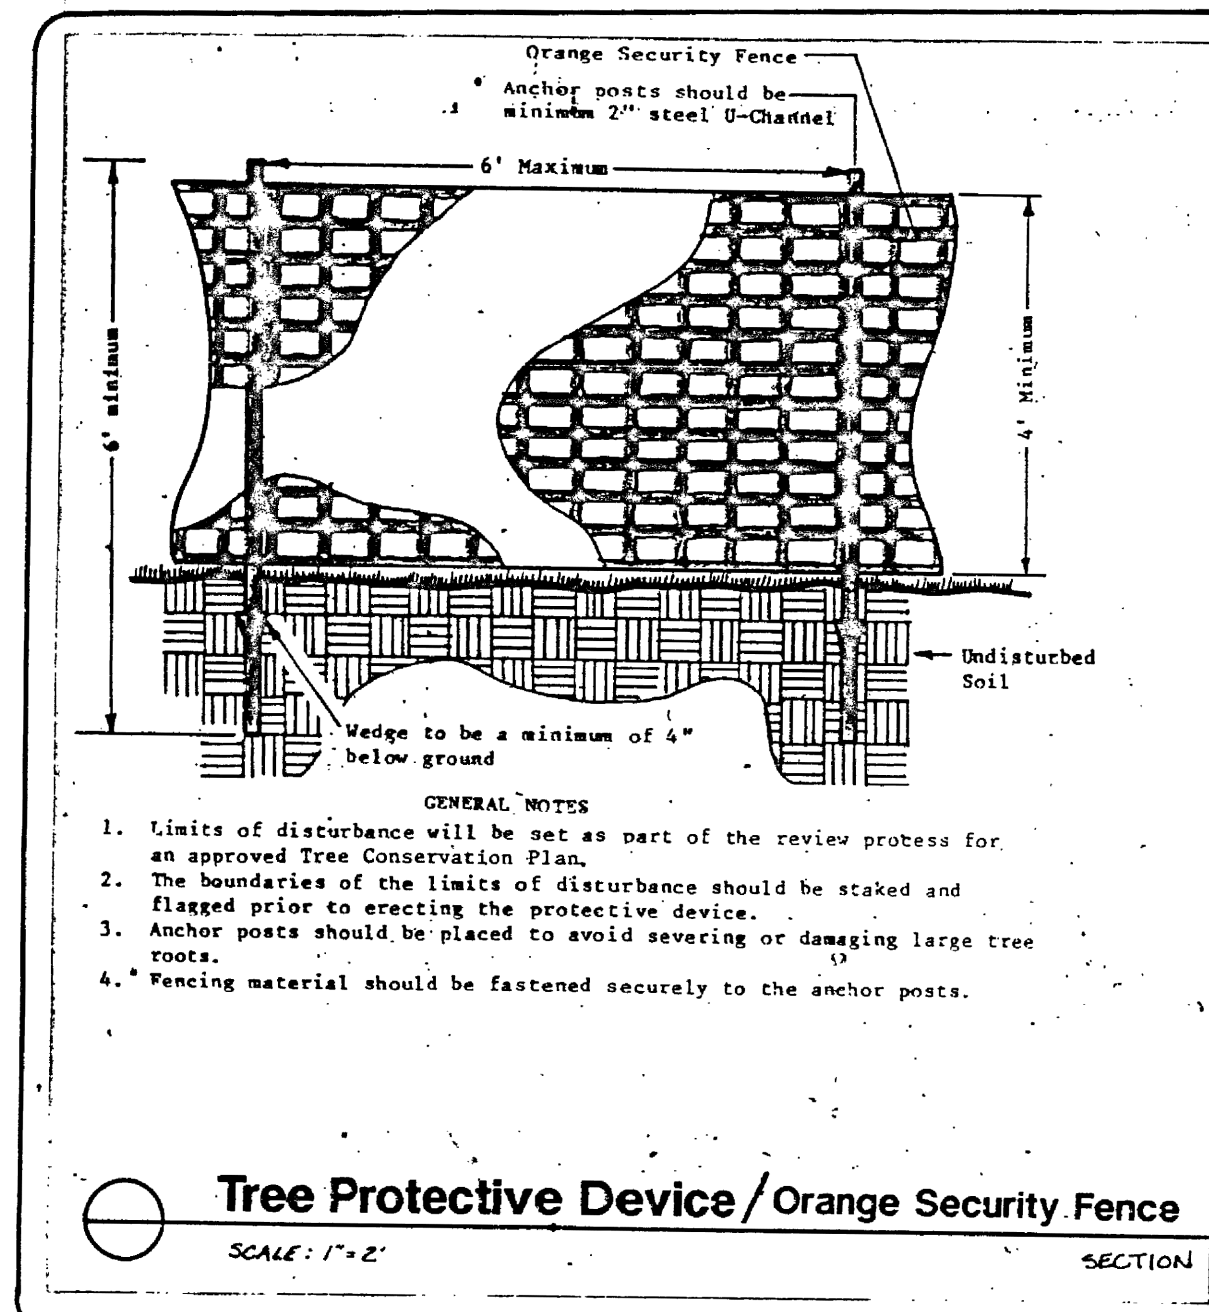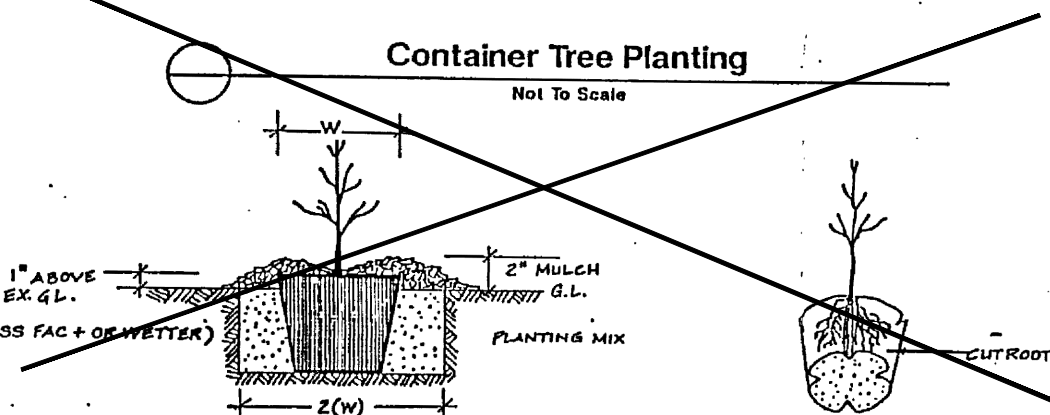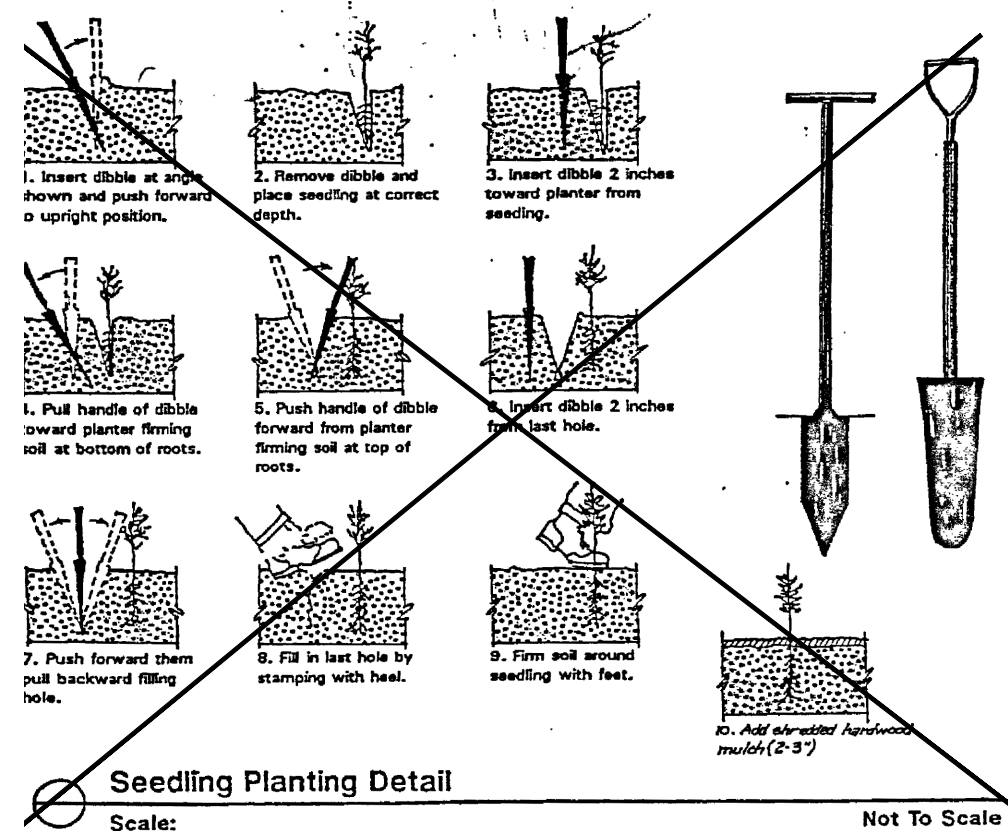

Standard Woodland Conservation Worksheet for Prince George's County					
SECTION I - Establishing Site Information (Enter answers for each zone)					
1	Zone	H-1			
2	Grass Tract				
3	Forestland				
4	Previously Dedicated Land	0.00			
5	Nest Tract (NPA)	0.75			
6	FCP Number	TCR1 290-200			Revision #
7	Property Description or Subdivision name	Capital Area Auction			
8	Is this site subject to the 1981/1991 Ordinance	N			
9	Is this site subject to the 1991 Ordinance	N			
10	Subject to 2010 Ordinance and in PPA (Pond/Findland Area)	N			
11	Is this one acre eligible for a WCT?	N			
12	Are there prior TOP approvals which include a	N			
13	Location of this site? (Y or N)	N			
14	Is any portion of the property a WCT (B)? (Y or N)	N			
15	Break-even Cost (preparation + )	4.12	acres		
16	Preparation cost and value reduction	1.27	acres		
SECTION II - Determining Requirements (Enter answers for each corresponding column)					
	Column A WCT (A)?	Column B Net Tract	Column C Forestland	Column D Off-Site Type I	
17	Existing Woodland		8.16	0.00	
18	Woodland Conservation Threshold (WCT) =	15.00%	1.80		
19	Smaller of 17 or 18		1.80		
20	Woodland above WCT		2.36		
21	Woodland below WCT		1.11	0.00	
22	Woodland cleared above WCT (smaller of 16 or 17)		1.33		
23	Clearing above WCT (2.0 - 1 replacement requirement)		1.33		
24	Woodland cleared below WCT		2.84		
25	Clearing below WCT (2 replacement requirement)		0.88		
26	Alfordication (reduced) = (net tract (A) - )	15.00%	0.00		
27	Off-site WCA being provided on this property		0.00		
28	Woodland Conservation Requirement		7.00		
SECTION III - Meeting the Requirements (Enter answers for each corresponding column)					
29	Woodland Preservation		1.80		
30	Alfordication / Reforestation		0.24		
31	Natural Regeneration		0.88		
32	Land-escape Credits		0.00		
33	Alfordication (Area Credit) (CR2 area - 2.0)		0.00		
34	Forest Enhancement Credit (Area - 2%)		0.00		
35	Street Tree Credit (Existing 10-year canopy coverage)		0.00		
36	Area Appraisal (Area - 10%)		0.00		
37	Off-site WCA Alfordication Credits Required		0.37		
38	Off-site WCA Alfordication being provided on this property		0.00		
39	Off-site WCA Alfordication being provided in this property		0.00		
40	Woodland Conservation Provided		7.00		
41	Area of woodland not cleared		1.00		
42	Net-tract woodland retained w/out of requirements:		0.46		
43	100-percent woodland retained		0.00		
44	On-site woodland conservation provided		0.86		
45	On-site woodland conservation alternatives provided		0.00		
46	On-site woodland retained not retained		0.46		
47	Prepared by: Michael Petralis				







NATURAL REGENERATION AREA (NRA)	
NO.	AREA (AC)
1	0.30
2	0.59
TOTAL	0.89

WOODLAND REFORESTATION / AFFORESTATION AREA (WRA)	
NO.	AREA (AC)
1	0.27
2	2.86
3	0.83
4	1.28
TOTAL	5.24

WOODLAND PRESERVATION AREA (WPA)	
NO.	AREA (AC)
1	0.45
2	0.08
TOTAL	0.53

<u>Plant Schedule for Re/Afforestation</u>				
Stock Specification:		<u>Additional Re/Afforestation Planting</u>		
1000 seedlings per acre		<u>Spring 2003 (1.26 Acres)</u>		
Total Reforestation Required = 5,930 Acres				
Total Reforestation Requested = 5,930 Acres		Stock Specification:		
Total Seedlings Required = 5,930		1000 seedlings per acre.		
<u>Plant Schedule</u>				
Species	Amount	1000 Seedlings per acre required. <th data-kind="ghost"></th> <th data-kind="ghost"></th>		
		1,260 seedlings are required.		
		Seedlings equivalents provided by handcarping equivalent		
		1,260 / 102 = 1,138 seedlings required.		
Species	Amount	Species	Amount	Land Size
Tulip Poplar	1,186	Bloodgood London		2.55 +/-
Sweet Gum	1,186	Flamenco	9	2.55 +/-
Red Maple	1,186	American Yellow Birch	26	18" x 24"
Red Oak	1,186	American Yew		
American Beech	1,186	American Yew		
Total	5,930	Total Seedlings Credits		

## LEGEND - Tree Conservation

-  Tree Save Area
-  Tree Protective Device
-  Property **no longer owned** by Bevard Family
-  Property **not included** in this TCP
-  **Proposed Reforestation** planted in 2002
-  Natural Regeneration Area

Prince George's County Planning Department, M-NCPPC Environmental Planning Section <b>TREE CONSERVATION PLAN APPROVAL</b> <b>TCP 2 - 90 - 00</b>				
	Approved by	Date	DRD #	Reason for Revision
00	John Markovich	8/14/00		
01	John Markovich	12/5/00		
02	John Markovich	3/2/01		
03	Robert Metzger	3/10/03		
04	<i>David J. Schindler</i>	10/19/2023		Expansion of Auction Bldg. & upgrade SMM for
05				

**TREE CONSERVATION PLAN - TYPE II**

FOR

CAPITAL AUTO AUCTION


5001 BEECH RD, TEMPLE HILLS, MD 20748

SPAULDING DISTRICT NO. 6

PRINCE GEORGE'S COUNTY, MARYLAND

Deed references: Liber 208G, Folio 45G, Liber 444B, Folio 85I, L1555.F.530  
Liber 4233, Folio 528, L. 6425.F.873

OWNER / DEVELOPER / APPLICANT:  
CAA Newton Real Estate  
1905 Brentwood RD. NE  
Washington D.C. 20018  
ATTN: GORDY ZARITSKY


--	---	--