



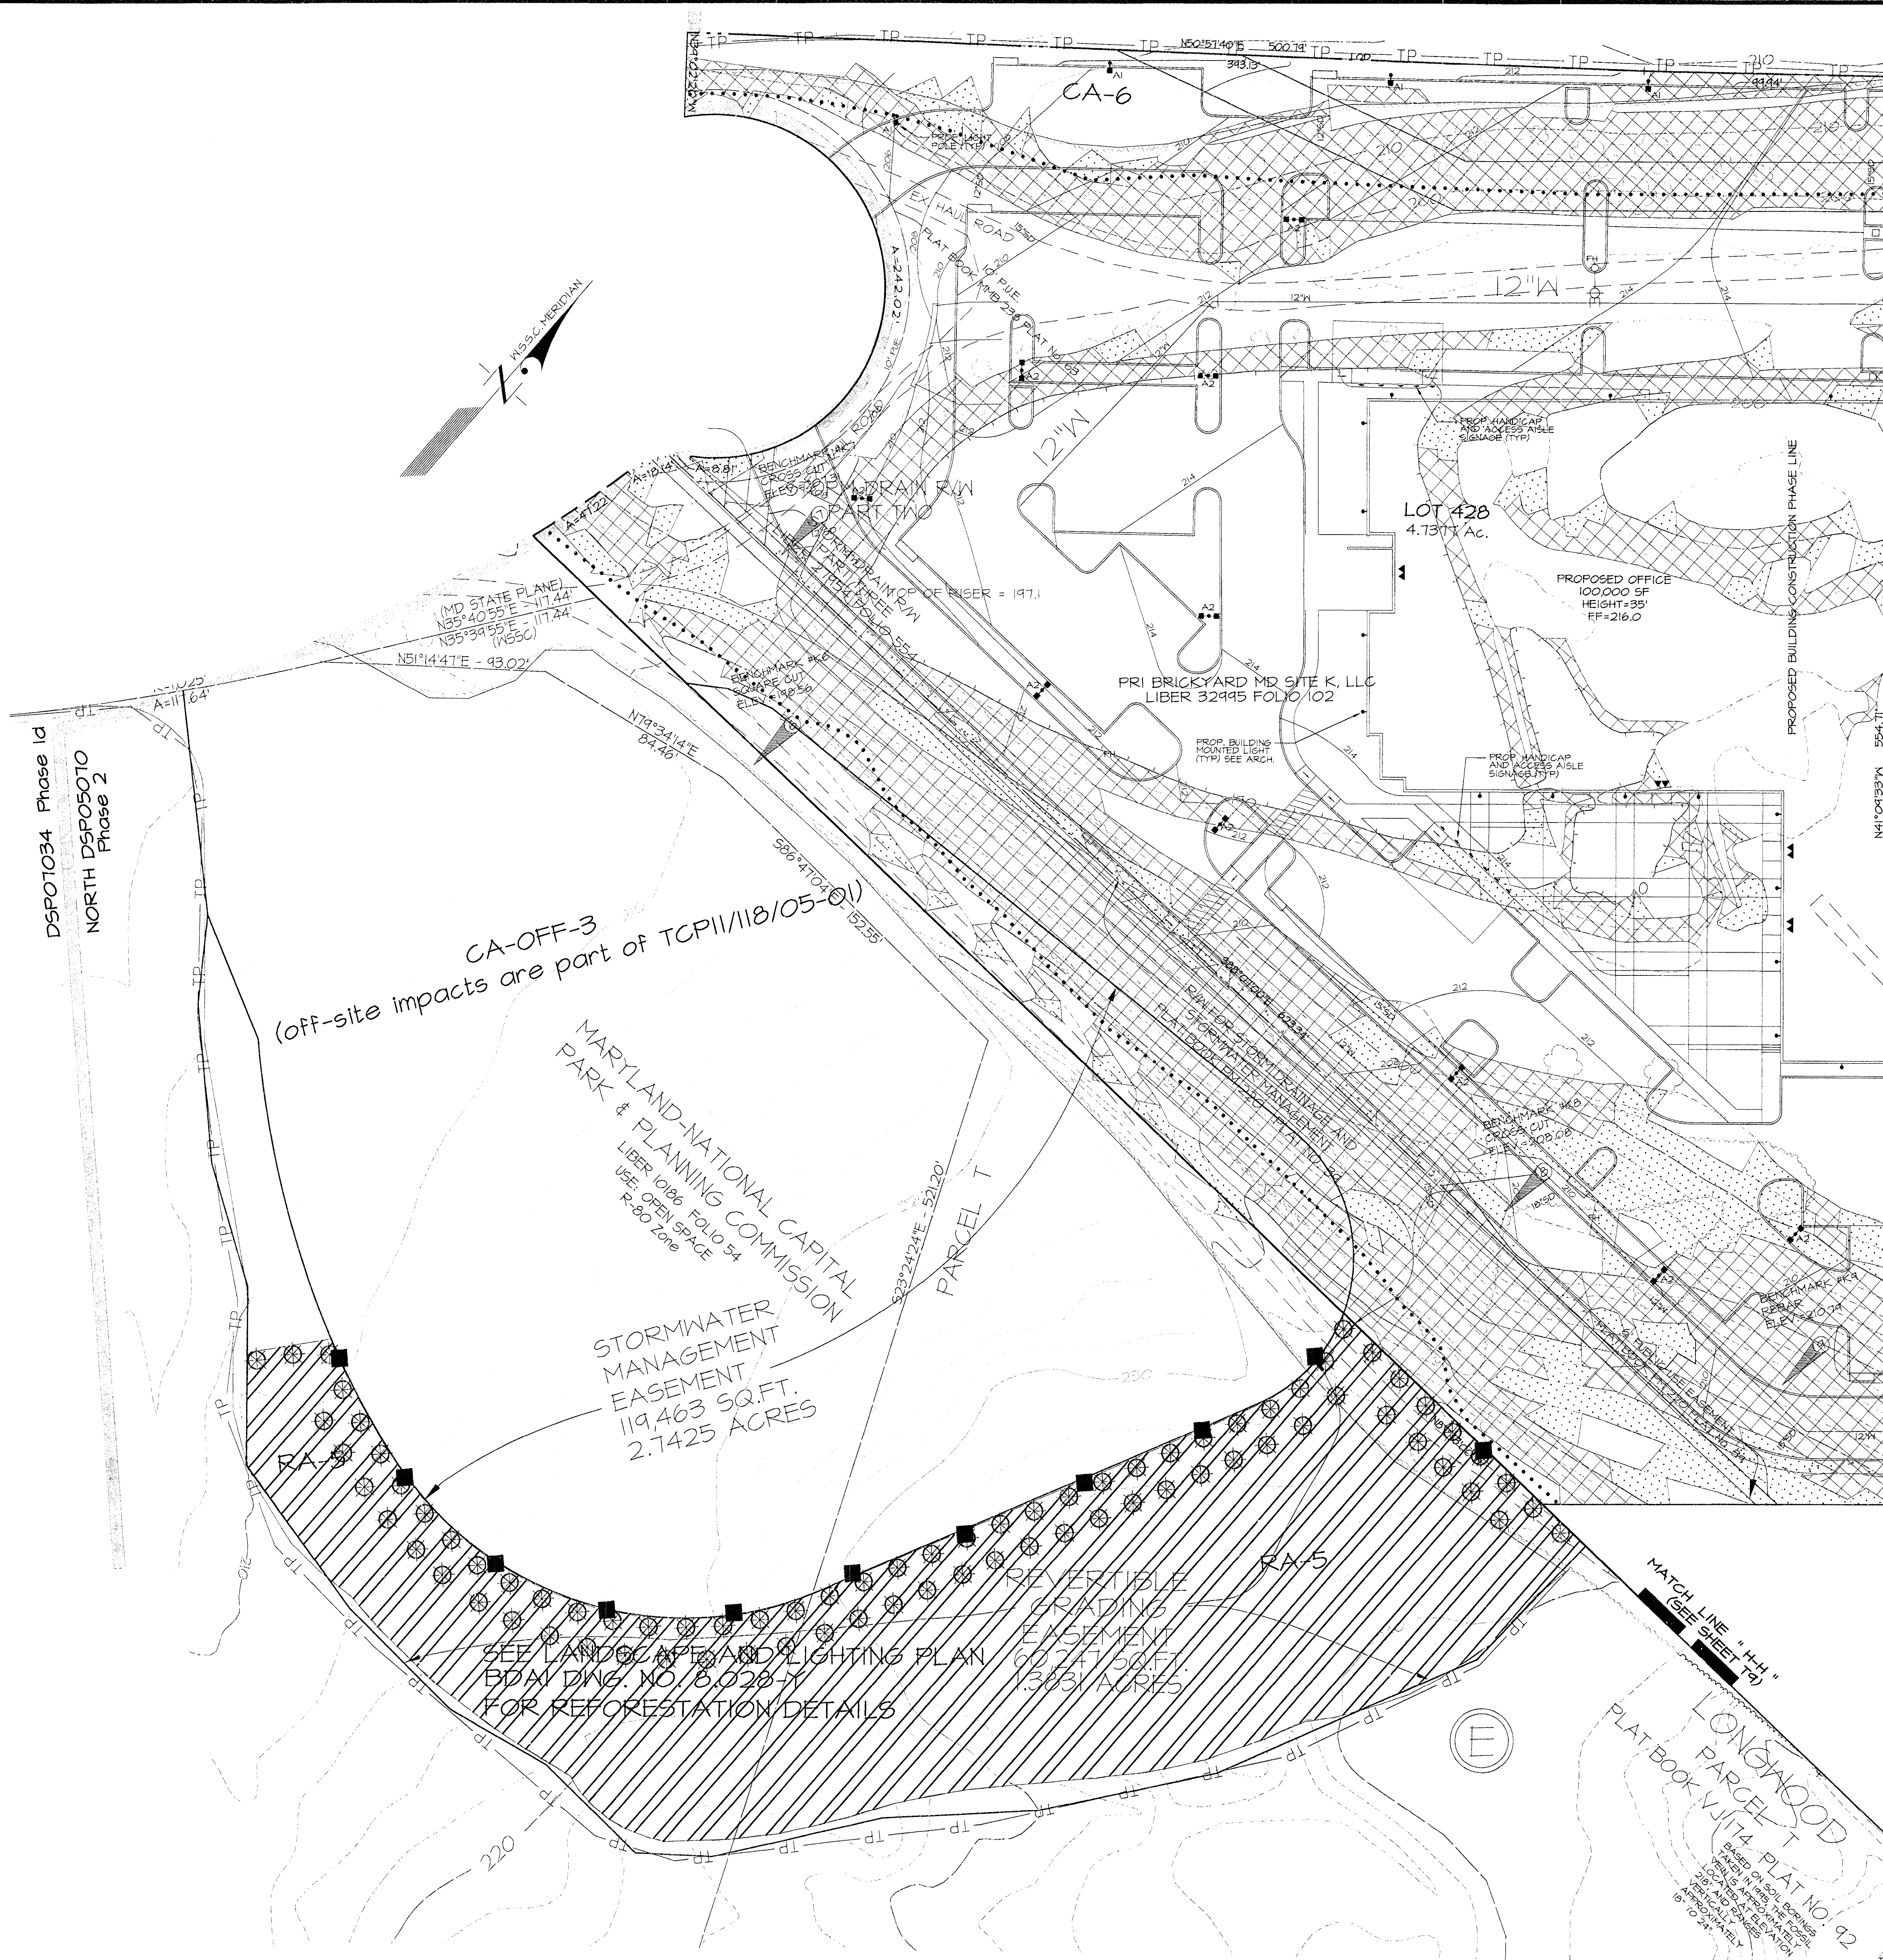

| M-NCPPC<br>Prince George's County Planning Department<br>Natural Resources Division |          |              |
|-------------------------------------------------------------------------------------|----------|--------------|
| APPROVAL                                                                            |          |              |
| TREE CONSERVATION PLAN                                                              |          |              |
| TOP 2-118-05                                                                        |          |              |
| Approved by                                                                         | DATE     |              |
| 01 Lori Shirley                                                                     | 8/15/07  | DSP-05024    |
| 02 Lori Shirley                                                                     | 10/25/08 | DSP-05070    |
| 03 K. Shoulters                                                                     | 5/4/07   | DSP-05070-01 |
| 04 K. Shoulters                                                                     | 12/28/07 | DSP-07034    |
| 05 K. Shoulters                                                                     | 5/20/10  |              |
| 06 K. Shoulters                                                                     | 10/18/11 | DSP-07034-01 |
| 07 K. Shoulters                                                                     | 6/19/13  | DSP-07034-04 |
| 08 K. Shoulters                                                                     | 2/15/15  | DSP-05070-03 |
| 09 K. Shoulters                                                                     | 8/04/14  | DSP-07034-06 |
| 10 Megan K. Reiser                                                                  | 3/20/15  | DSP-07034-08 |

| M.N.C.P.P.C. APPROVALS                                                 |           |         |
|------------------------------------------------------------------------|-----------|---------|
| PROJECT NAME: THE BRICK YARD                                           |           |         |
| PROJECT NUMBER: DSP-05070                                              |           |         |
| For Conditions of Approval see Site Plan Cover Sheet or Approval Sheet |           |         |
| Approval #                                                             | Signature | Date    |
| 01                                                                     | K.N.      | 3/1/07  |
| 02                                                                     | L.S.      | 5/11/07 |
| 03                                                                     | C.L.      | 1/2/08  |


| LEGEND                                                               |     |
|----------------------------------------------------------------------|-----|
| PROPERTY BOUNDARY                                                    | --- |
| EX. CONTOUR                                                          | --- |
| PROP. CONTOUR                                                        | --- |
| EX. TREELINE                                                         | --- |
| LOD                                                                  | --- |
| MINING LIMITS                                                        | --- |
| WATERS OF THE U.S.                                                   | --- |
| NONTIDAL WETLAND                                                     | --- |
| EX. WETLAND BUFFER (25')                                             | --- |
| TREE PROTECTION FENCE                                                | TP  |
| PRESERVATION PROTECTION SIGNAGE                                      | Ⓢ   |
| REFORESTATION PROTECTION SIGNAGE                                     | Ⓡ   |
| 1.5" CALIPER REFORESTATION TREE                                      | Ⓢ   |
| CLEARING AREA                                                        | --- |
| PRESERVATION AREA                                                    | --- |
| REFORESTATION AREA                                                   | --- |
| 15 - 25% SLOPES (HIGHLY ERODIBLE SOILS)                              | --- |
| 25% & GREATER SLOPES                                                 | --- |
| SPECIMEN TREE WITH LIMITS OF CRITICAL ROOT ZONE (30" DBH OR GREATER) | Ⓢ   |

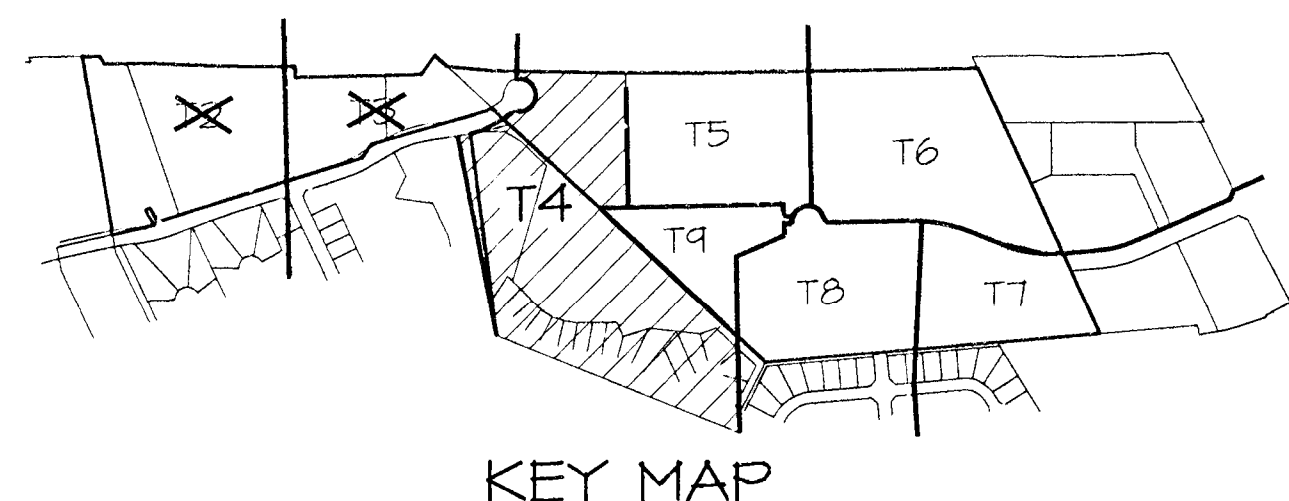

| THIS BLOCK IS FOR OFFICIAL USE ONLY                                                                                               |  |
|---|--|
| OR label certifies that this plan meets conditions of final approval by the Planning Board, its designee or the District Council. |  |
| M-NCPPC APPROVAL   |  |
| PROJECT NAME: THE BRICK YARD NORTH                                                                                                |  |
| PROJECT NUMBER: DSP-01034/08   |  |
| For Conditions of Approval see Site Plan Cover Sheet or Approval Sheet                                                            |  |
| Revision numbers must be included in the Project Number                                                                           |  |

| THIS BLOCK IS FOR OFFICIAL USE ONLY                                                                                               |  |
|---|--|
| OR label certifies that this plan meets conditions of final approval by the Planning Board, its designee or the District Council. |  |
| M-NCPPC APPROVAL   |  |
| PROJECT NAME: THE BRICK YARD NORTH                                                                                                |  |
| PROJECT NUMBER: DSP-05070/03   |  |
| For Conditions of Approval see Site Plan Cover Sheet or Approval Sheet                                                            |  |
| Revision numbers must be included in the Project Number                                                                           |  |

| TREE CONSERVATION PLAN - TYPE II                    |  |
|-----------------------------------------------------|--|
| THE BRICK YARD NORTH                                |  |
| PROPOSED LOTS 20 - 27 & PARCELS 'B', 'C' & 'D'      |  |
| LAUREL DISTRICT No. 10                              |  |
| PRINCE GEORGES COUNTY, MARYLAND                     |  |
| GRAPHIC SCALE 1" = 30'                              |  |
| NAD 83 2000 SHEET SERIES: 210 NE 6 & 7 AND 211 NE 1 |  |
| ADG MAP BK LOCATION 4 C-10                          |  |
| OWNER                                               |  |
| JACKSON SHAW / BRICKYARD LIMITED PARTNERSHIP, LLP   |  |
| 4640 Forbes Boulevard, Suite 150-B                  |  |
| Langham, Maryland 20706                             |  |
| 301-428-0101                                        |  |
| ATTN: Thomas J. Ajlward III                         |  |
| DATE                                                |  |
| DESCRIPTION                                         |  |
| REVISIONS                                           |  |
| 1721 WOODMORE ROAD, SUITE 200                       |  |
| MITCHELLVILLE, MARYLAND 20721                       |  |
| BEN DYER ASSOCIATES, INC.                           |  |
| Engineers / Surveyors / Planners                    |  |
| TELEPHONE (301) 430-2000                            |  |
| FAX (301) 430-2000                                  |  |
| COPYRIGHT © 2005 BEN DYER ASSOCIATES, INC.          |  |
| ALL RIGHTS RESERVED                                 |  |
| J-8304B                                             |  |
| SCALE: 1" = 30'                                     |  |
| DATE: SEPT. 2005                                    |  |
| DRAWING NO. 54.025-Z                                |  |

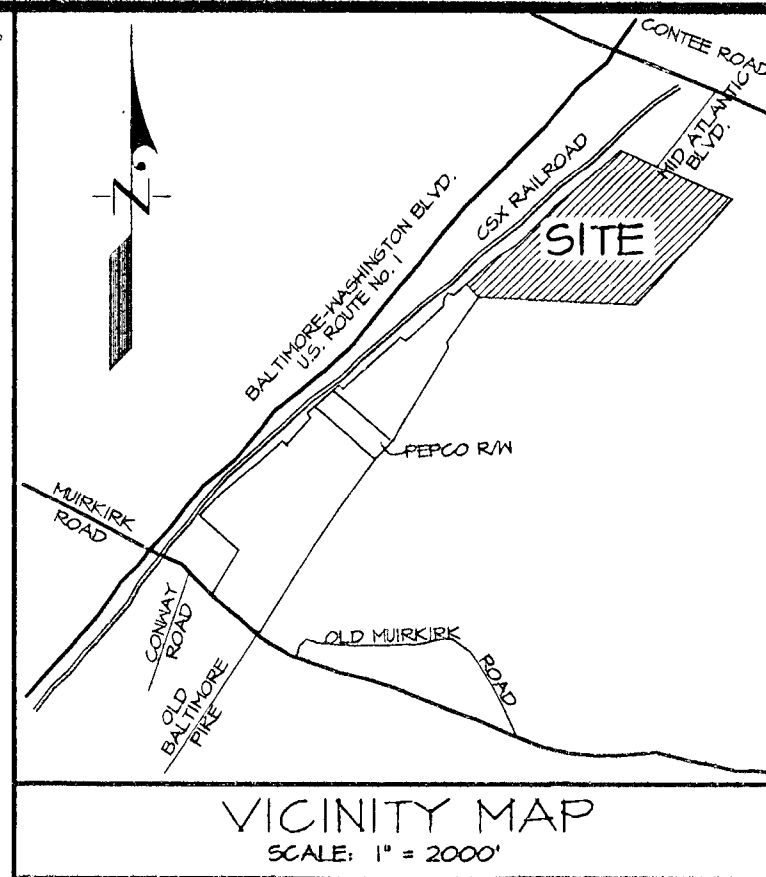

1721 WOODMORE ROAD, SUITE 200  
MITCHELLVILLE, MARYLAND 20721  
BEN DYER ASSOCIATES, INC.  
Engineers / Surveyors / Planners  
TELEPHONE (301) 430-2000

O'DEA  
LYNCH  
ABBATTISTA  
CONSULTING ENGINEERS

NEW YORK • DALLAS  
4230 181st Street, Suite 625, Dallas, TX 75244  
Tel 972.229.6100 Fax 972.229.6102  
www.odca.com

LAW OFFICES  
GIBBS AND HALLER  
4640 FORBES BOULEVARD  
LANHAM, MARYLAND 20706  
(301) 430-2000  
gibbsandhaller.com

O. R. GEORGE & ASSOCIATES, INC.  
Traffic Reports • Transportation Planning  
• Construction • Urban Planning • Urban Design

THE  
BRICK  
YARD  
BELTSVILLE, MARYLAND

JACKSON SHAW  
COMPANY

ALLIANCEARCHITECTS



1600 N. Collins Blvd., Suite 1000 (972) 233-0100  
Richardson, Texas 75080 Fax (972) 233-2259

PROJECT NO.: 24237

T4

DATE: SEPTEMBER 28, 2005




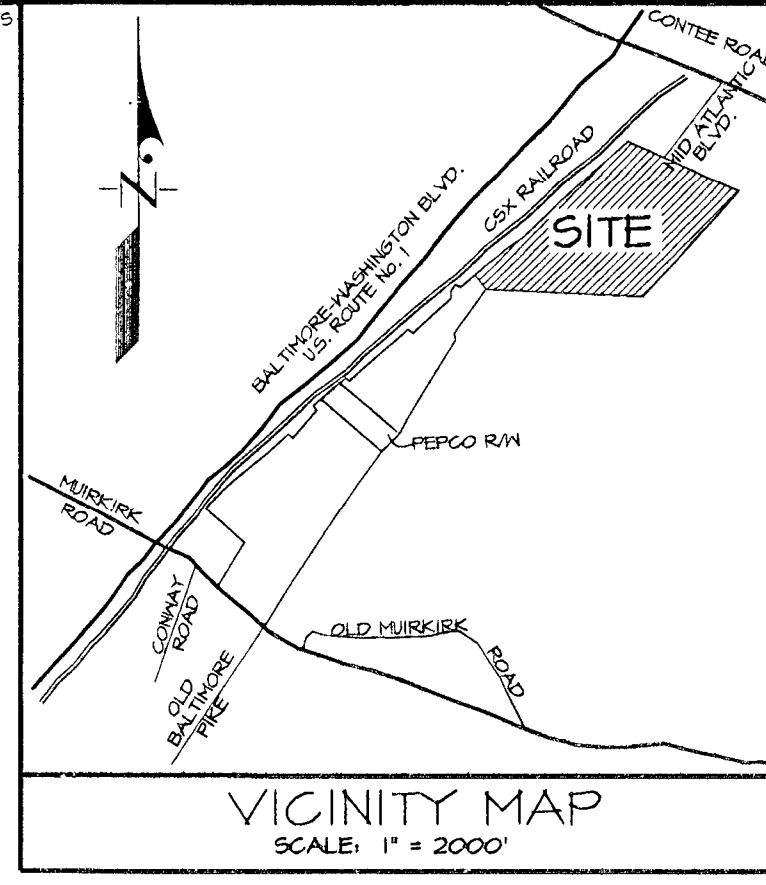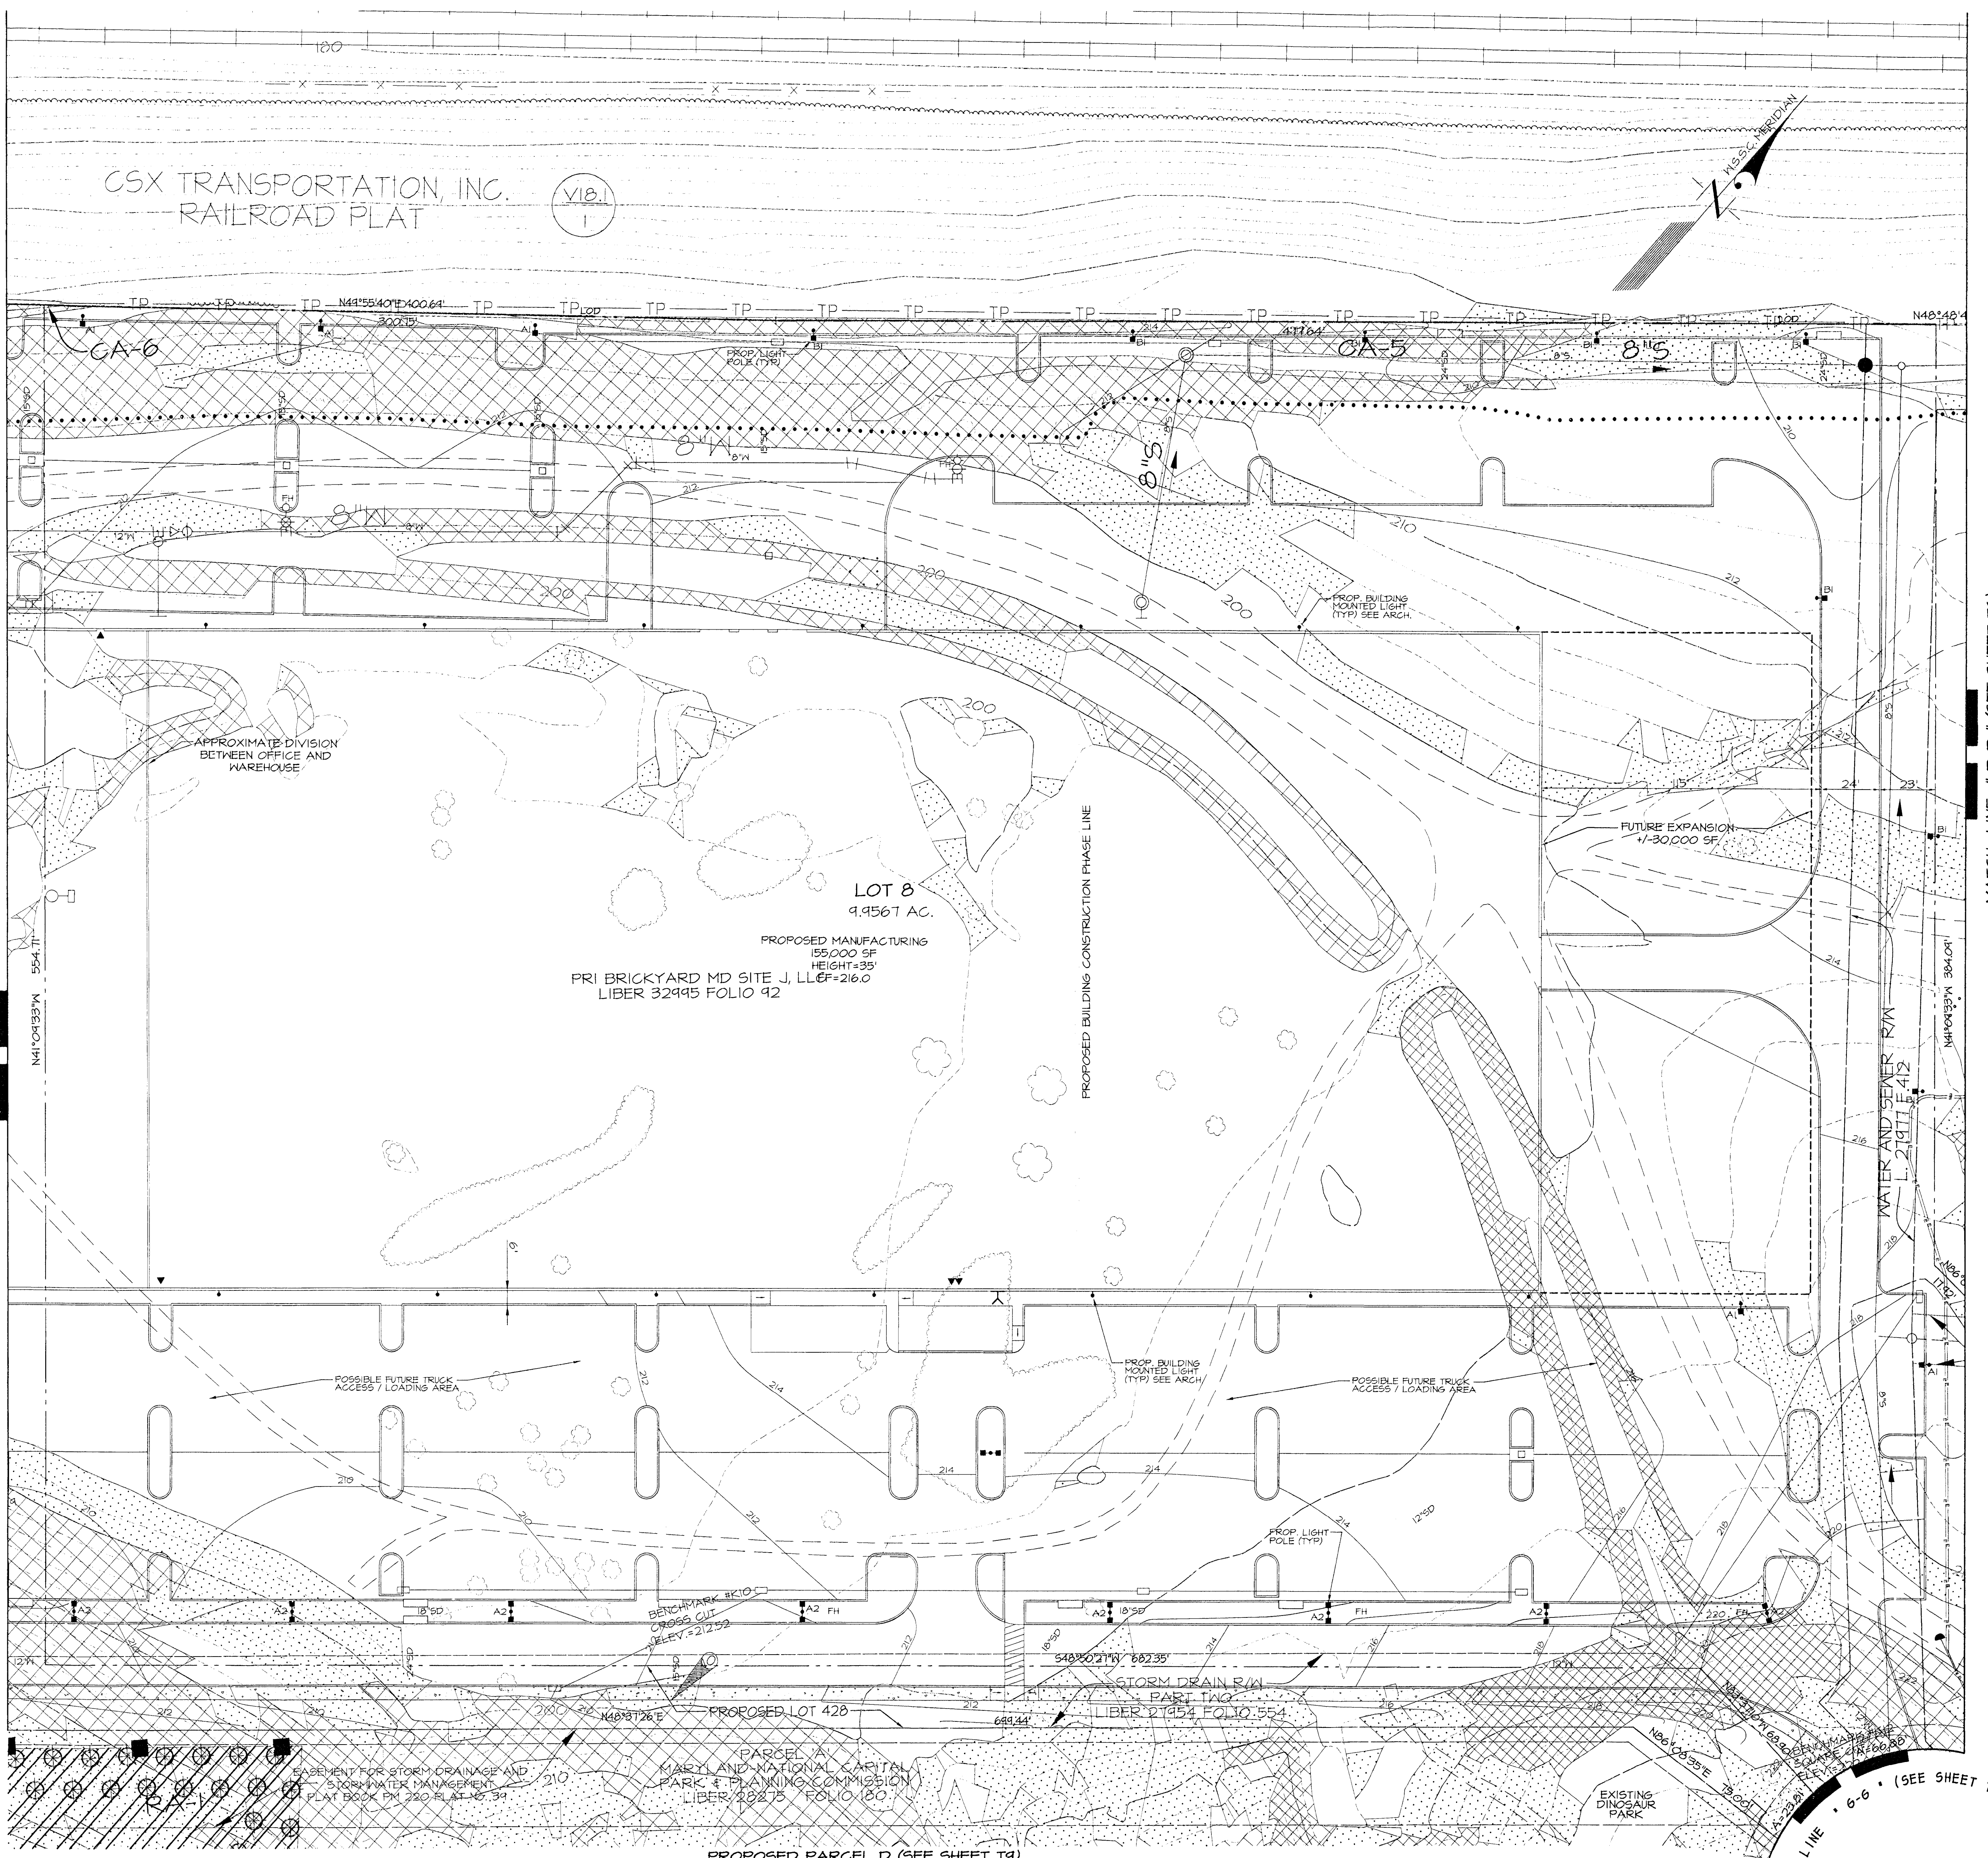

| M-NCPPC<br>Prince George's County Planning Department<br>Natural Resources Division |          |              |  |
|-------------------------------------------------------------------------------------|----------|--------------|--|
| APPROVAL<br>TREE CONSERVATION PLAN<br>TCP 2-118-05                                  |          |              |  |
| APPROVED BY                                                                         | DATE     | DSP          |  |
| Lori Shirley                                                                        | 8/15/07  | DSP-05024    |  |
| Lori Shirley                                                                        | 10/26/08 | DSP-05070    |  |
| Lori Shirley                                                                        | 5/4/07   | DSP-05070-01 |  |
| K. Shoulters                                                                        | 12/28/07 | DSP-07034    |  |
| K. Shoulters                                                                        | 5/20/10  | DSP-07034-01 |  |
| K. Shoulters                                                                        | 10/18/11 | DSP-07034-04 |  |
| K. Shoulters                                                                        | 6/19/12  | DSP-07034-04 |  |
| Megan K. Reiser                                                                     | 5/14/15  | DSP-05070-03 |  |
| K. Shoulters                                                                        | 8/24/14  | DSP-07034-06 |  |
| Megan K. Reiser                                                                     | 3/20/15  | DSP-07034-08 |  |

- LEGEND**
- PROPERTY BOUNDARY
  - EX. CONTOUR
  - PROP. CONTOUR
  - EX. TREELINE
  - LOD
  - MINING LIMITS
  - WATERS OF THE U.S.
  - NONTIDAL WETLAND
  - EX. WETLAND BUFFER (25')
  - TREE PROTECTION FENCE
  - PRESERVATION PROTECTION SIGNAGE
  - REFORESTATION PROTECTION SIGNAGE
  - 15" CALIPER REFORESTATION TREE
  - CLEARING AREA
  - PRESERVATION AREA
  - REFORESTATION AREA
  - 15 - 25% SLOPES (HIGHLY ERODIBLE SOILS)
  - 25% & GREATER SLOPES
  - SPECIMEN TREE WITH LIMITS OF CRITICAL ROOT ZONE (30" DBH OR GREATER)

| M.N.C.P.P.C. APPROVALS                                                 |               |                    |                |
|------------------------------------------------------------------------|---------------|--------------------|----------------|
| PROJECT NAME: THE BRICK YARD                                           |               |                    |                |
| PROJECT NUMBER: DSP-05070                                              |               |                    |                |
| For Conditions of Approval see Site Plan Cover Sheet or Approval Sheet |               |                    |                |
| Approval #                                                             | Approval Date | Approval Signature | Signature Date |
| 01                                                                     | 2/16/09       | K.J.N.             | 3/1/07         |
| 02                                                                     | 3/15/07       | L.S.               | 5/17/07        |
| 03                                                                     | 2/27/07       | C.L.               | 1/2/08         |

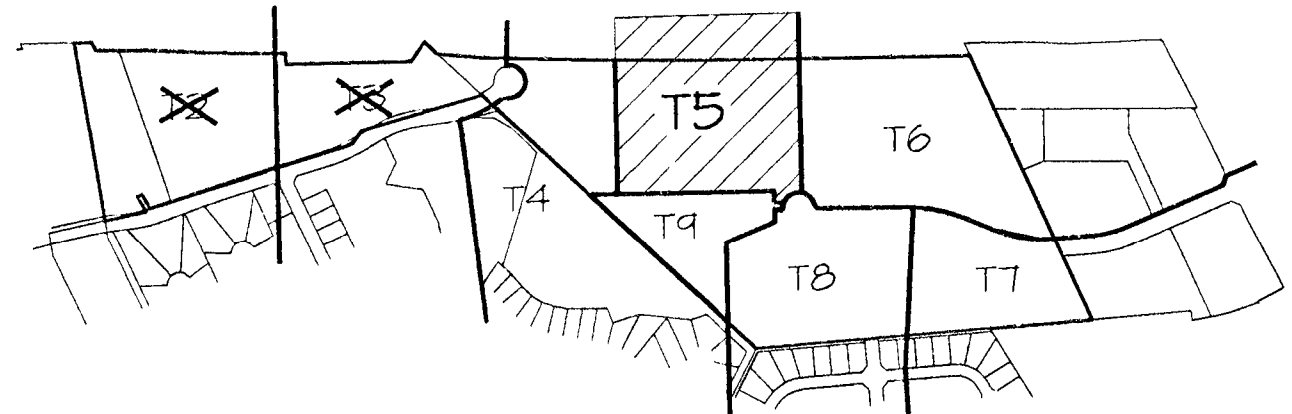

|   |   |
|---|---|
| THIS BLOCK IS FOR OFFICIAL USE ONLY. QR label certifies that this plan meets conditions of final approval by the Planning Board, its designee or the District Council. | THIS BLOCK IS FOR OFFICIAL USE ONLY. QR label certifies that this plan meets conditions of final approval by the Planning Board, its designee or the District Council. |
| <b>M-NCPPC APPROVAL</b>   | <b>M-NCPPC APPROVAL</b>   |
| PROJECT NAME: THE BRICK YARD SOUTH   | PROJECT NAME: THE BRICK YARD   |
| PROJECT NUMBER: DSP-07034/08   | PROJECT NUMBER: DSP-05070/03   |
| For Conditions of Approval see Site Plan Cover Sheet or Approval Sheet. Revision numbers must be included in the Project Number.                                       | For Conditions of Approval see Site Plan Cover Sheet or Approval Sheet. Revision numbers must be included in the Project Number.                                       |

TREE CONSERVATION PLAN - TYPE II  
**THE BRICK YARD NORTH**  
PROPOSED LOTS 20 - 27 & PARCELS 'B', 'C' & 'D'  
LAUREL DISTRICT No. 10  
PRINCE GEORGES COUNTY, MARYLAND

| DATE          | DESCRIPTION                                             | REVISIONS         | DATE          | DESCRIPTION                                             | REVISIONS         |
|---------------|---------------------------------------------------------|-------------------|---------------|---------------------------------------------------------|-------------------|
| 4-13-15       | Added previous TCP sheets from DSP05070 (Tn2)           |                   | 11-13-15      | Added previous TCP sheets from DSP05070 (Tn2)           |                   |
| 03-15-13      | REVISED BUILDING & LAYOUT ON LOT 8 AND 4                |                   | 03-15-13      | REVISED BUILDING & LAYOUT ON LOT 8 AND 4                |                   |
| 12-04-06      | Revised footprints for buildings 'D' and 'F'            |                   | 12-04-06      | Revised footprints for buildings 'D' and 'F'            |                   |
| 10-04-06      | Revised per EPS revision comments dated 9/1/06          |                   | 10-04-06      | Revised per EPS revision comments dated 9/1/06          |                   |
| 3-01-06       | Revised per DSP-05070 Resolution comments dated 2-21-06 |                   | 3-01-06       | Revised per DSP-05070 Resolution comments dated 2-21-06 |                   |
| DATE          | DESCRIPTION                                             | REVISIONS         | DATE          | DESCRIPTION                                             | REVISIONS         |
| APR 15, 2015  |                                                         |                   | APR 15, 2015  |                                                         |                   |
| Mike Petralis | Qualified Professional                                  | COMAR 08.19.06.01 | Mike Petralis | Qualified Professional                                  | COMAR 08.19.06.01 |

OWNER  
JACKSON SHAW / BRICKYARD LIMITED PARTNERSHIP, LLP  
4640 Forbes Boulevard, Suite 150-B  
Lanham, Maryland 20106  
301-424-1011  
ATTN: Thomas J. Aylward III

1721 WOODMORE ROAD, SUITE 200  
MITCHELLVILLE, MARYLAND 20721  
**BEN DYER ASSOCIATES, INC.**  
Engineers / Surveyors / Planners  
TELEPHONE (301) 430-2000

**O'DEA LYNCH ABBATTISTA CONSULTING ENGINEERS**  
NEW YORK • DALLAS  
4230 US Highway, Suite 625, Dallas, TX 75244  
417-239-8100 Fax 417-239-8102  
www.ola.com

LAW OFFICES  
**GIBBS AND HALLER**  
4640 FORBES BOULEVARD  
LANHAM, MARYLAND 20706  
(301) 424-1011  
gibbsandhaller.com

**O. R. GEORGE & ASSOCIATES, INC.**  
2000 N. Collins Blvd., Suite 1000  
Richardson, Texas 75080  
(972) 233-0400  
Fax: (972) 233-2259

THE  
**BRICK YARD**  
BELTSVILLE, MARYLAND

**JACKSON SHAW COMPANY**


**ALLIANCEARCHITECTS**  
1600 N. Collins Blvd., Suite 1000  
Richardson, Texas 75080  
(972) 233-0400  
Fax: (972) 233-2259

PROJECT NO.: 24237


**T5**

DATE: SEPTEMBER 28, 2005



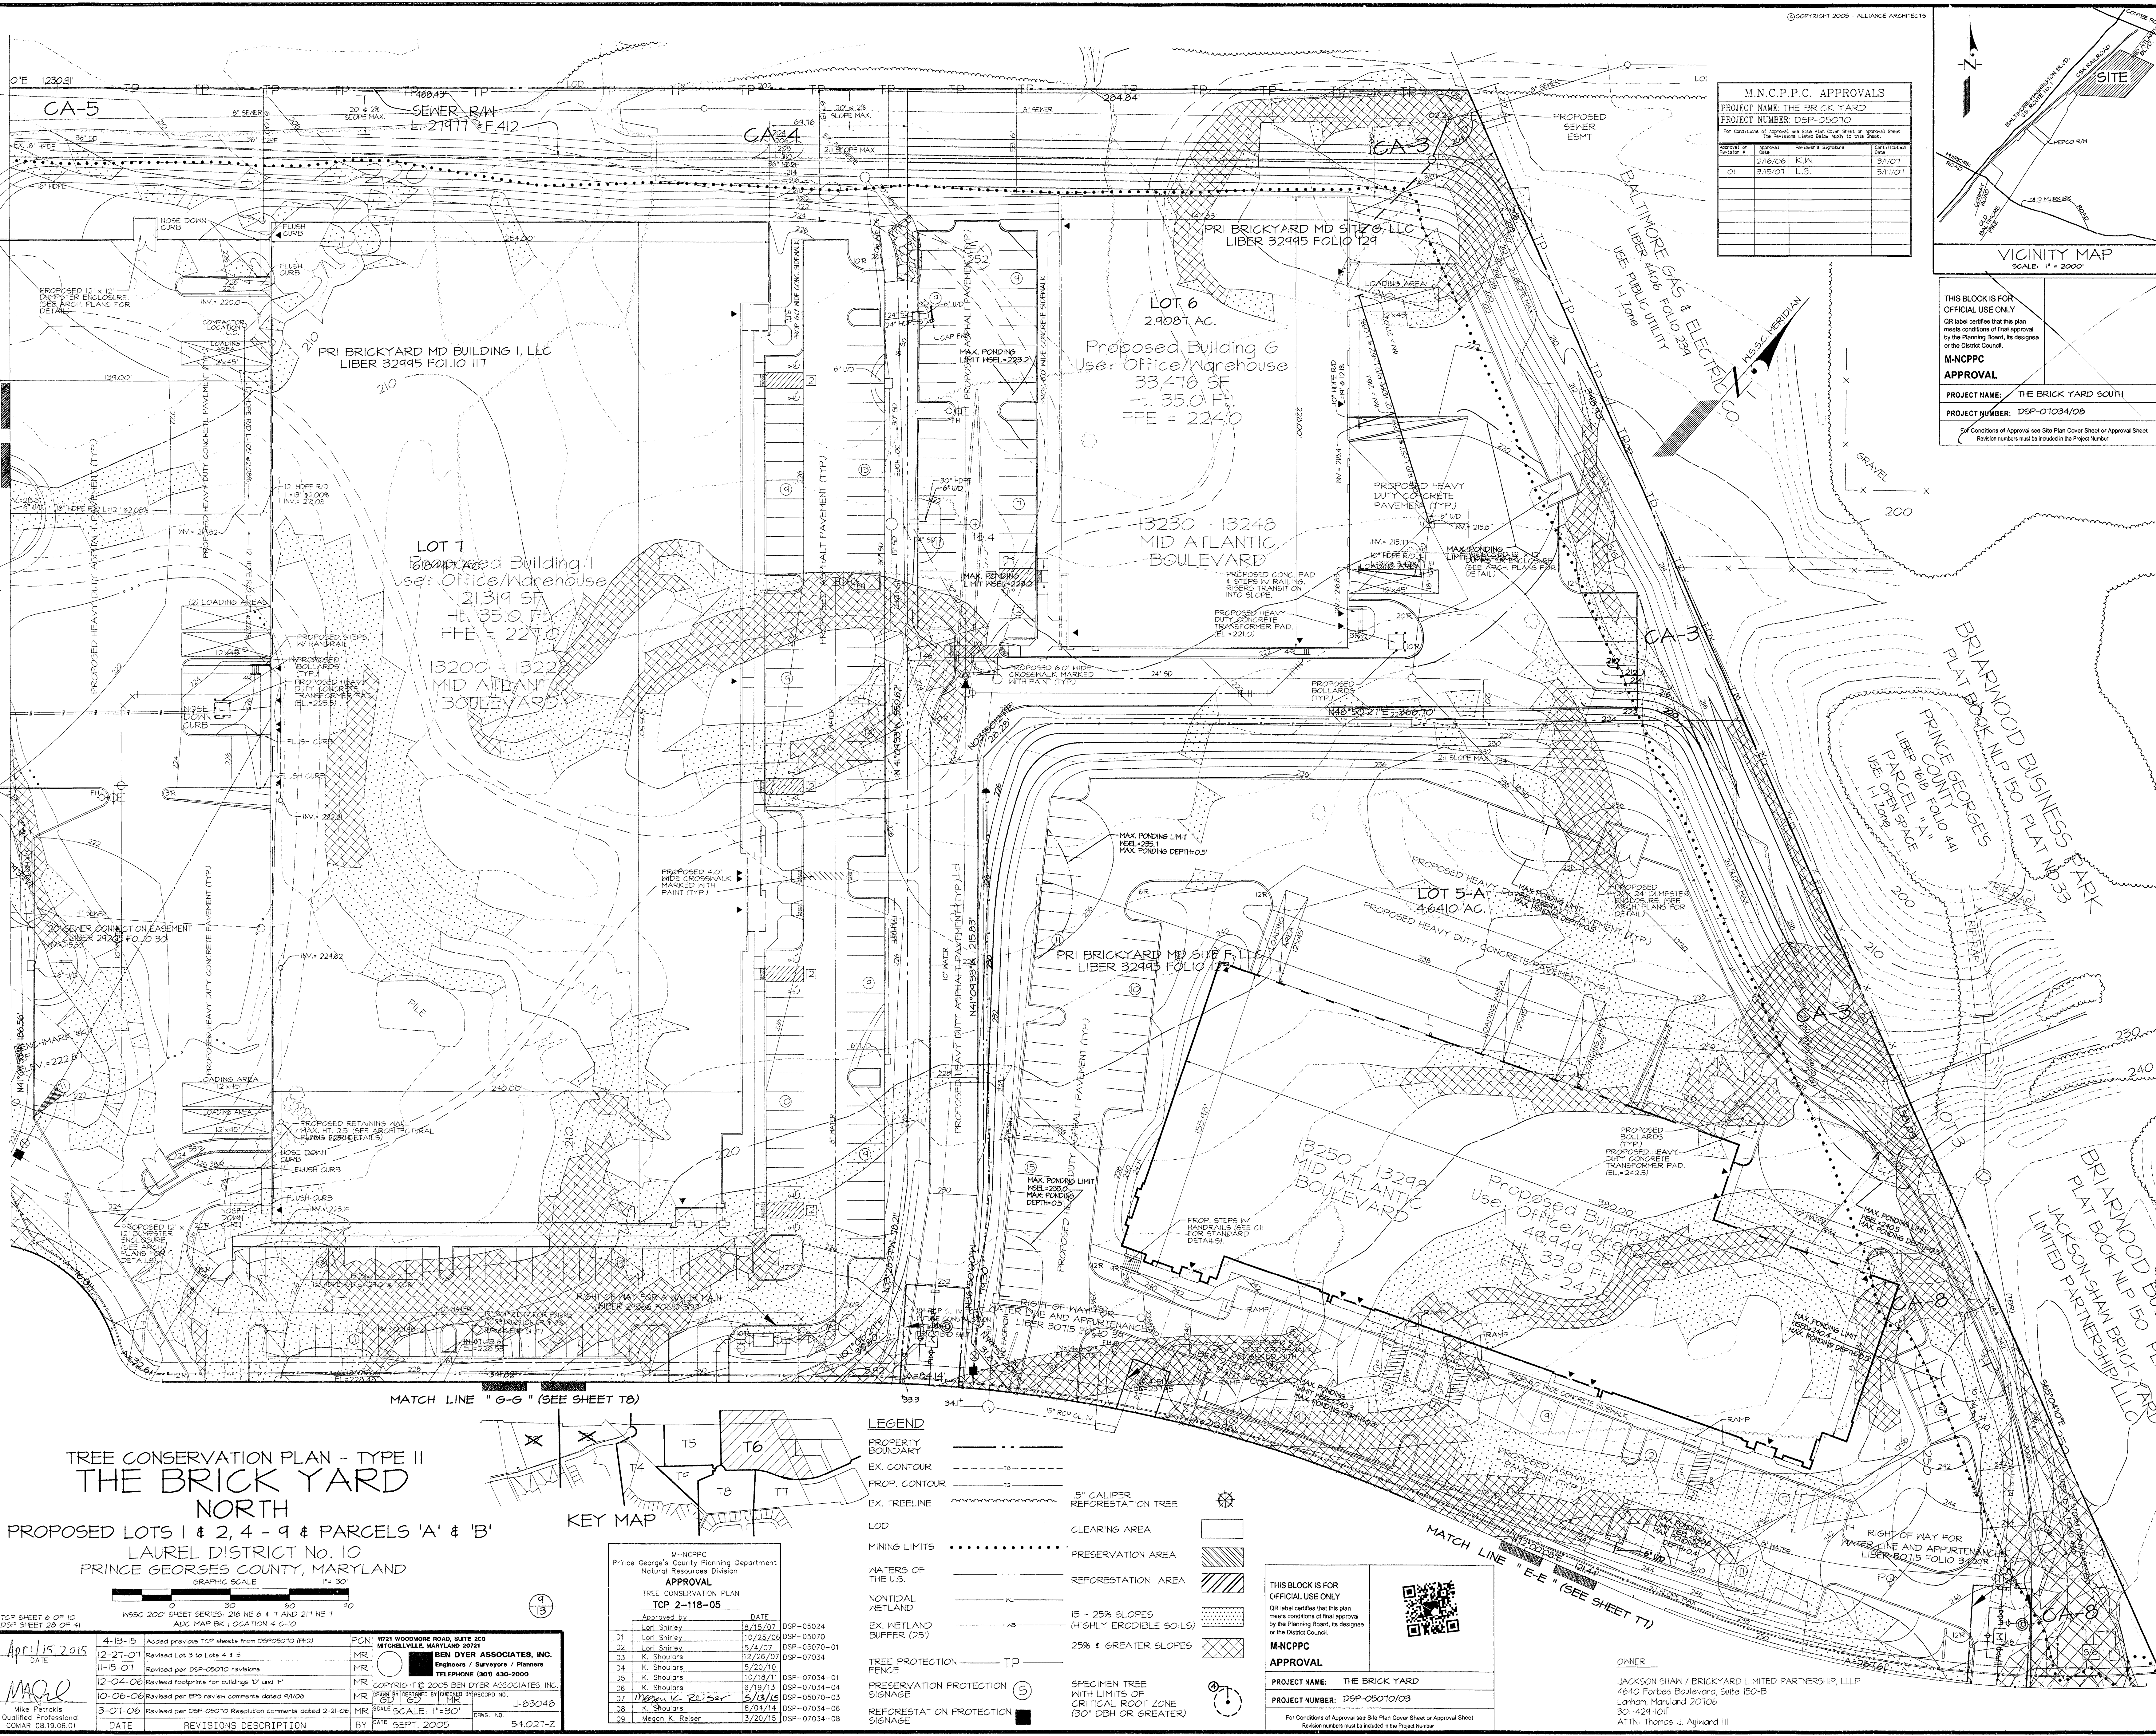

| M.N.C.P.C. APPROVALS                                                   |               |                      |                  |
|------------------------------------------------------------------------|---------------|----------------------|------------------|
| PROJECT NAME: THE BRICK YARD                                           |               |                      |                  |
| PROJECT NUMBER: DSP-05010                                              |               |                      |                  |
| For Conditions of Approval see Site Plan Cover Sheet or Approval Sheet |               |                      |                  |
| Approval #                                                             | Approval Date | Reviewer's Signature | Reviewer's Title |
| 01                                                                     | 2/16/06       | K. J. N.             | 3/1/01           |
| 01                                                                     | 3/15/07       | L. S.                | 5/11/01          |
|                                                                        |               |                      |                  |
|                                                                        |               |                      |                  |
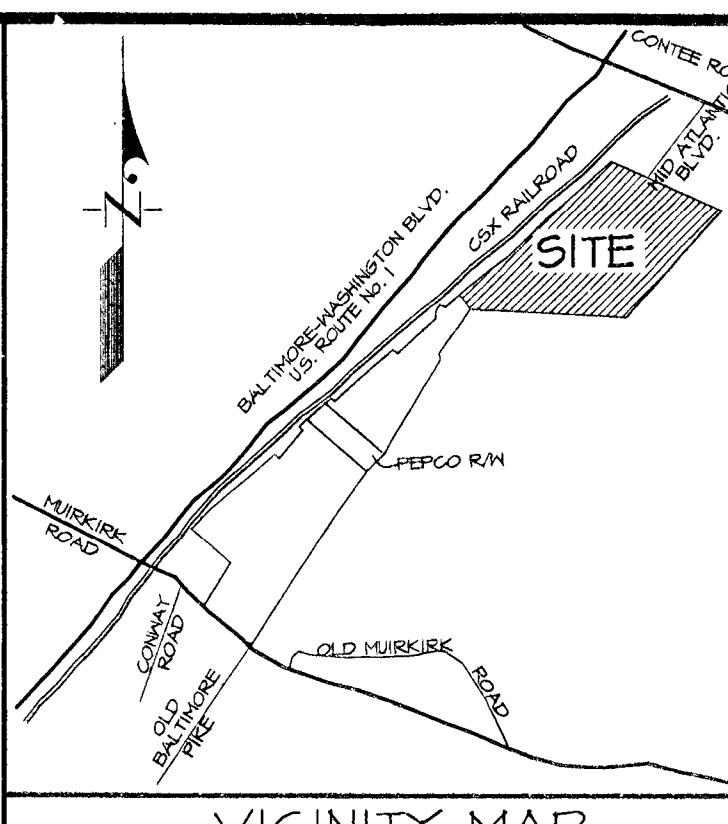

THIS BLOCK IS FOR OFFICIAL USE ONLY. On this certificate that this plan meets conditions of final approval by the Planning Board, its design or the District Council.

**M-NCPCC APPROVAL**

PROJECT NAME: THE BRICK YARD SOUTH

PROJECT NUMBER: DSP-07034/08

For Conditions of Approval see Site Plan Cover Sheet or Approval Sheet. Revision numbers must be included in the Project Number.

1721 WOODMERE ROAD, SUITE 200  
MITCHELLVILLE, MARYLAND 20701

**BEN DYER ASSOCIATES, INC.**  
Engineers / Surveyors / Planners  
TELEPHONE (301) 430-2000

**O'DIA LYNCH ABBATTISTA**  
CONSULTING ENGINEERS

Tel: 972.239.6100 Fax: 972.239.6102  
www.ola.com

LAW OFFICES  
**GIBBS AND HALLER**  
4640 Forbes Boulevard  
LANHAM, MARYLAND 20706  
Tel: 410.440.1100  
Fax: 410.440.1101  
gibbsandhaller.com

**O. R. GEORGE & ASSOCIATES, INC.**  
Traffic Engineers • Transportation Planners  
• Consultant to the State • Consultant to the County

**THE BRICK YARD**  
BELTSVILLE, MARYLAND

**JACKSON SHAW COMPANY**

**ALLIANCEARCHITECTS**  
1500 N. Collins Blvd., Suite 1000 (972) 233-0400  
Richardson, Texas 75080 Fax: (972) 233-2269

PROJECT NO.: 24237

**T6**

DATE: SEPTEMBER 28, 2005

**TREE CONSERVATION PLAN - TYPE II**  
**THE BRICK YARD**  
**NORTH**  
PROPOSED LOTS 1 & 2, 4 - 9 & PARCELS 'A' & 'B'  
LAUREL DISTRICT No. 10  
PRINCE GEORGES COUNTY, MARYLAND

GRAPHIC SCALE 1" = 30'

TCP SHEET 6 OF 10  
DSP SHEET 28 OF 41

4-13-15 Added previous TCP sheets from DSP-05010 (P2)  
12-21-07 Revised Lot 3 to Lots 4 & 5  
11-15-07 Revised per DSP-05010 revisions  
12-04-06 Revised footprints for buildings 'D' and 'F'  
10-06-06 Revised per EIS review comments dated 4/1/06  
3-07-06 Revised per DSP-05010 Resolution comments dated 2-21-06

PCN 1721 WOODMERE ROAD, SUITE 200  
MITCHELLVILLE, MARYLAND 20701  
BEN DYER ASSOCIATES, INC.  
Engineers / Surveyors / Planners  
TELEPHONE (301) 430-2000  
COPYRIGHT © 2005 BEN DYER ASSOCIATES, INC.  
BEN DYER ASSOCIATES, INC.  
TELEPHONE (301) 430-2000  
J-B3048  
SCALE: 1" = 30'  
DATE: 5/15/05  
BY: 54.021-Z

**LEGEND**

PROPERTY BOUNDARY  
EX. CONTOUR  
PROP. CONTOUR  
EX. TREELINE  
LOD  
MINING LIMITS  
WATERS OF THE U.S.  
NONTIDAL WETLAND  
EX. WETLAND BUFFER (25')  
TREE PROTECTION FENCE  
PRESERVATION PROTECTION SIGNAGE  
REFORESTATION PROTECTION SIGNAGE

1.5" CALIPER REFORESTATION TREE  
CLEARING AREA  
PRESERVATION AREA  
REFORESTATION AREA  
15 - 25% SLOPES  
(HIGHLY ERODIBLE SOILS)  
25% & GREATER SLOPES  
SPECIMEN TREE WITH LIMITS OF CRITICAL ROOT ZONE (30" DBH OR GREATER)

APPROVAL  
TREE CONSERVATION PLAN  
TCP 2-118-05  
Approved by: DATE  
Lori Shirley 8/15/07 DSP-05024  
Lori Shirley 10/25/07 DSP-05070  
Lori Shirley 5/24/07 DSP-05070-01  
K. Shoulters 12/28/07 DSP-07034  
K. Shoulters 5/20/10  
K. Shoulters 10/19/11 DSP-07034-01  
K. Shoulters 6/19/13 DSP-07034-04  
K. Shoulters 5/13/15 DSP-05070-03  
K. Shoulters 8/04/14 DSP-07034-06  
Megan K. Reiser 3/20/15 DSP-07034-09

THIS BLOCK IS FOR OFFICIAL USE ONLY. On this certificate that this plan meets conditions of final approval by the Planning Board, its design or the District Council.

**M-NCPCC APPROVAL**

PROJECT NAME: THE BRICK YARD

PROJECT NUMBER: DSP-05010/03

For Conditions of Approval see Site Plan Cover Sheet or Approval Sheet. Revision numbers must be included in the Project Number.


OWNER  
JACKSON SHAW / BRICKYARD LIMITED PARTNERSHIP, LLP  
4640 Forbes Boulevard, Suite 150-B  
Lanham, Maryland 20706  
301-424-1011  
ATTN: Thomas J. Aylward III








© COPYRIGHT 2005 - ALLIANCE ARCHITECTS

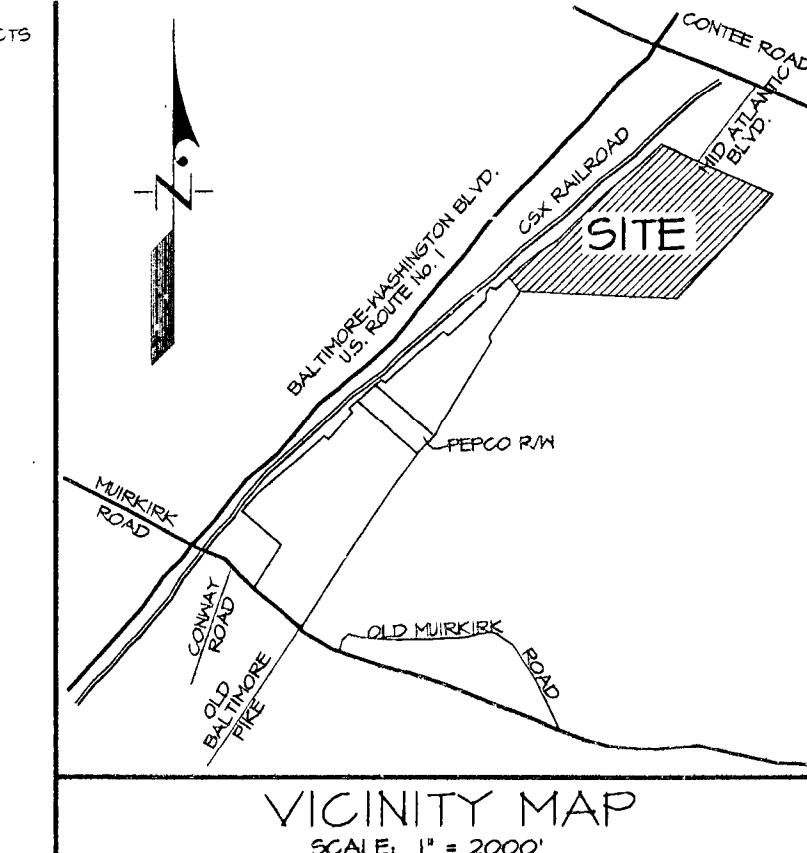

- LEGEND**
- PROPERTY BOUNDARY
  - EX. CONTOUR
  - PROP. CONTOUR
  - EX. TREELINE
  - LOD
  - MINING LIMITS
  - WATERS OF THE U.S.
  - NONTIDAL WETLAND
  - EX. WETLAND BUFFER (25')
  - TREE PROTECTION FENCE
  - PRESERVATION PROTECTION SIGNAGE
  - REFORESTATION PROTECTION SIGNAGE
  - CLEARING AREA
  - PRESERVATION AREA
  - REFORESTATION AREA
  - 15 - 25% SLOPES (HIGHLY ERODIBLE SOILS)
  - 25% & GREATER SLOPES
  - SPECIMEN TREE WITH LIMITS OF CRITICAL ROOT ZONE (30" DBH OR GREATER)

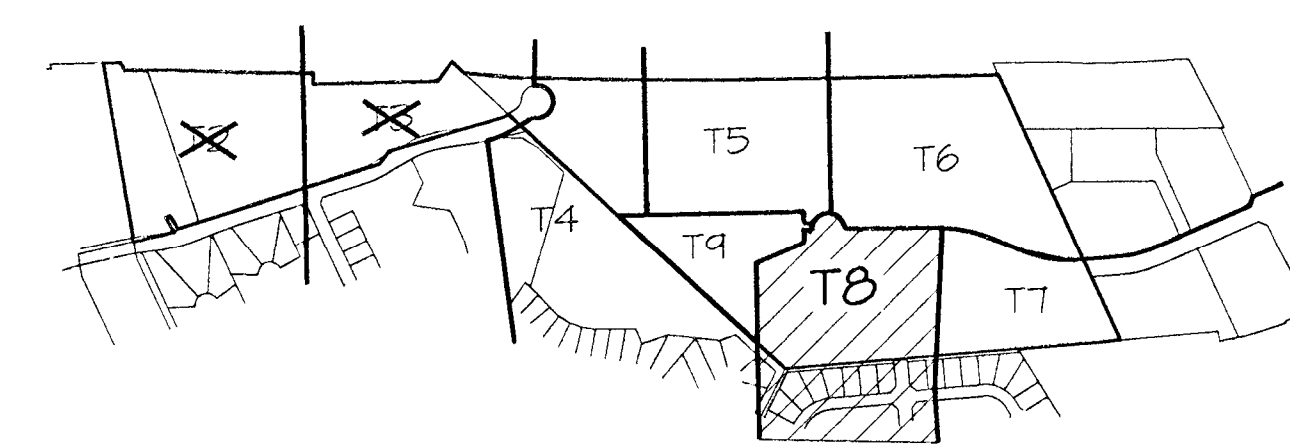

KEY MAP

| M.N.C.P.P.C. APPROVALS                                                 |               |                    |               |
|------------------------------------------------------------------------|---------------|--------------------|---------------|
| PROJECT NAME: THE BRICK YARD                                           |               |                    |               |
| PROJECT NUMBER: DSP-05070                                              |               |                    |               |
| For Conditions of Approval see Site Plan Cover Sheet or Approval Sheet |               |                    |               |
| Approval #                                                             | Approval Date | Approval Signature | Approval Date |
| 01                                                                     | 2/16/06       | K. J. N.           | 3/1/07        |
| M-NCPPC APPROVAL                                                       |               |                    |               |
| PROJECT NAME: THE BRICK YARD SOUTH                                     |               |                    |               |
| PROJECT NUMBER: DSP-07034/08                                           |               |                    |               |
| For Conditions of Approval see Site Plan Cover Sheet or Approval Sheet |               |                    |               |
| Revision numbers must be included in the Project Number                |               |                    |               |

| M-NCPPC                                    |          |              |  |
|--------------------------------------------|----------|--------------|--|
| Prince George's County Planning Department |          |              |  |
| Natural Resources Division                 |          |              |  |
| APPROVAL                                   |          |              |  |
| TREE CONSERVATION PLAN                     |          |              |  |
| TOP 2-118-05                               |          |              |  |
| Approved by                                | DATE     | DSP-05024    |  |
| Lori Shirley                               | 2/15/07  | DSP-05070    |  |
| Lori Shirley                               | 10/25/06 | DSP-05070-01 |  |
| K. Shoulters                               | 5/4/07   | DSP-07034    |  |
| K. Shoulters                               | 12/28/07 | DSP-07034    |  |
| K. Shoulters                               | 5/20/10  | DSP-07034-01 |  |
| K. Shoulters                               | 10/18/11 | DSP-07034-04 |  |
| K. Shoulters                               | 6/19/13  | DSP-07034-06 |  |
| K. Shoulters                               | 5/15/15  | DSP-07034-08 |  |
| Megan K. Reiser                            | 3/20/15  | DSP-07034-08 |  |

**TREE CONSERVATION PLAN - TYPE II**  
**THE BRICK YARD**  
**NORTH**  
**PROPOSED LOTS 20 - 27 & PARCELS 'B', 'C' & 'D'**  
**LAUREL DISTRICT NO. 1**  
**PRINCE GEORGES COUNTY, MARYLAND**

|                                                   |  |                        |  |                                            |  |
|---------------------------------------------------|--|------------------------|--|--------------------------------------------|--|
| OWNER                                             |  | DATE                   |  | 1731 WOODMORE ROAD, SUITE 200              |  |
| JACKSON SHAW / BRICKYARD LIMITED PARTNERSHIP, LLP |  | APRIL 15, 2015         |  | MIDTOWNVILLE, MARYLAND 20721               |  |
| 4640 Forbes Boulevard, Suite 150-B                |  | Mike Petrakis          |  | BEN DYER ASSOCIATES, INC.                  |  |
| Laurel, Maryland 20706                            |  | Qualified Professional |  | Engineers / Surveyors / Planners           |  |
| 301-424-1011                                      |  | 04/15/2015             |  | TELEPHONE (301) 430-2000                   |  |
| ATTN: Thomas J. Aylward III                       |  | DATE                   |  | FAX (301) 430-2000                         |  |
|                                                   |  | DESCRIPTION            |  | COPYRIGHT © 2005 BEN DYER ASSOCIATES, INC. |  |
|                                                   |  | REVISIONS              |  | J-8304B                                    |  |
|                                                   |  |                        |  | SCALE: 1"=30'                              |  |
|                                                   |  |                        |  | DATE: SEPT. 2005                           |  |
|                                                   |  |                        |  | 3RD NO. 54,024-Z                           |  |

1731 WOODMORE ROAD, SUITE 200  
MIDTOWNVILLE, MARYLAND 20721

**BEN DYER ASSOCIATES, INC.**  
Engineers / Surveyors / Planners  
TELEPHONE (301) 430-2000

**O'DEA LYNCH ABBATTISTA**  
CONSULTING ENGINEERS

NEW YORK • DALLAS  
4230 W. Freeway, Suite 100, Dallas, TX 75244  
Tel: 972.229.5150 Fax: 972.229.5102  
www.ola.com

LAW OFFICES  
**GIBBS AND HALLER**  
6640 FORBES BOULEVARD  
LANHAM, MARYLAND 20706  
Tel: 410.321.1000  
gibbsandhaller.com

**O. R. GEORGE & ASSOCIATES, INC.**  
Traffic Engineers - Transportation Planners  

**THE BRICK YARD**  
BELTSVILLE, MARYLAND

**JACKSON SHAW COMPANY**


**ALLIANCE ARCHITECTS**  
1600 N. Collins Blvd., Suite 1000 (972) 233-0400  
Richardson, Texas 75080 Fax: (972) 233-2259

PROJECT NO.: 24237

**T8**

DATE: SEPTEMBER 28, 2005



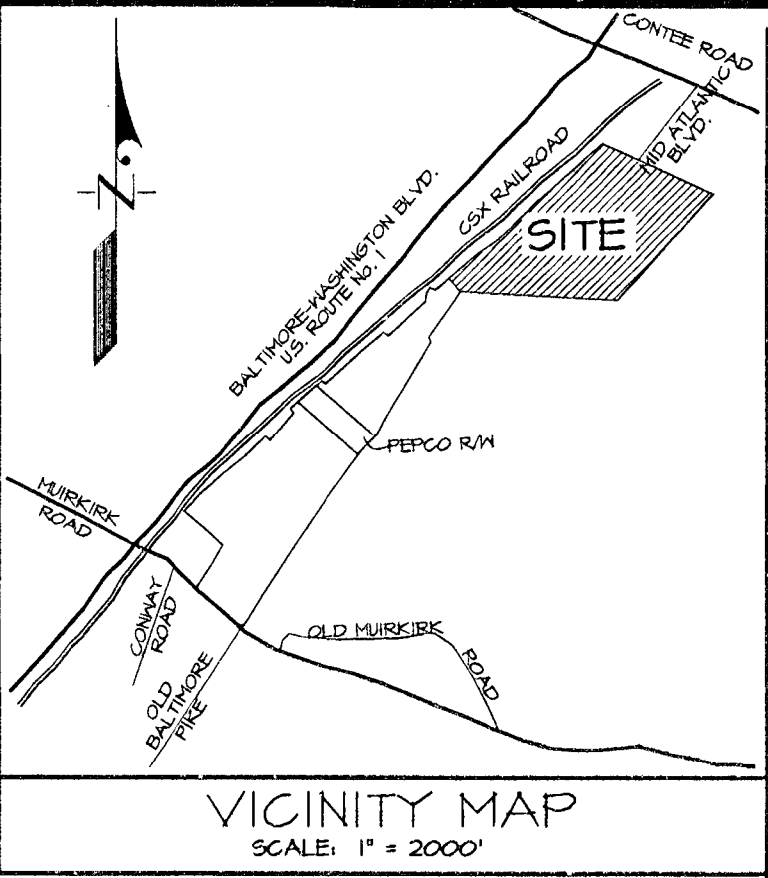

#### LEGEND

- PROPERTY BOUNDARY
- EX. CONTOUR
- PROP. CONTOUR
- EX. TREELINE
- LOD
- MINING LIMITS
- WATERS OF THE U.S.
- WETLAND
- EX. WETLAND BUFFER (25')
- TREE PROTECTION FENCE
- PRESERVATION PROTECTION SIGNAGE
- REFORESTATION PROTECTION SIGNAGE
- 15' CALIPER REFORESTATION TREE
- CLEARING AREA
- PRESERVATION AREA
- REFORESTATION AREA
- 15 - 25% SLOPES (HIGHLY ERODIBLE SOILS)
- 25% & GREATER SLOPES
- SPECIMEN TREE WITH LIMITS OF CRITICAL ROOT ZONE (30" DBH OR GREATER)

17721 WOODMORE ROAD, SUITE 200  
MITCHELLVILLE, MARYLAND 20721  
**BEN DYER ASSOCIATES, INC.**  
Engineers / Surveyors / Planners  
TELEPHONE (301) 430-2000

**O'DEA LYNCH ABBATTISTA**  
CONSULTING ENGINEERS


LAW OFFICES  
**GIBBS AND HALLER**  
6440 FORBES BOULEVARD  
LANHAM, MARYLAND 20706  
Tel: 410.336.0100 Fax: 410.336.0101

**O. R. GEORGE & ASSOCIATES, INC.**  
Traffic Engineers / Transportation Planners  
11000 N. Collins Blvd., Suite 1000  
Richardson, Texas 75080  
Tel: (972) 233-0400 Fax: (972) 233-2259

**THE BRICK YARD**  
BELTSVILLE, MARYLAND

**JACKSON SHAW COMPANY**

**ALLIANCE ARCHITECTS**  
1500 N. Collins Blvd., Suite 1000  
Richardson, Texas 75080  
(972) 233-0400  
Fax: (972) 233-2259

PROJECT NO.: 24237

DATE: SEPTEMBER 28, 2005

**T9**



| M.N.C.P.C. APPROVALS   |               |                      |                    |
|---|---------------|----------------------|--------------------|
| PROJECT NAME: THE BRICK YARD   |               |                      |                    |
| PROJECT NUMBER: DSP-05070   |               |                      |                    |
| For Conditions of Approval see Site Plan Cover Sheet or Approval Sheet. Revision numbers must be included in the Project Number. |               |                      |                    |
| Approval Number   | Approval Date | Reviewer's Signature | Certification Date |
| 01   | 2/6/06        | K. A.                | 3/1/07             |
| 02   |               |                      |                    |
| 03   |               |                      |                    |
| 04   |               |                      |                    |
| 05   |               |                      |                    |
| 06   |               |                      |                    |
| 07   |               |                      |                    |
| 08   |               |                      |                    |
| 09   |               |                      |                    |

| M-NCPCC APPROVAL                                                         |                 |          |              |
|--------------------------------------------------------------------------|-----------------|----------|--------------|
| Prince George's County Planning Department<br>Natural Resources Division |                 |          |              |
| TREE CONSERVATION PLAN                                                   |                 |          |              |
| TCP 2-118-05                                                             |                 |          |              |
| Approved by: DATE                                                        |                 |          |              |
| 01                                                                       | Lori Shirley    | 8/15/07  | DSP-05024    |
| 02                                                                       | Lori Shirley    | 10/25/08 | DSP-05070    |
| 03                                                                       | K. Shoulers     | 5/4/07   | DSP-05070-01 |
| 04                                                                       | K. Shoulers     | 12/28/07 | DSP-07034    |
| 05                                                                       | K. Shoulers     | 5/20/10  | DSP-07034-01 |
| 06                                                                       | K. Shoulers     | 10/18/11 | DSP-07034-04 |
| 07                                                                       | Megan K. Reiser | 5/2/15   | DSP-05070-03 |
| 08                                                                       | K. Shoulers     | 8/04/14  | DSP-07034-06 |
| 09                                                                       | Megan K. Reiser | 5/20/15  | DSP-07034-08 |

THIS BLOCK IS FOR OFFICIAL USE ONLY  
QR label certifies that this plan meets conditions of final approval by the Planning Board, its designee, or the District Council.

**M-NCPCC APPROVAL**

PROJECT NAME: THE BRICK YARD SOUTH

PROJECT NUMBER: DSP-07034/08

For Conditions of Approval see Site Plan Cover Sheet or Approval Sheet. Revision numbers must be included in the Project Number.

THIS BLOCK IS FOR OFFICIAL USE ONLY  
QR label certifies that this plan meets conditions of final approval by the Planning Board, its designee, or the District Council.

**M-NCPCC APPROVAL**



PROJECT NAME: THE BRICK YARD

PROJECT NUMBER: DSP-05070/03

For Conditions of Approval see Site Plan Cover Sheet or Approval Sheet. Revision numbers must be included in the Project Number.

## TREE CONSERVATION PLAN - TYPE II THE BRICK YARD NORTH

PROPOSED LOTS 20 - 27 & PARCELS 'B', 'C' & 'D'  
LAUREL DISTRICT No. 10  
PRINCE GEORGES COUNTY, MARYLAND

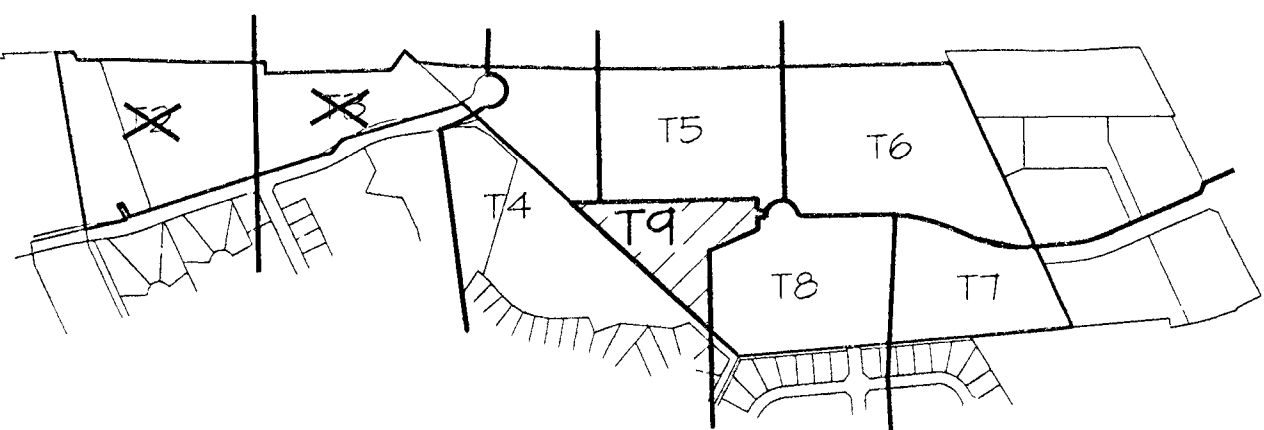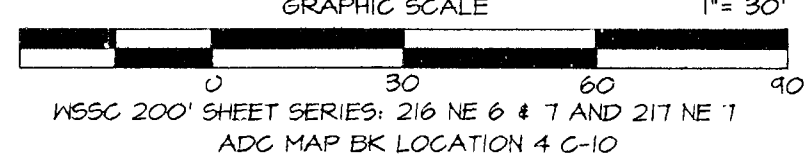

KEY MAP

OWNER

JACKSON SHAW / BRICKYARD LIMITED PARTNERSHIP, LLLP  
4640 Forbes Boulevard, Suite 150-B  
Lanham, Maryland 20706  
301-424-0101  
ATTN: Thomas J. Ajward III

TCP SHEET 9 OF 10  
DSP SHEET 31 OF 41

April 13, 2015  
DATE  
Mike Petrakis  
Qualified Professional  
COMAR 08.19.06.01


| DATE     | DESCRIPTION                                             | REVISIONS |
|----------|---------------------------------------------------------|-----------|
| 4-13-15  | Added previous TCP sheets from DSP05070 (T92)           | PCN       |
| 10-06-06 | Revised per EPR review comments dated 9/10/06           | MR        |
| 3-07-06  | Revised per DSP-05070 Resolution comments dated 2-21-06 | MR        |

17721 WOODMORE ROAD, SUITE 200  
MITCHELLVILLE, MARYLAND 20721  
**BEN DYER ASSOCIATES, INC.**  
Engineers / Surveyors / Planners  
TELEPHONE (301) 430-2000  
COPYRIGHT © 2005 BEN DYER ASSOCIATES, INC.  
DRAWN BY: J. D. B. (JDB) CHECKED BY: J. D. B. (JDB)  
SCALE: 1"=30'  
DATE: SEPT. 2005  
SHEET NO.: 54.030-Z







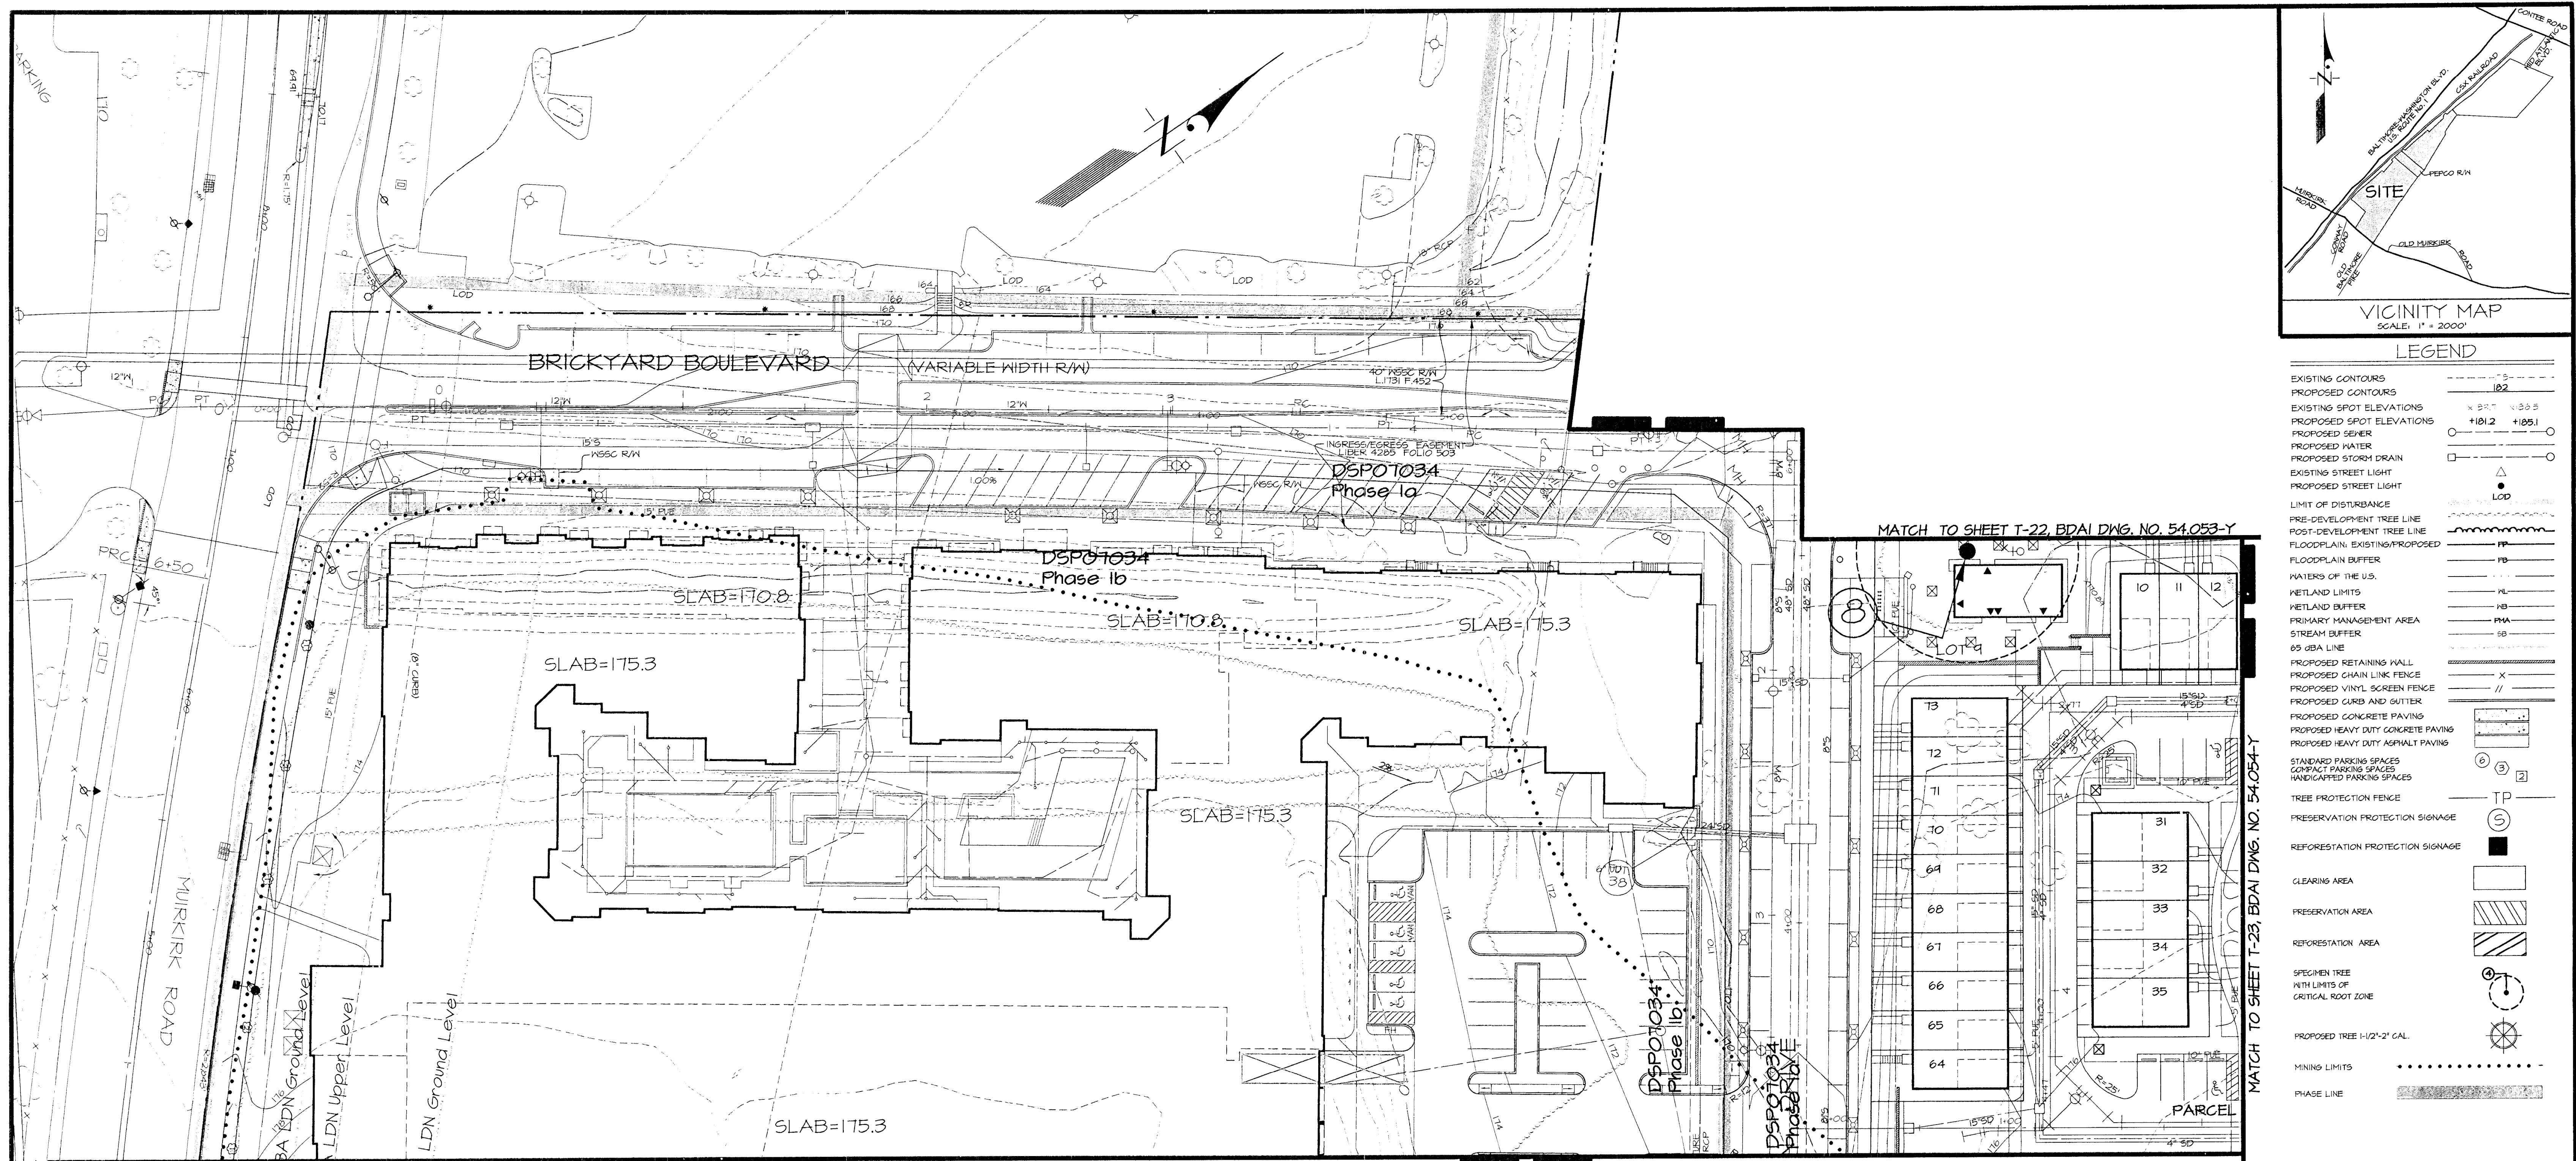

# LEGEND

|                                                       |  |
|-------------------------------------------------------|--|
| EXISTING CONTOURS                                     |  |
| PROPOSED CONTOURS                                     |  |
| EXISTING SPOT ELEVATIONS                              |  |
| PROPOSED SPOT ELEVATIONS                              |  |
| PROPOSED SEWER                                        |  |
| PROPOSED WATER                                        |  |
| PROPOSED STORM DRAIN                                  |  |
| EXISTING STREET LIGHT                                 |  |
| PROPOSED STREET LIGHT                                 |  |
| LIMIT OF DISTURBANCE                                  |  |
| PRE-DEVELOPMENT TREE LINE                             |  |
| POST-DEVELOPMENT TREE LINE                            |  |
| FLOODPLAIN, EXISTING/PROPOSED                         |  |
| FLOODPLAIN BUFFER                                     |  |
| WATERS OF THE U.S.                                    |  |
| KETLAND LIMITS                                        |  |
| KETLAND BUFFER                                        |  |
| PRIMARY MANAGEMENT AREA                               |  |
| STREAM BUFFER                                         |  |
| 65 DBA LINE                                           |  |
| PROPOSED RETAINING WALL                               |  |
| PROPOSED CHAIN LINK FENCE                             |  |
| PROPOSED VINYL SCREW FENCE                            |  |
| PROPOSED CURB AND GUTTER                              |  |
| PROPOSED CONCRETE PAVING                              |  |
| PROPOSED HEAVY DUTY CONCRETE PAVING                   |  |
| PROPOSED HEAVY DUTY ASPHALT PAVING                    |  |
| STANDARD PARKING SPACES                               |  |
| COMPACT PARKING SPACES                                |  |
| HANDICAPPED PARKING SPACES                            |  |
| TREE PROTECTION FENCE                                 |  |
| PRESERVATION PROTECTION SIGNAGE                       |  |
| REFORESTATION PROTECTION SIGNAGE                      |  |
| CLEARING AREA                                         |  |
| PRESERVATION AREA                                     |  |
| REFORESTATION AREA                                    |  |
| SPECIMEN TREE<br>WITH LIMITS OF<br>CRITICAL ROOT ZONE |  |
| PROPOSED TREE 1-1/2" x 2" GAL.                        |  |
| MINING LIMITS                                         |  |
| PHASE I LINE                                          |  |

CALL MISS UTILITY  
1-800-257-7777  
48 hrs, Before Excavation

|          |                                                 |     |
|----------|-------------------------------------------------|-----|
| 1/04/15  | Revised grading per clients request.            | PCN |
| 6/12/14  | Revised to redesign clubhouse and sound wall.   | PCN |
| 11/4/13  | REVISED TO COMFORM WITH D5P0T034-06             | PCN |
| 05/16/13 | REVISED TO COMFORM WITH D5P050T0-03             | PCN |
| 04/21/12 | REVISED TO COMFORM WITH D5P0T034-02             | PCN |
| 06/26/11 | REVISED ARCH, COURTYARDS, & PARKING ON PARCEL B | JRD |
| DATE     | REVISIONS DESCRIPTION                           | BY  |

|   |                                                                                       |
|---|---------------------------------------------------------------------------------------|
| <p><b>THIS BLOCK IS FOR<br/>OFFICIAL USE ONLY</b></p> <p>GRS certifies that this plan<br/>meets conditions of final approval<br/>by the Planning Board, its designee<br/>or the District Council.</p> |  |
| <p><b>M-NCPPC<br/>APPROVAL</b></p>   |                                                                                       |
| <p><b>PROJECT NAME:</b></p>   | <p><b>THE BRICK YARD</b></p>                                                          |
| <p><b>PROJECT NUMBER:</b></p>   | <p><b>DSP-05010/03</b></p>                                                            |
| <p>For Conditions of Approval see Site Plan Cover Sheet or Approval Sheet<br/>Revision numbers must be included in the Project Number</p>                                                             |                                                                                       |


|   |                             |
|---|-----------------------------|
| <p><b>THIS BLOCK IS FOR<br/>OFFICIAL USE ONLY</b></p> <p>Get latest certified that this plan meets conditions of final approval by the Planning Board, its delegates or the District Council.</p> |                             |
| <p><b>M-NCPPC<br/>APPROVAL</b></p>   |                             |
| <p><b>PROJECT NAME:</b></p>   | <p>THE BRICK YARD SOUTH</p> |
| <p><b>PROJECT NUMBER:</b></p>   | <p>DSP-01034/08</p>         |
| <p>For Conditions of Approval see Site Plan Cover Sheet or Approval Sheet<br/>         Review numbers must be included in the Project Number</p>                                                  |                             |

[illegible]

|                                            |                         |          |              |
|--------------------------------------------|-------------------------|----------|--------------|
| M-NPPRC                                    |                         |          |              |
| Prince George's County Planning Department |                         |          |              |
| Natural Resources Division                 |                         |          |              |
| <b>APPROVAL</b>                            |                         |          |              |
| TREE CONSERVATION PLAN                     |                         |          |              |
| <b><u>TCP 2-118-05</u></b>                 |                         |          |              |
| Approved by:                               |                         | DATE     |              |
|                                            | Lori Shirley            | 8/15/07  | DSP-05024    |
| 01                                         | Lori Shirley            | 10/25/06 | DSP-05070    |
| 02                                         | Lori Shirley            | 5/4/07   | DSP-05070-01 |
| 03                                         | K. Shoulers             | 12/28/07 | DSP-07034    |
| 04                                         | K. Shoulers             | 5/20/10  |              |
| 05                                         | K. Shoulers             | 10/18/11 | DSP-07034-01 |
| 06                                         | K. Shoulers             | 6/19/13  | DSP-07034-04 |
| 07                                         | <i>Meghan K. Reiser</i> | 5/3/15   | DSP-05070-03 |
| 08                                         | K. Shoulers             | 8/24/14  | DSP-07034-06 |
| 09                                         | Meghan K. Reiser        | 3/10/15  | DSP-07034-08 |

OWNER  
JACKSON SHAW / BRICKYARD  
LIMITED PARTNERSHIP, LLLP  
4640 Forbes Boulevard, Suite 150-B  
Lanham, Maryland 20706  
301-429-1011  
ATTN: Thomas J. Aylward III

TREE CONSERVATION PLAN, TYPE II  
THE BRICK YARD  
MARC PLANNED COMMUNITY  
PROPOSED LOTS 9-440 &  
PARCELS 'B' TO 'Z' & 'AA' TO 'WW'  
LAUREL DISTRICT No. 10  
PRINCE GEORGES COUNTY, MARYLAND  
N55C 200' SHEET SERIES: 216 NE 6 & 7 AND 217 NE 7  
ADC MAP BK LOCATION 4 G-10

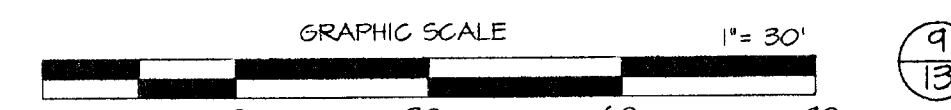

T-19  
TCP SHEET 2 OF 13

April 15, 2015  
DATE

*MAR*

Mike Petroski  
Qualified Professional  
COMAR 08.19.06.01

| DATE    | DESCRIPTION                                    | REVISIONS |
|---------|------------------------------------------------|-----------|
| 7-23-04 | Revised to create subphases for South D5P07034 | PCN       |
| 4-4-08  | Revised per staff required layout changes.     | CW        |
| 3-21-08 | Revised per M-NCPPC comments received 3-1-08   | DM        |
| 2/14/08 | UPDATED WETLANDS / STREAM FEATURES             | MB        |
| 2/6/08  | QUIFIED PER M-NCPPC 1-11-08 COMMENTS           | MB        |

1721 WOODMOORE ROAD, SUITE 200  
MCKEILLVILLE, MARYLAND 20721


**BEN DYER ASSOCIATES, INC.**  
Engineers / Surveyors / Planners  
TELEPHONE (301) 430-2000  
COPYRIGHT © 2001 BEN DYER ASSOCIATES, INC.  
DRAWN BY / DESIGNED BY / CHECKED BY / RECORDED NO.

SCALE 1"=30'  
DATE MAY 2007

DRWG. NO. 8-30C48  
54.050-Y

X:\17-DP01\830148-LD7\sheet\TCPII-07034-south.dwg, 4/13/2015 2:48:30 PM, nicpaw



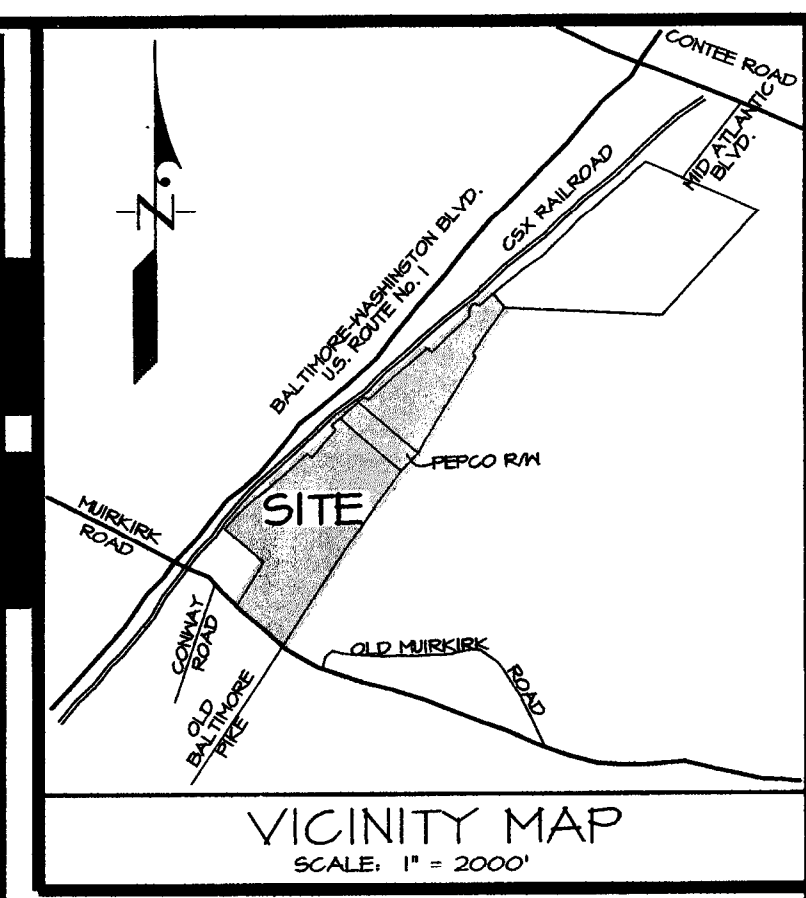

| LEGEND                                          |               |
|-------------------------------------------------|---------------|
| EXISTING CONTOURS                               | - - - - -     |
| PROPOSED CONTOURS                               | — — — — —     |
| EXISTING SPOT ELEVATIONS                        | x184.7 x188.5 |
| PROPOSED SPOT ELEVATIONS                        | x181.2 x185.1 |
| PROPOSED SEWER                                  | — — — — —     |
| PROPOSED WATER                                  | — — — — —     |
| PROPOSED STORM DRAIN                            | — — — — —     |
| EXISTING STREET LIGHT                           | △             |
| PROPOSED STREET LIGHT                           | △             |
| LIMIT OF DISTURBANCE                            | — — — — —     |
| PRE-DEVELOPMENT TREE LINE                       | — — — — —     |
| POST-DEVELOPMENT TREE LINE                      | — — — — —     |
| FLOODPLAIN, EXISTING/PROPOSED                   | — — — — —     |
| FLOODPLAIN BUFFER                               | — — — — —     |
| WATERS OF THE U.S.                              | — — — — —     |
| WETLAND LIMITS                                  | — — — — —     |
| WETLAND BUFFER                                  | — — — — —     |
| PRIMARY MANAGEMENT AREA                         | — — — — —     |
| STREAM BUFFER                                   | — — — — —     |
| 65 dBA LINE                                     | — — — — —     |
| PROPOSED RETAINING WALL                         | — — — — —     |
| PROPOSED CHAIN LINK FENCE                       | — — — — —     |
| PROPOSED VINYL SCREEN FENCE                     | — — — — —     |
| PROPOSED CURB AND GUTTER                        | — — — — —     |
| PROPOSED CONCRETE PAVING                        | — — — — —     |
| PROPOSED HEAVY DUTY CONCRETE PAVING             | — — — — —     |
| PROPOSED HEAVY DUTY ASPHALT PAVING              | — — — — —     |
| STANDARD PARKING SPACES                         | — — — — —     |
| COMPACT PARKING SPACES                          | — — — — —     |
| HANDICAPPED PARKING SPACES                      | — — — — —     |
| TREE PROTECTION FENCE                           | — — — — —     |
| PRESERVATION PROTECTION SIGNAGE                 | — — — — —     |
| REFORESTATION PROTECTION SIGNAGE                | — — — — —     |
| CLEARING AREA                                   | — — — — —     |
| PRESERVATION AREA                               | — — — — —     |
| REFORESTATION AREA                              | — — — — —     |
| SPECIMEN TREE WITH LIMITS OF CRITICAL ROOT ZONE | — — — — —     |
| PROPOSED TREE 1/2" - 2" CAL.                    | — — — — —     |
| MINING LIMITS                                   | — — — — —     |
| PHASE LINE                                      | — — — — —     |

THIS BLOCK IS FOR OFFICIAL USE ONLY


QR label certifies that this plan meets conditions of final approval by the Planning Board, its designee or the District Council.

**M-NCPPC APPROVAL**

PROJECT NAME: THE BRICK YARD

PROJECT NUMBER: DSP-05070/03

For Conditions of Approval see Site Plan Cover Sheet or Approval Sheet. Revision numbers must be included in the Project Number.

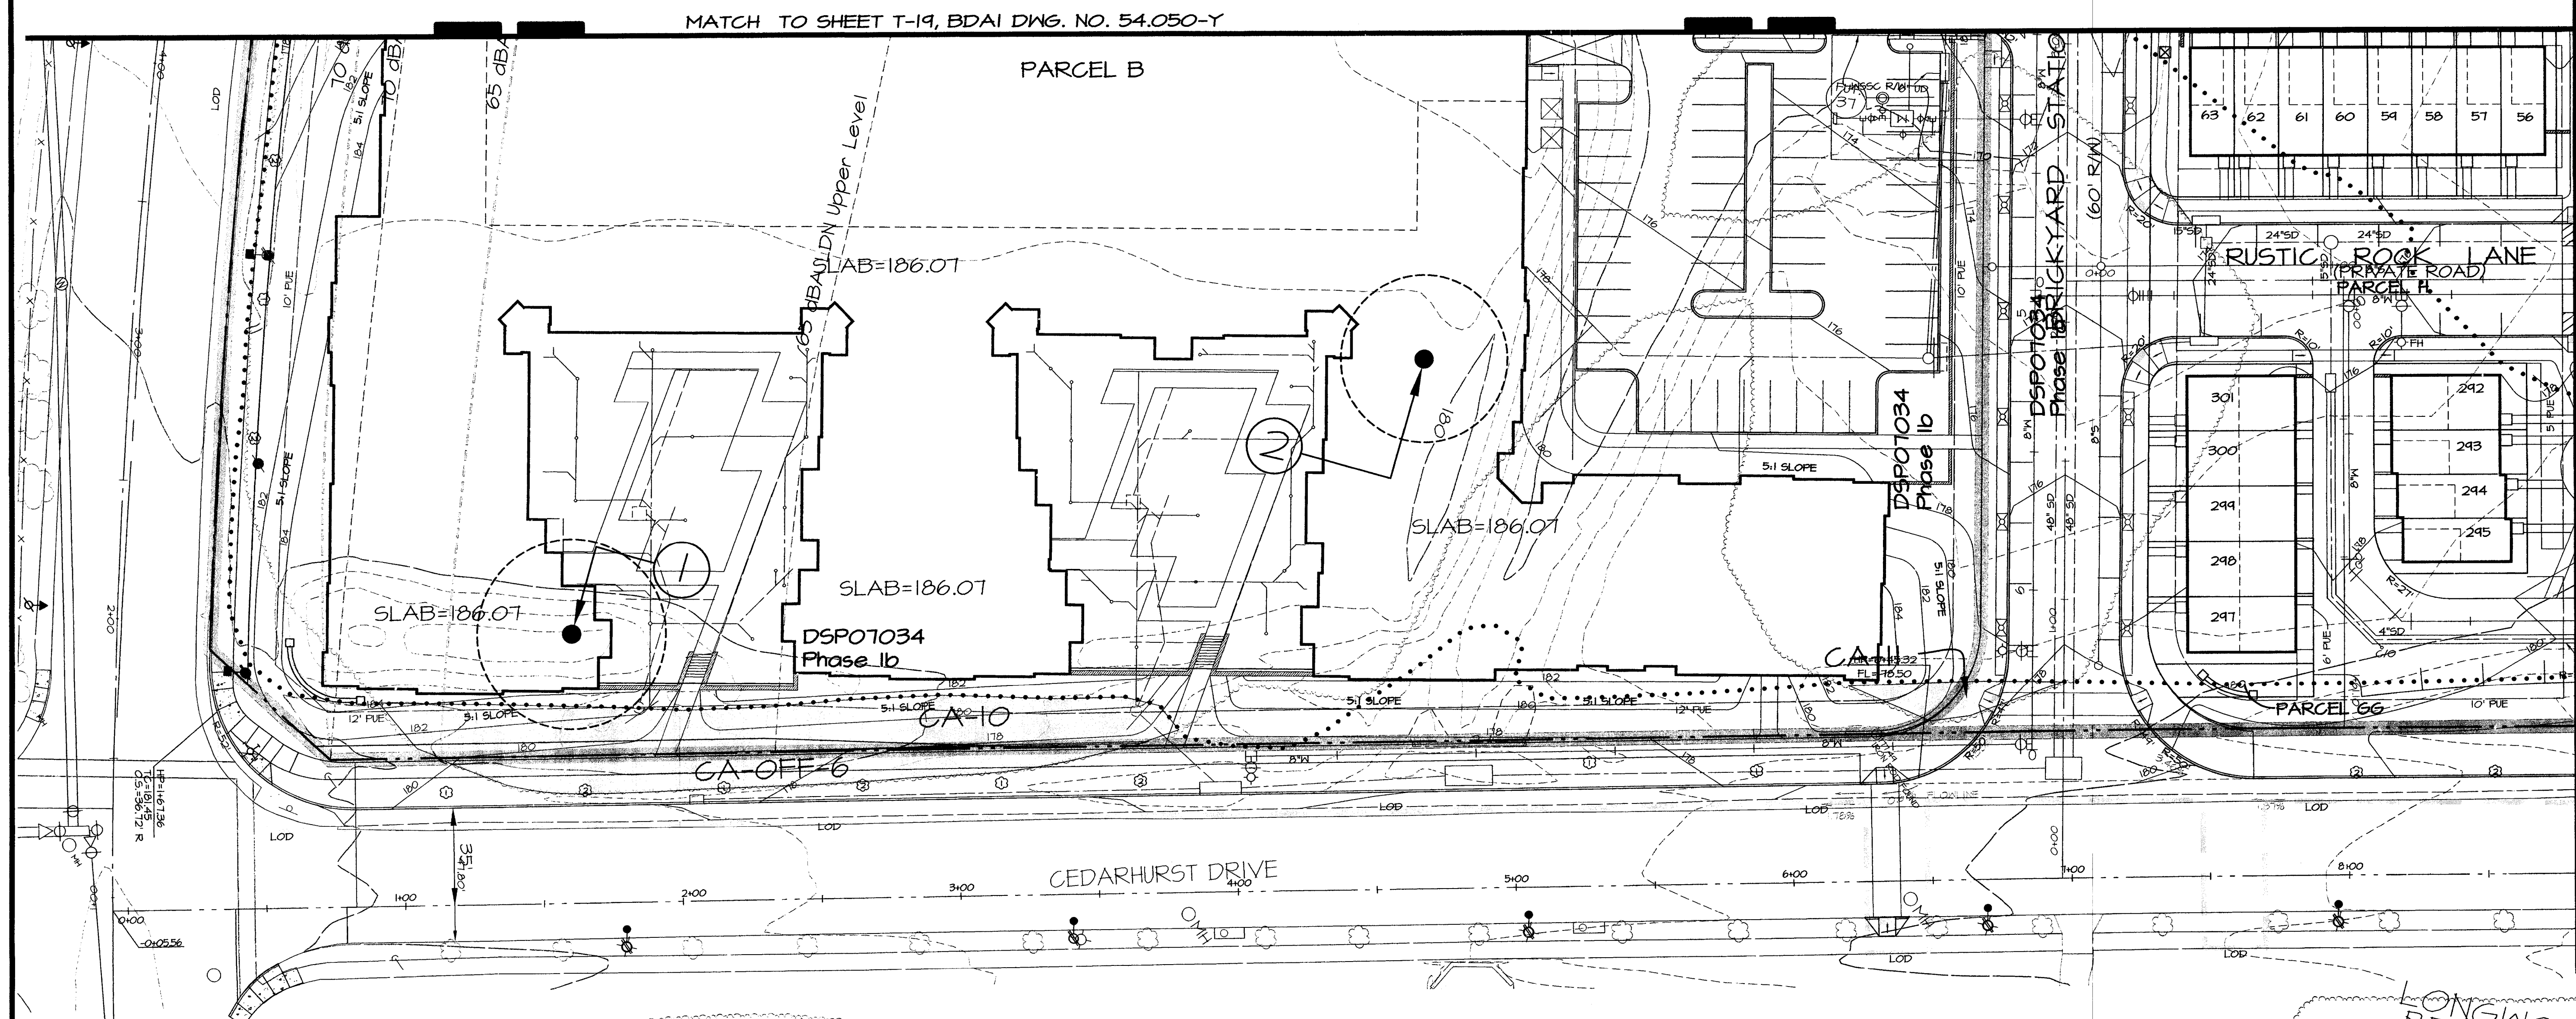

PARCEL "A"  
P.B.VJ174 P.69  
USE: OPEN SPACE  
R-80 Zone

LONGWOOD  
PARCEL "B"  
P.B.VJ174 P.70  
USE: OPEN SPACE  
R-80 Zone

CALL MISS UTILITY  
1-800-257-7777  
48 hrs, Before Excavation

| DATE     | REVISIONS                                       | DESCRIPTION | BY  |
|----------|-------------------------------------------------|-------------|-----|
| 1/04/15  | Revised grading per clients request.            |             | PCN |
| 6/12/14  | Revised to redesign clubhouse and sound wall.   |             | PCN |
| 11/14/13 | REVISED TO COMFORM WITH DSP07034-06             |             | PCN |
| 05/16/13 | REVISED TO COMFORM WITH DSP05070-03             |             | PCN |
| 04/21/12 | REVISED TO COMFORM WITH DSP07034-02             |             | PCN |
| 06/28/11 | REVISED ARCH, COURTYARDS, & PARKING ON PARCEL B |             | JRD |

THIS BLOCK IS FOR OFFICIAL USE ONLY

QR label certifies that this plan meets conditions of final approval by the Planning Board, its designee or the District Council.

**M-NCPPC APPROVAL**

PROJECT NAME: THE BRICK YARD SOUTH

PROJECT NUMBER: DSP-05024

For Conditions of Approval see Site Plan Cover Sheet or Approval Sheet. Revision numbers must be included in the Project Number.

| M.N.C.P.C. APPROVALS |          |              |      |
|----------------------|----------|--------------|------|
| APPROVED BY          | DATE     | DATE         | DATE |
| Lori Shirley         | 8/15/07  | DSP-05024    |      |
| Lori Shirley         | 10/25/08 | DSP-05070    |      |
| Lori Shirley         | 5/4/07   | DSP-05070-01 |      |
| K. Shoulters         | 12/28/07 | DSP-07034    |      |
| K. Shoulters         | 5/20/10  |              |      |
| K. Shoulters         | 10/18/11 | DSP-07034-01 |      |
| K. Shoulters         | 6/19/13  | DSP-07034-04 |      |
| Megan K. Reiser      | 5/13/15  | DSP-05070-03 |      |
| K. Shoulters         | 8/04/14  | DSP-07034-06 |      |
| Megan K. Reiser      | 3/20/15  | DSP-07034-08 |      |

OWNER  
JACKSON SHAW / BRICKYARD  
LIMITED PARTNERSHIP, LLLP  
4640 Forbes Boulevard, Suite 150-B  
Lanham, Maryland 20706  
301-424-1011  
ATTN: Thomas J. Aylward III

| M-NCPPC<br>Prince George's County Planning Department<br>Natural Resources Division<br>APPROVAL<br>TREE CONSERVATION PLAN<br>TCP 2-118-05 |          |              |      |
|---|----------|--------------|------|
| APPROVED BY   | DATE     | DATE         | DATE |
| Lori Shirley   | 8/15/07  | DSP-05024    |      |
| Lori Shirley   | 10/25/08 | DSP-05070    |      |
| Lori Shirley   | 5/4/07   | DSP-05070-01 |      |
| K. Shoulters   | 12/28/07 | DSP-07034    |      |
| K. Shoulters   | 5/20/10  |              |      |
| K. Shoulters   | 10/18/11 | DSP-07034-01 |      |
| K. Shoulters   | 6/19/13  | DSP-07034-04 |      |
| Megan K. Reiser   | 5/13/15  | DSP-05070-03 |      |
| K. Shoulters   | 8/04/14  | DSP-07034-06 |      |
| Megan K. Reiser   | 3/20/15  | DSP-07034-08 |      |

TREE CONSERVATION PLAN, TYPE II  
**THE BRICK YARD**  
MARC PLANNED COMMUNITY  
PROPOSED LOTS 9-440 &  
PARCELS 'B' TO 'Z' & 'AA' TO 'WW'  
LAUREL DISTRICT No. 10  
PRINCE GEORGES COUNTY, MARYLAND  
MSSC 200' SERIES: 216 NE 6 & 7 AND 217 NE 7  
ADC MAP BK LOCATION 4 C-10

T-20  
TOP SHEET 3 OF 13

April 15, 2015  
DATE

Mike Petrakis  
Qualified Professional  
COMAR 08.19.06.01

| GRAPHIC SCALE   |  | 1"= 30' |  | <div><div>9</div><div>13</div></div> |  |
|---|--|---------|--|--------------------------------------|--|
APR 15 2015








THIS BLOCK IS FOR OFFICIAL USE ONLY  
QR label certifies that this plan meets conditions of final approval by the Planning Board, its designee or the District Council.

**M-NCPPC APPROVAL**


PROJECT NAME: THE BRICK YARD  
PROJECT NUMBER: DSP-05070103

For Conditions of Approval see Site Plan Cover Sheet or Approval Sheet  
Revision numbers must be included in the Project Number

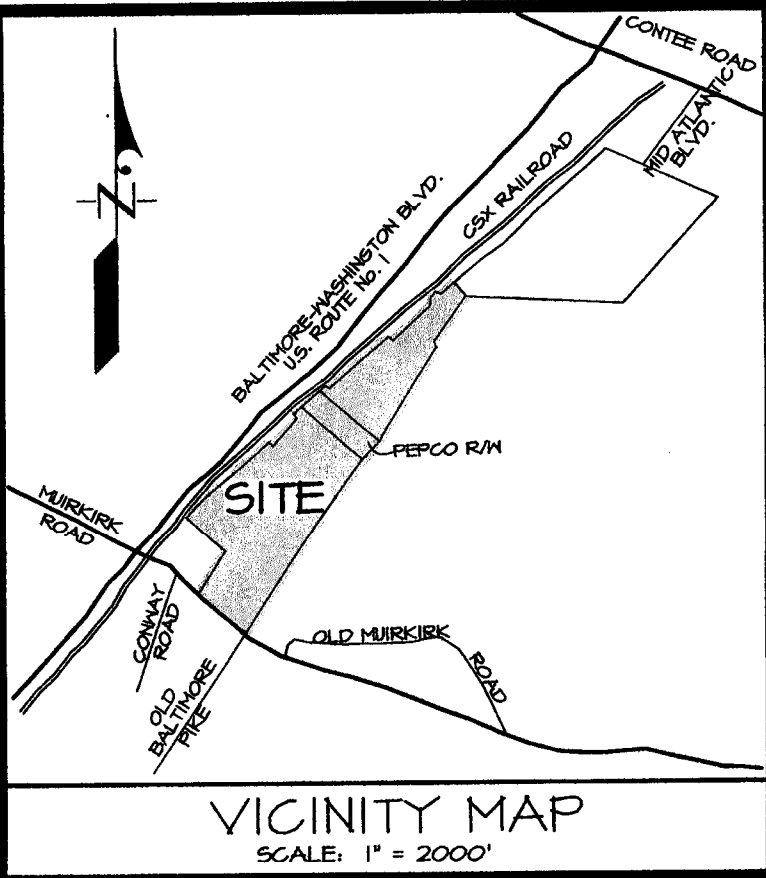

**LEGEND**

EXISTING CONTOURS: 102  
PROPOSED CONTOURS: 102.5  
EXISTING SPOT ELEVATIONS: 101.2, 102.5  

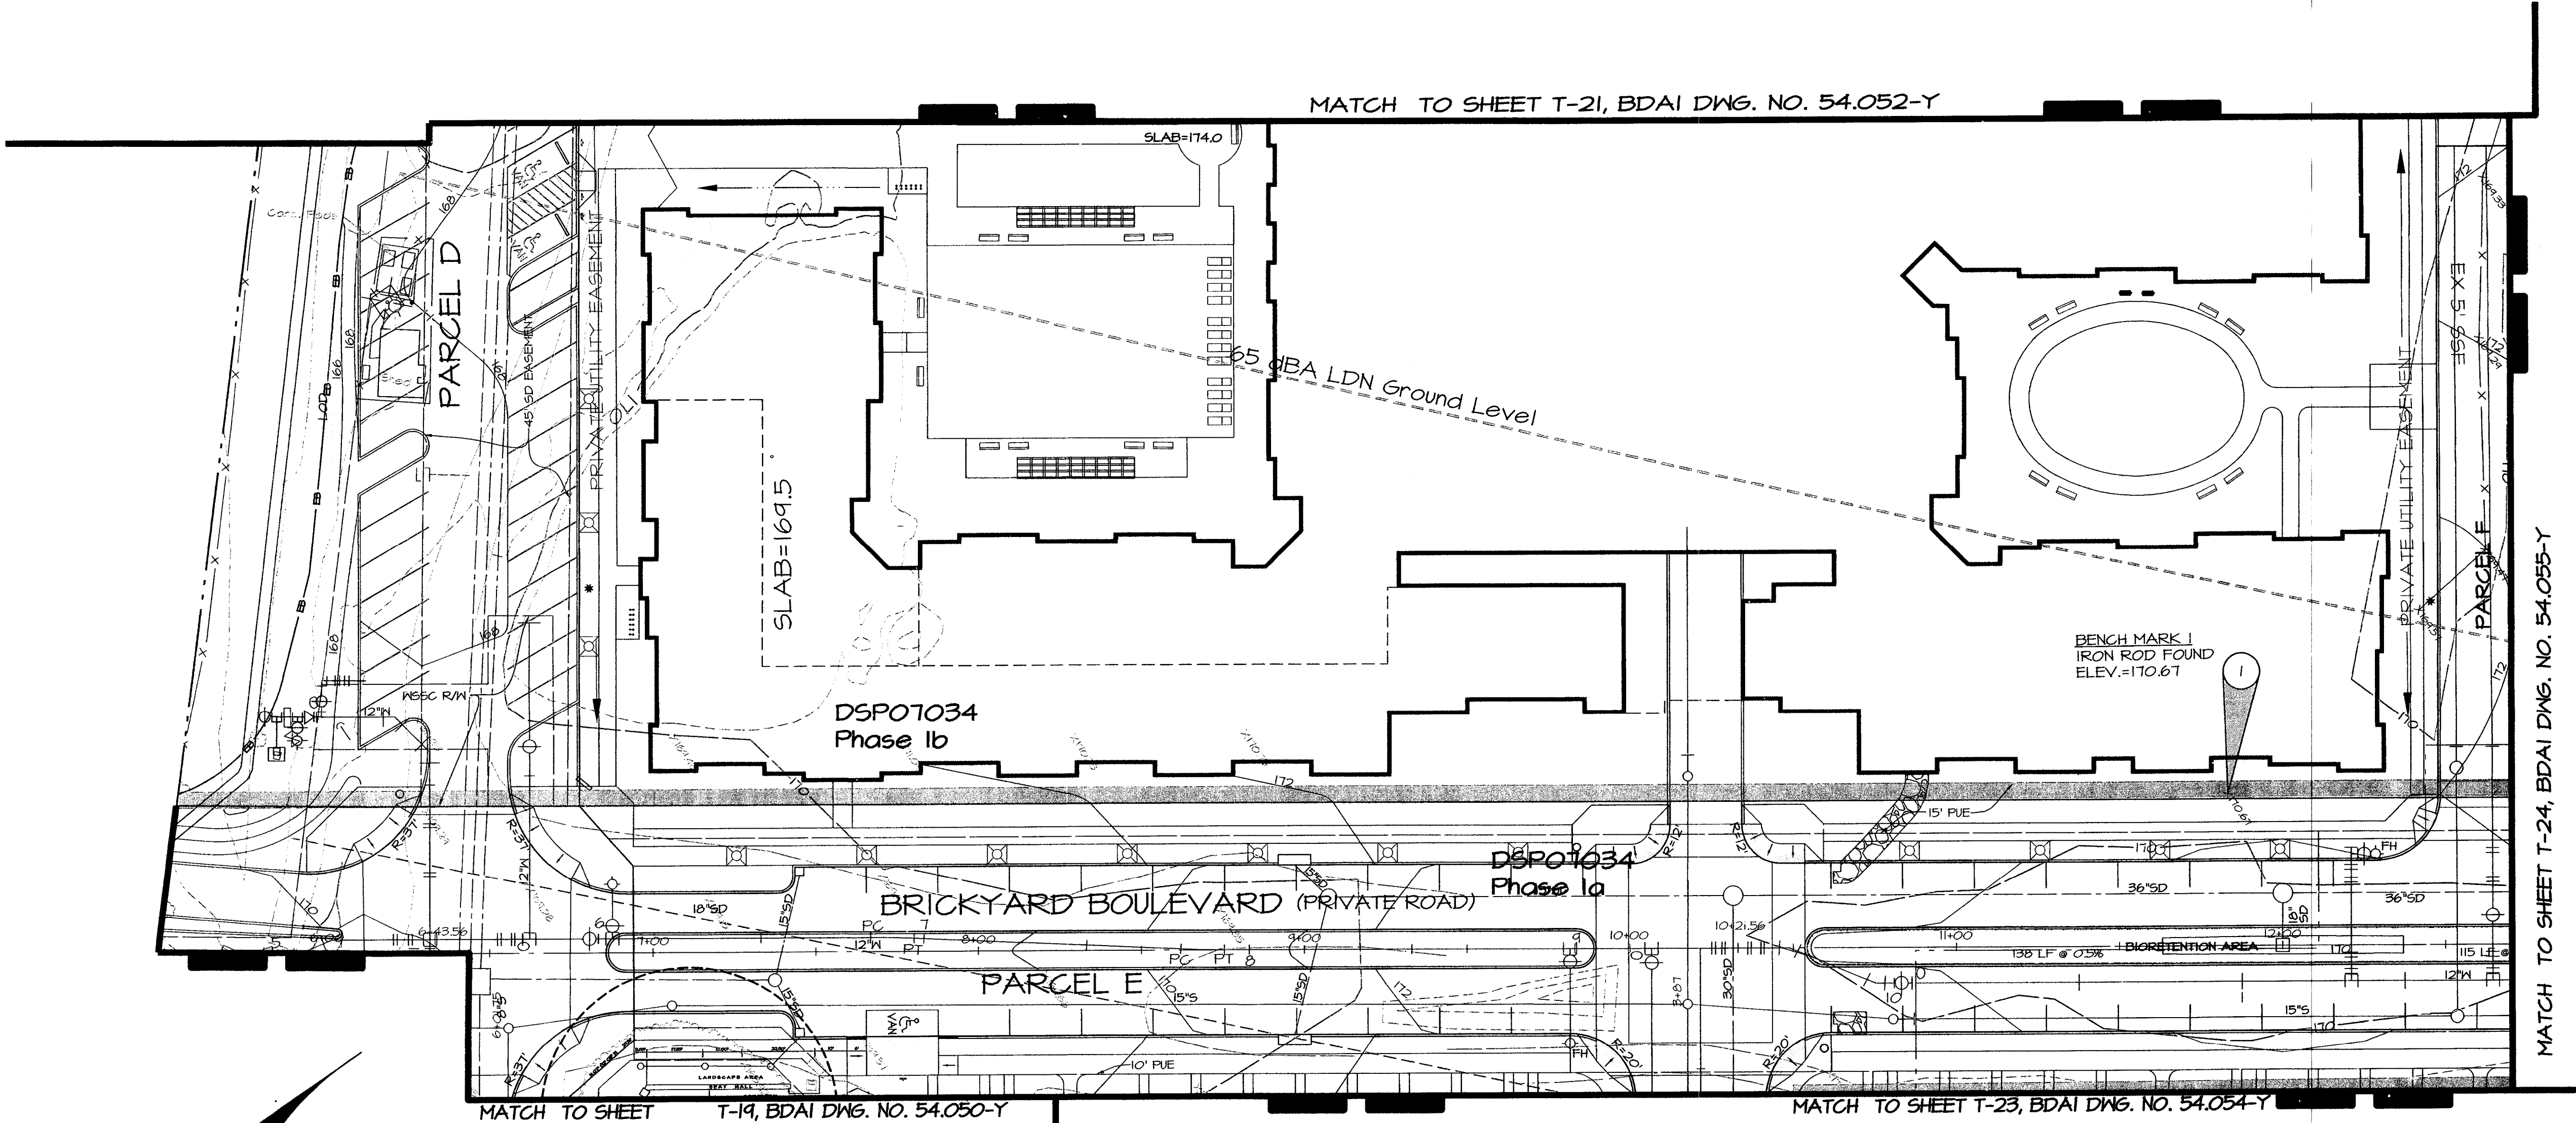

| M-NCPPC<br>Prince George's County Planning Department<br>Natural Resources Division<br>APPROVAL<br>TREE CONSERVATION PLAN<br>TCP 2-118-05 |          |              |  |
|---|----------|--------------|--|
| Approved by   | DATE     |              |  |
| 01. Lori Shirley   | 8/15/07  | DSP-05024    |  |
| 02. Lori Shirley   | 10/25/08 | DSP-05070    |  |
| 03. K. Shoulers   | 5/4/07   | DSP-05070-01 |  |
| 04. K. Shoulers   | 12/26/07 | DSP-07034    |  |
| 05. K. Shoulers   | 5/20/10  |              |  |
| 06. K. Shoulers   | 10/18/11 | DSP-07034-01 |  |
| 07. K. Shoulers   | 6/19/13  | DSP-07034-04 |  |
| 08. K. Shoulers   | 2/14/15  | DSP-05070-03 |  |
| 09. Megan K. Reiser   | 8/24/15  | DSP-07034-06 |  |
|   | 3/20/15  | DSP-07034-08 |  |

| M.N.C.P.C. APPROVALS   |                  |                      |                       |
|---|------------------|----------------------|-----------------------|
| PROJECT NAME:   |                  | THE BRICK YARD SOUTH |                       |
| PROJECT NUMBER:   |                  | DSP-05024            |                       |
| For Conditions of Approval see Site Plan Cover Sheet or Approval Sheet<br>For Revisions Listed Below Only for this Sheet. |                  |                      |                       |
| Approval of<br>Revision #                                                                                                 | Approval<br>Date | Reviewer's Signature | Certification<br>Date |
|   |                  |                      |                       |
|   |                  |                      |                       |
THIS BLOCK IS FOR OFFICIAL USE ONLY  
QR label certifies that this plan meets conditions of final approval by the Planning Board, its designee or the District Council.

**M-NCPPC APPROVAL**

PROJECT NAME: THE BRICK YARD SOUTH  
PROJECT NUMBER: DSP-07034/08

For Conditions of Approval see Site Plan Cover Sheet or Approval Sheet  
Revision numbers must be included in the Project Number

CALL MISS UTILITY  
1-800-257-7777  
48 hrs, Before Excavation

| DATE     | REVISIONS DESCRIPTION                         | BY  |
|----------|-----------------------------------------------|-----|
| 1/04/15  | Revised grading per clients request.          | PCN |
| 6/12/14  | Revised to redesign clubhouse and sound wall. | PCN |
| 11/14/13 | REVISED TO CONFORM WITH DSP07034-06           | PCN |
| 05/16/13 | REVISED TO CONFORM WITH DSP05070-03           | PCN |

OWNER  
JACKSON SHAW / BRICKYARD  
LIMITED PARTNERSHIP, LLLP  
4640 Forbes Boulevard, Suite 150-B  
Lanham, Maryland 20706  
301-424-1011  
ATTN: Thomas J. Aylward III

TREE CONSERVATION PLAN, TYPE II  
THE BRICK YARD T-22  
MARC PLANNED COMMUNITY  
PROPOSED LOTS 9-440 &  
PARCELS 'B' TO 'Z' & 'AA' TO 'WW'  
LAUREL DISTRICT No. 10  
PRINCE GEORGES COUNTY, MARYLAND  
MNSC 200' SHEET SERIES: 216 NE 6 & 4 T AND 217 NE 7  
ADP MAP BK LOCATION 4 C-10


April 15, 2015  
DATE  
Mike Petrakis  
Qualified Professional  
COMAR 08.19.06.01

| DATE     | REVISIONS DESCRIPTION                          | BY  |
|----------|------------------------------------------------|-----|
| 04/21/12 | REVISED TO CONFORM WITH DSP07034-02            | PCN |
| 7-23-09  | Revised to create subphases for South DSP07034 | PCN |
| 4-4-08   | Revised per staff required layout changes.     | CW  |
| 3-21-08  | Revised per M-NCPPC comments received 3-1-08   | CW  |
| 2/14/08  | UPDATED WETLANDS/ STREAM FEATURES              | MB  |
| 2/6/08   | REVISED PER M-NCPPC 1-11-08 COMMENTS           | MB  |


10721 WOODMORE ROAD, SUITE 200  
MITCHELLVILLE, MARYLAND 20722  
BEN DYER ASSOCIATES, INC.  
Engineers / Surveyors / Planners  
TELEPHONE (301) 430-2000  
COPYRIGHT © 2007 BEN DYER ASSOCIATES, INC.  
DRAWN BY (DESIGNED BY) CHECKED BY RECORD NO.  
SCALE 1"=30'  
DATE MAY 2007 DWG. NO. 54.053-Y

THIS PRINT MADE APR 15 2015



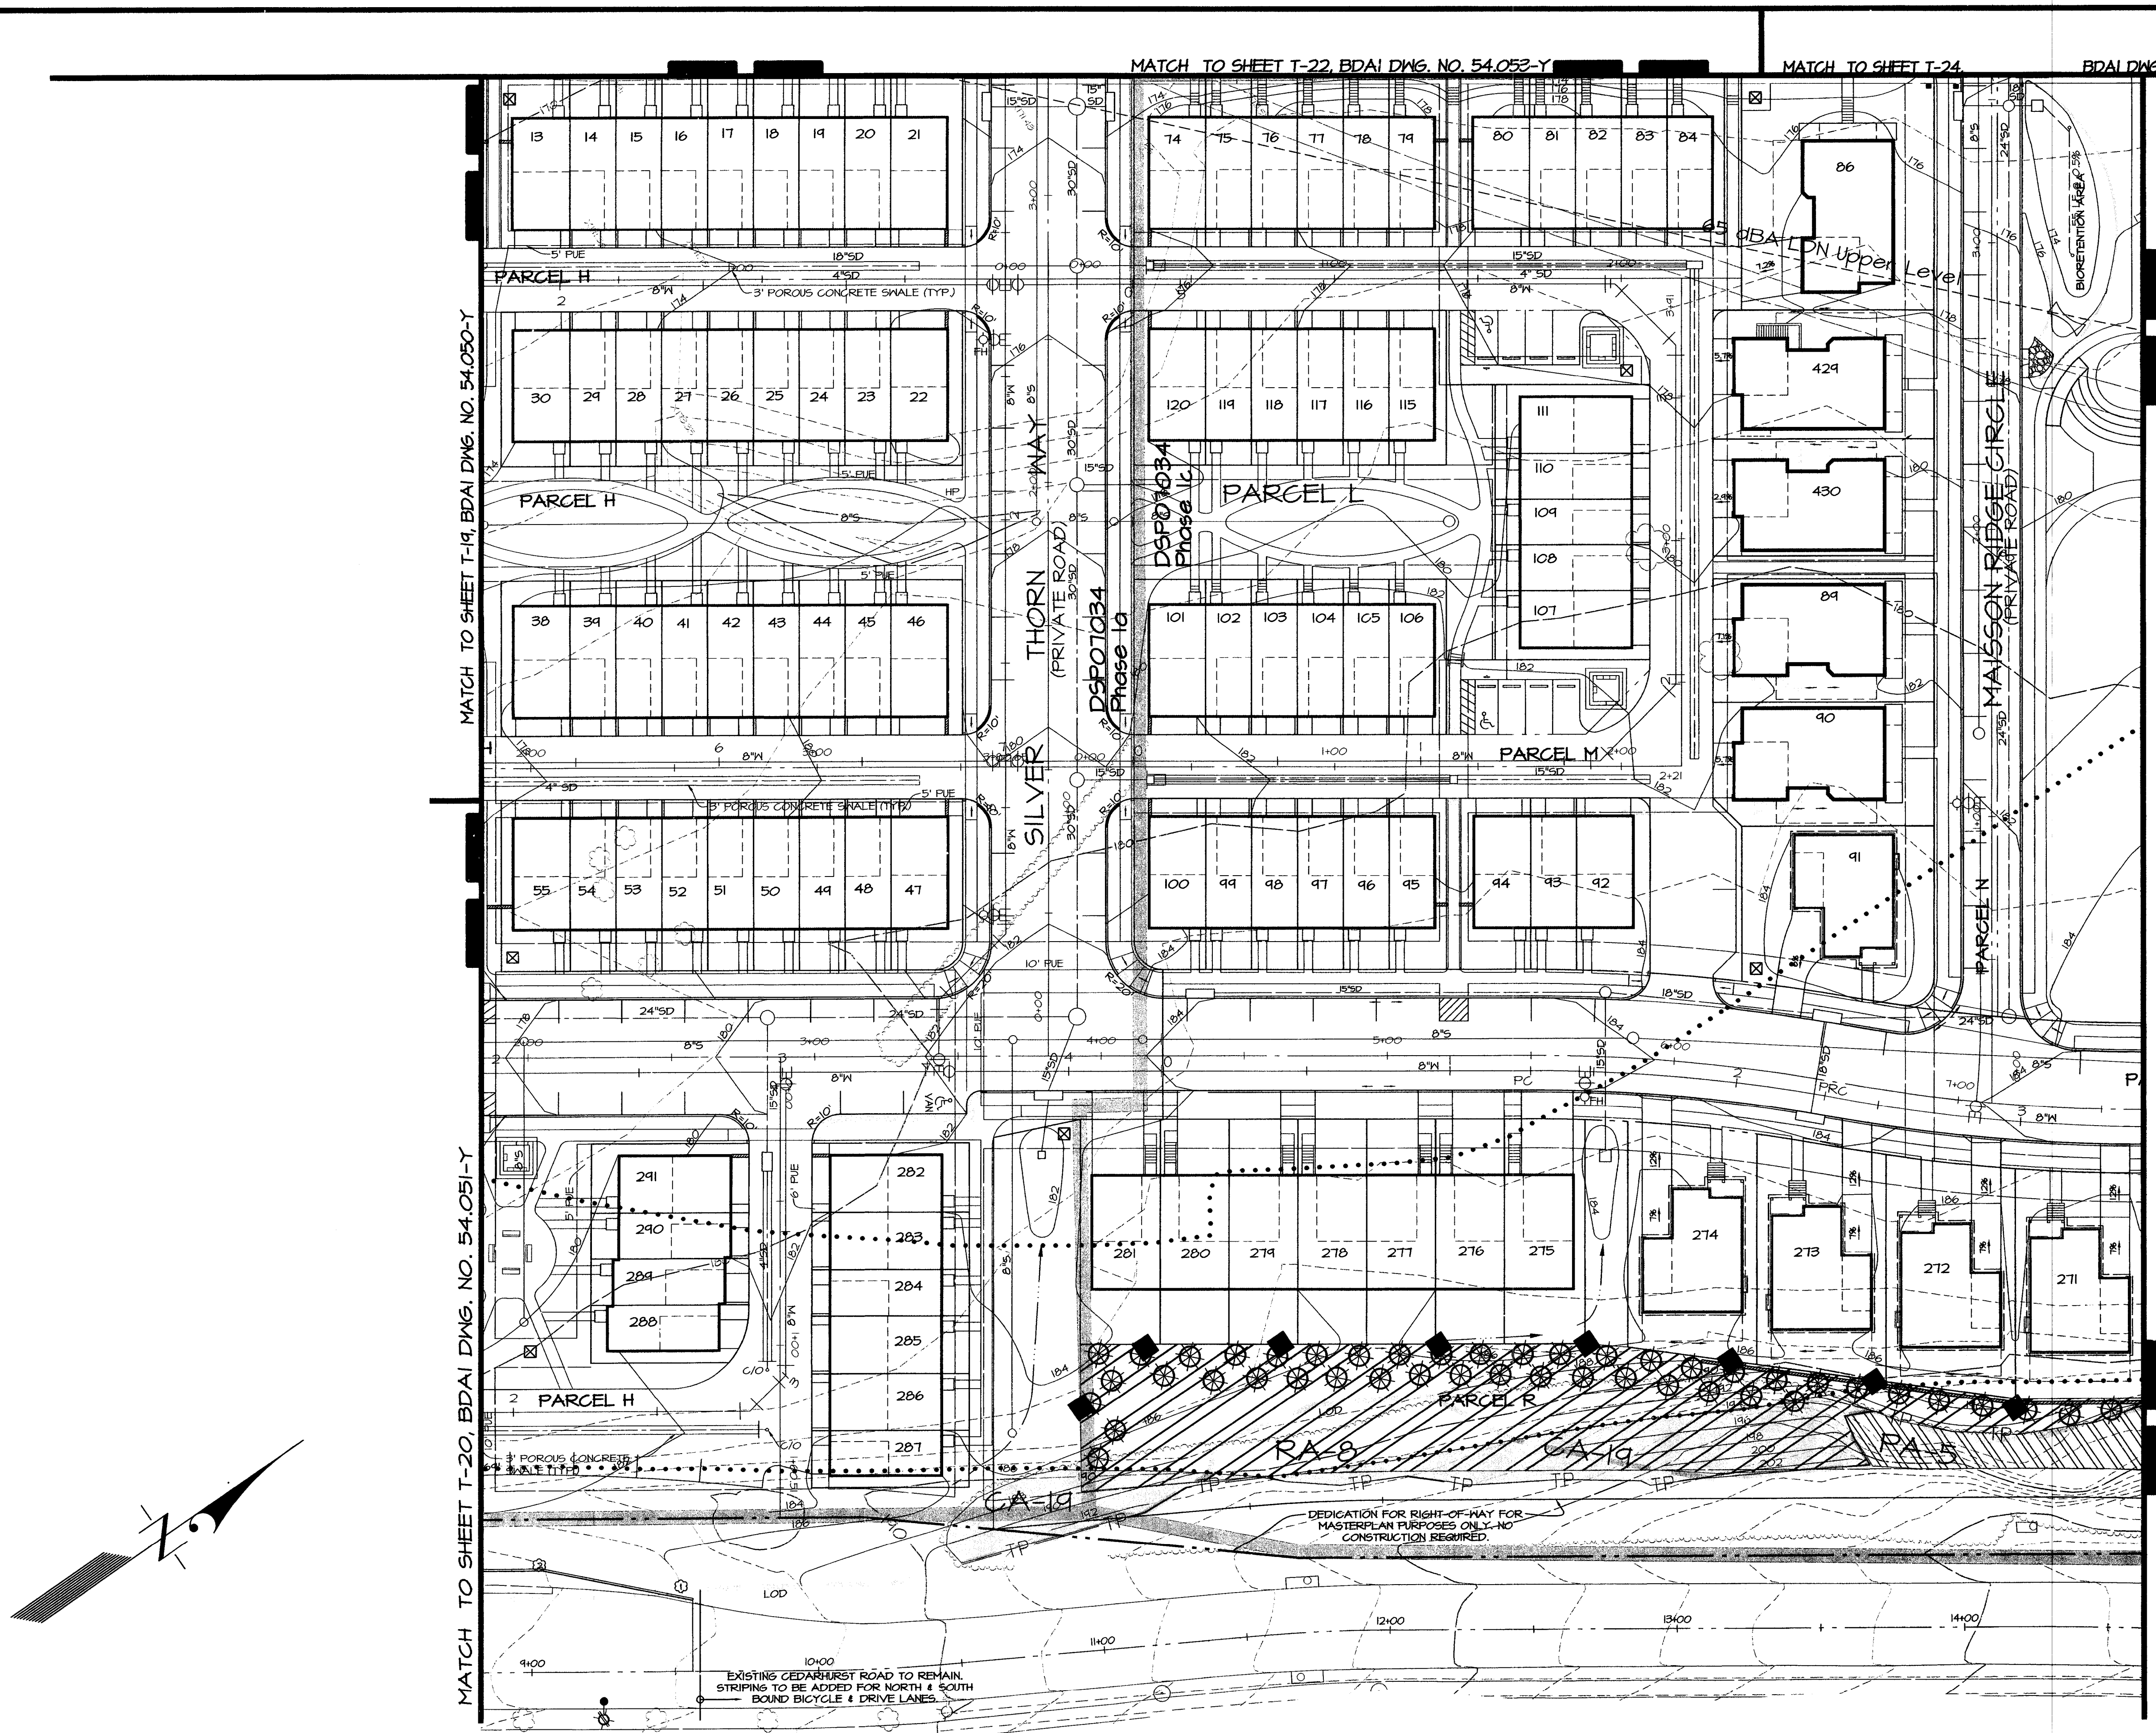




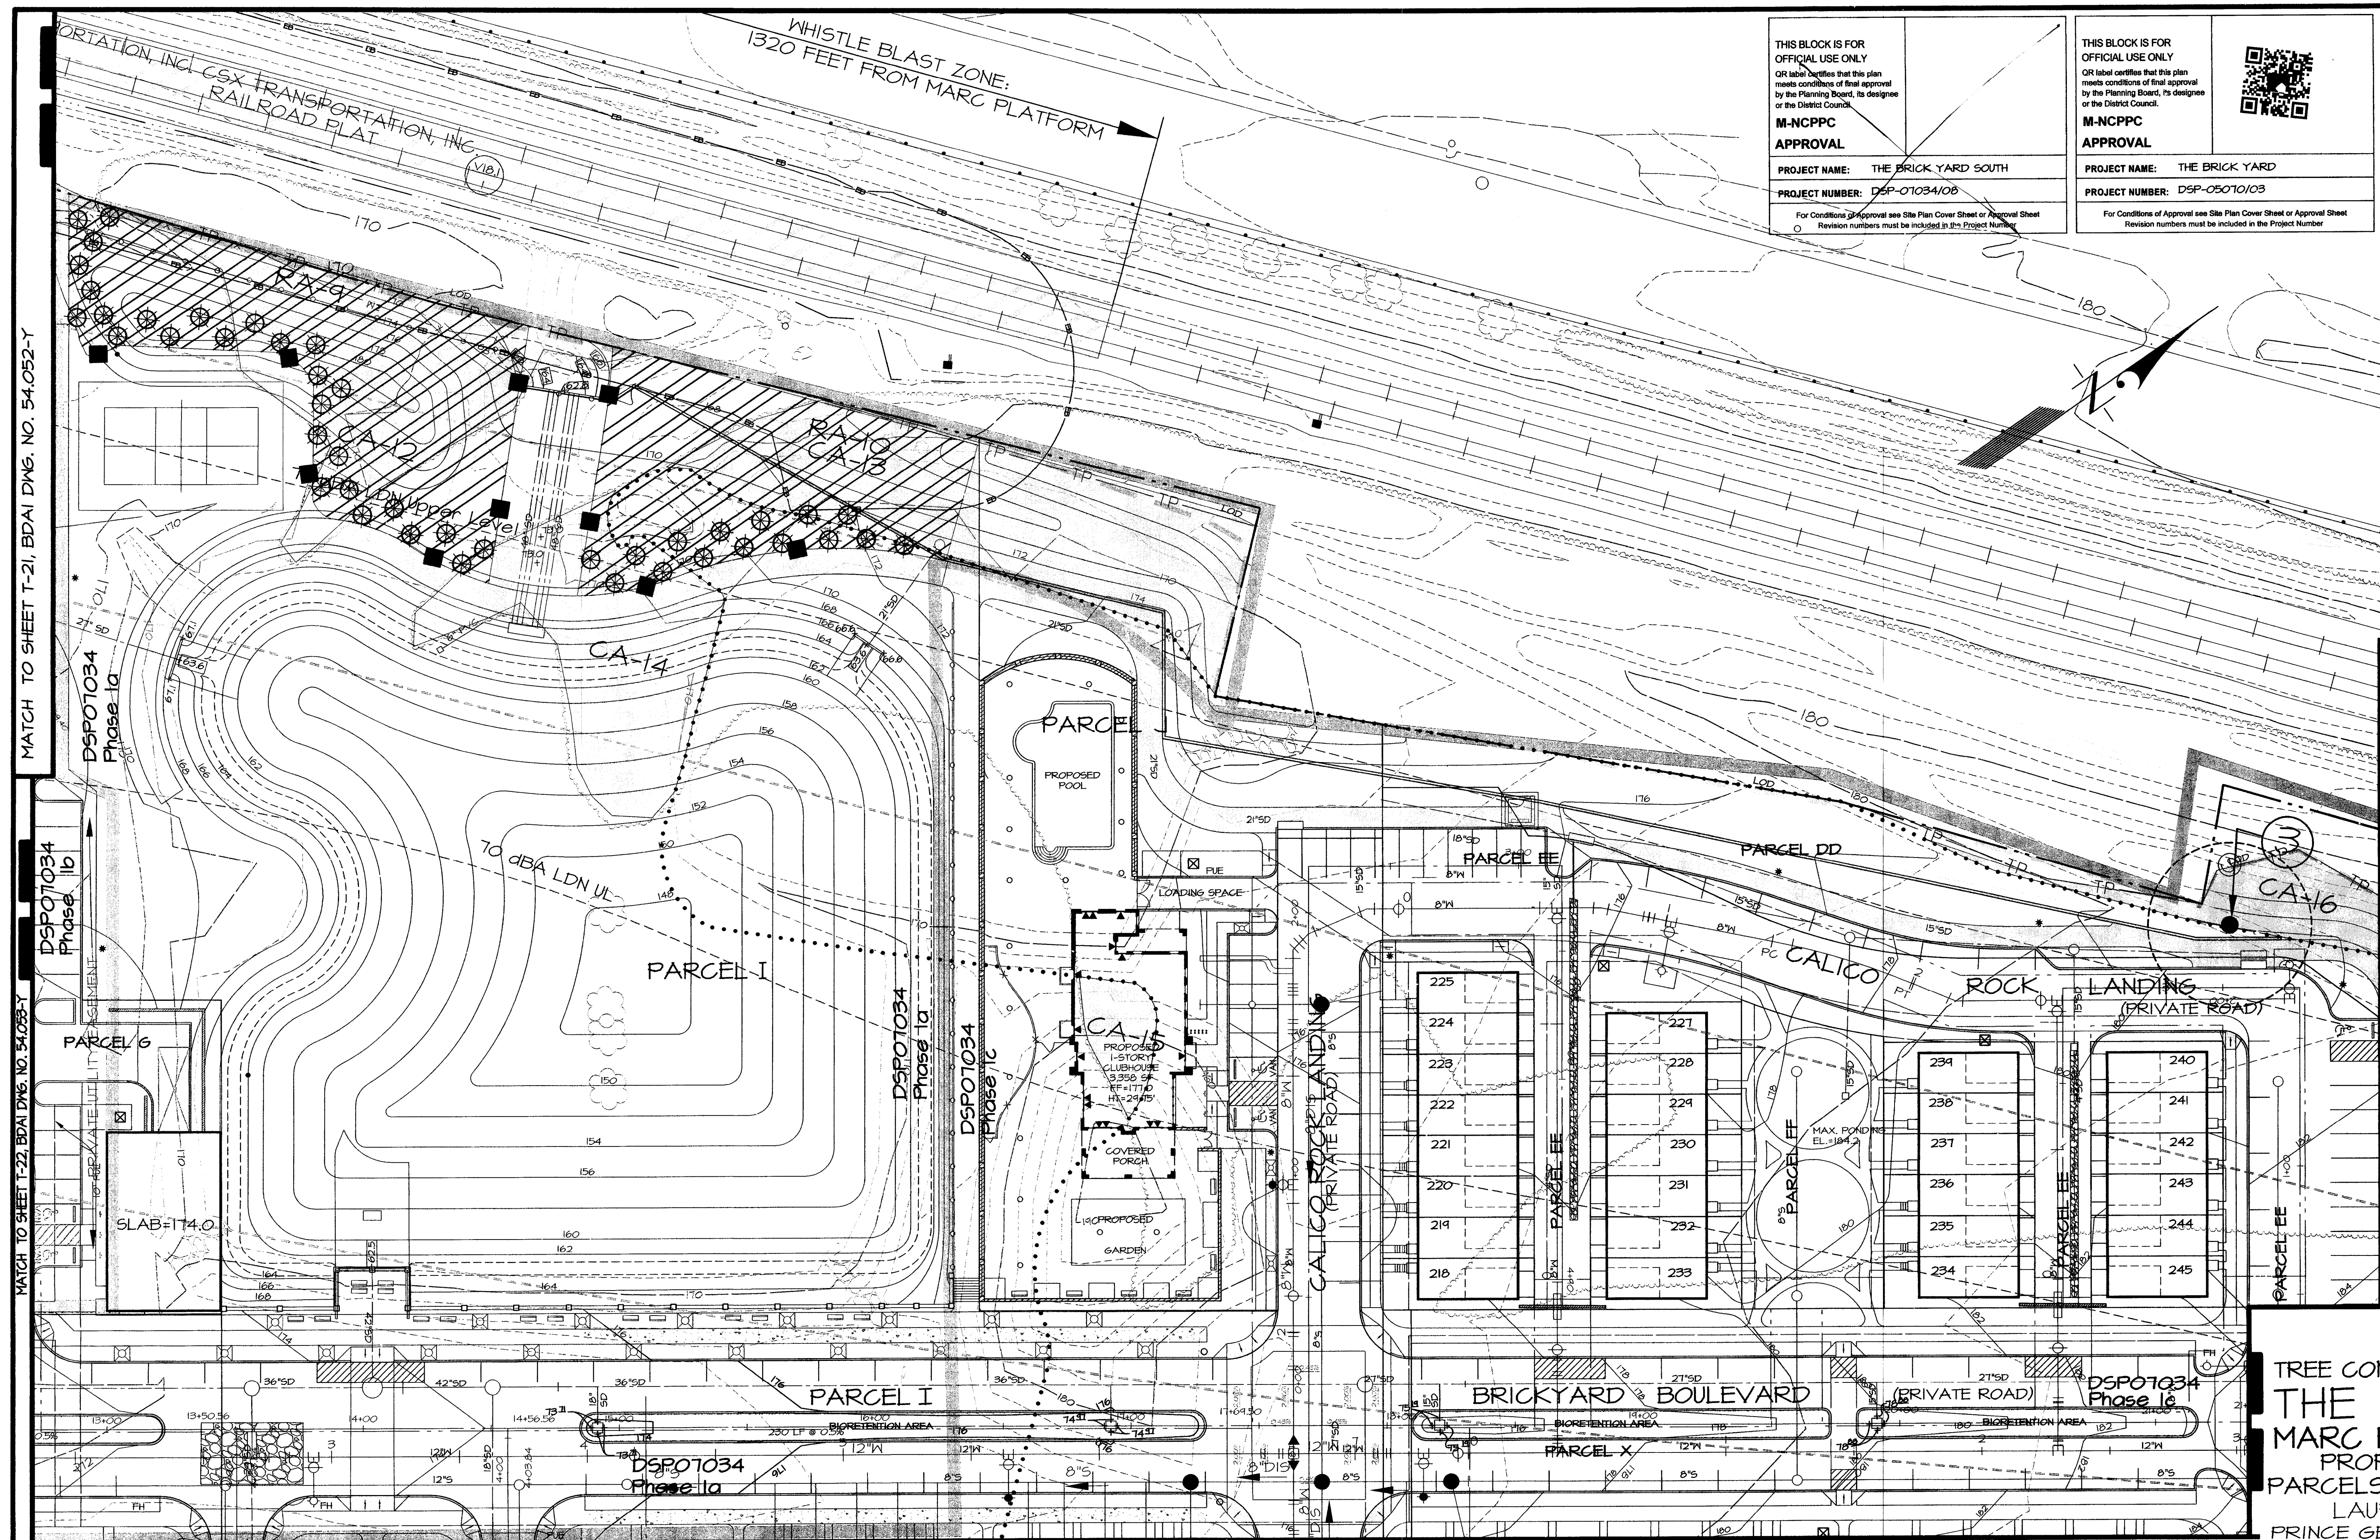

|   |                              |
|---|------------------------------|
| THIS BLOCK IS FOR OFFICIAL USE ONLY. OR label certifies that this plan meets conditions of final approval by the Planning Board, its designee or the District Council. |                              |
| <b>M-NCPPC APPROVAL</b>   |                              |
| PROJECT NAME: THE BRICK YARD SOUTH   | PROJECT NUMBER: DSP-01034/08 |
| For Conditions of Approval see Site Plan Cover Sheet or Approval Sheet. Revision numbers must be included in the Project Number.                                       |                              |

|   |                              |
|---|------------------------------|
| THIS BLOCK IS FOR OFFICIAL USE ONLY. OR label certifies that this plan meets conditions of final approval by the Planning Board, its designee or the District Council. |                              |
| <b>M-NCPPC APPROVAL</b>   |                              |
| PROJECT NAME: THE BRICK YARD   | PROJECT NUMBER: DSP-05010/03 |
| For Conditions of Approval see Site Plan Cover Sheet or Approval Sheet. Revision numbers must be included in the Project Number.                                       |                              |

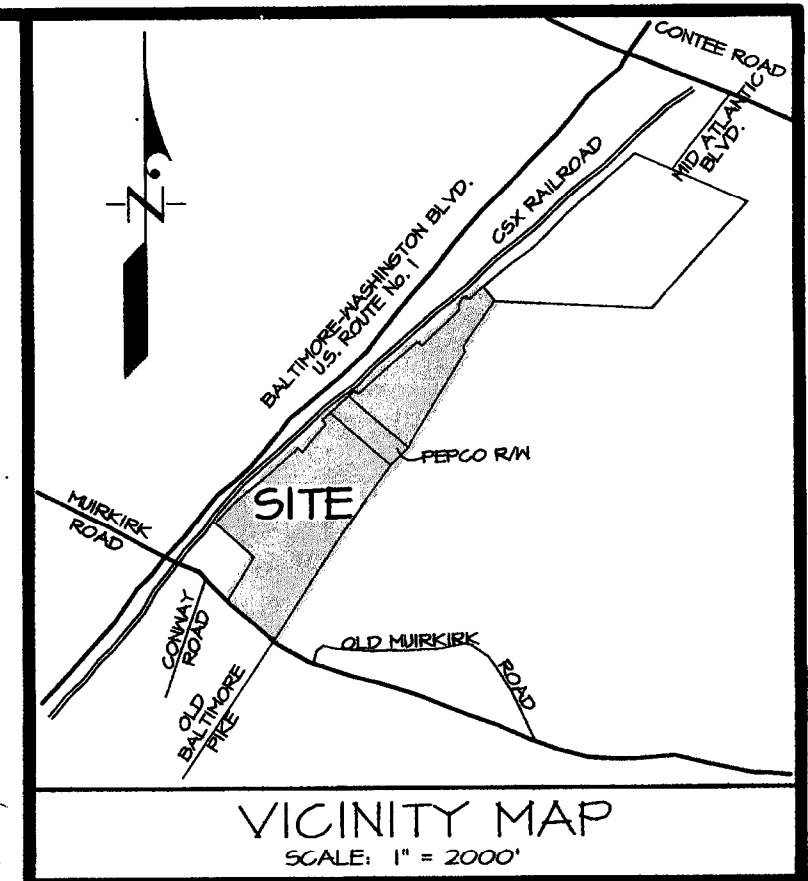

| LEGEND                                          |               |
|-------------------------------------------------|---------------|
| EXISTING CONTOURS                               | 102           |
| PROPOSED CONTOURS                               | 102           |
| EXISTING SPOT ELEVATIONS                        | x104.7 x105.5 |
| PROPOSED SPOT ELEVATIONS                        | +101.2 +105.1 |
| PROPOSED SEWER                                  | ○             |
| PROPOSED WATER                                  | ○             |
| PROPOSED STORM DRAIN                            | ○             |
| EXISTING STREET LIGHT                           | △             |
| PROPOSED STREET LIGHT                           | △             |
| LIMIT OF DISTURBANCE                            | LOD           |
| PRE-DEVELOPMENT TREE LINE                       | ---           |
| POST-DEVELOPMENT TREE LINE                      | ---           |
| FLOODPLAIN, EXISTING/PROPOSED                   | FD            |
| FLOODPLAIN BUFFER                               | FD            |
| WATERS OF THE U.S.                              | W             |
| WETLAND LIMITS                                  | HL            |
| WETLAND BUFFER                                  | HB            |
| PRIMARY MANAGEMENT AREA                         | PMA           |
| STREAM BUFFER                                   | SB            |
| 65 dBA LINE                                     | 65            |
| PROPOSED RETAINING WALL                         | ---           |
| PROPOSED CHAIN LINK FENCE                       | X             |
| PROPOSED VINYL SCREEN FENCE                     | ---           |
| PROPOSED CURB AND GUTTER                        | ---           |
| PROPOSED CONCRETE PAVING                        | ---           |
| PROPOSED HEAVY DUTY CONCRETE PAVING             | ---           |
| PROPOSED HEAVY DUTY ASPHALT PAVING              | ---           |
| STANDARD PARKING SPACES                         | ---           |
| CONTACT PARKING SPACES                          | ---           |
| HANDICAPPED PARKING SPACES                      | ---           |
| TREE PROTECTION FENCE                           | TP            |
| PRESERVATION PROTECTION SIGNAGE                 | ---           |
| REFORESTATION PROTECTION SIGNAGE                | ---           |
| CLEARING AREA                                   | ---           |
| PRESERVATION AREA                               | ---           |
| REFORESTATION AREA                              | ---           |
| WHISTLE BLAST ZONE                              | ---           |
| SPECIMEN TREE WITH LIMITS OF CRITICAL ROOT ZONE | ---           |
| PROPOSED TREE 1/2"x2" CAL.                      | ---           |
| MINING LIMITS                                   | ---           |
| PHASE LINE                                      | ---           |

MATCH TO SHEET T-21, BDAI DWG. NO. 54.052-Y

CALL MISS UTILITY  
1-800-257-7777  
48 hrs. Before Excavation

| M-NCPPC                                    |          |              |
|--------------------------------------------|----------|--------------|
| Prince George's County Planning Department |          |              |
| Natural Resources Division                 |          |              |
| <b>APPROVAL</b>                            |          |              |
| TREE CONSERVATION PLAN                     |          |              |
| TCP 2-118-05                               |          |              |
| Approved by                                | DATE     |              |
| Lori Shirley                               | 8/15/07  | DSP-05024    |
| Lori Shirley                               | 10/25/08 | DSP-05070    |
| Lori Shirley                               | 5/4/07   | DSP-05070-01 |
| K. Shoulters                               | 12/28/07 | DSP-07034    |
| K. Shoulters                               | 5/29/10  | DSP-07034-01 |
| K. Shoulters                               | 10/15/11 | DSP-07034-02 |
| K. Shoulters                               | 6/13/13  | DSP-07034-03 |
| Megan K. Reiser                            | 5/13/15  | DSP-05070-03 |
| K. Shoulters                               | 8/04/14  | DSP-07034-04 |
| Megan K. Reiser                            | 3/20/15  | DSP-07034-05 |

| M.N.C.P.P.C. APPROVALS                                                                                                  |                                               |             |
|---|-----------------------------------------------|-------------|
| PROJECT NAME: THE BRICK YARD SOUTH                                                                                      |                                               |             |
| PROJECT NUMBER: DSP-05024                                                                                               |                                               |             |
| For Conditions of Approval see Site Plan Cover Sheet or Approval Sheet. The Engineer's Label Shall Refer to This Sheet. |                                               |             |
| Approval of   | Approval of                                   | Approval of |
| Design   | Design                                        | Design      |
| DATE   | DATE                                          | DATE        |
| 1/04/15   | Revised grading per clients request.          | PCN         |
| 6/12/14   | Revised to redesign clubhouse and sound wall. | PCN         |
| 6/05/14   | Revised to remove reforestation in front of   | PCN         |
| 11/14/13   | REVISSED TO CONFORM WITH DSP07034-06          | PCN         |
| 05/16/13   | REVISSED TO CONFORM WITH DSP05070-03          | PCN         |
| DATE   | REVISIONS DESCRIPTION                         | BY          |

| OWNER                                              |  |  |
|----------------------------------------------------|--|--|
| JACKSON SHAW / BRICKYARD LIMITED PARTNERSHIP, LLLP |  |  |
| 4640 Forbes Boulevard, Suite 150-B                 |  |  |
| Lanham, Maryland 20706                             |  |  |
| 301-424-1011                                       |  |  |
| ATTN: Thomas J. Ayward III                         |  |  |

| T-24              |                                                                           |                                     |
|-------------------|---------------------------------------------------------------------------|-------------------------------------|
| TCP SHEET 1 OF 13 |                                                                           |                                     |
| DATE              | DATE                                                                      | DATE                                |
| April 15, 2015    | 7-23-09                                                                   | Revised to conform with DSP07034-02 |
| 4-4-08            | Revised per staff required layout changes.                                | PCN                                 |
| 3-21-08           | Revised per M-NCPPC comments received 3-2-08                              | PCN                                 |
| 2/14/08           | UPDATED WETLANDS/ STREAM FEATURES                                         | PCN                                 |
| 2/6/08            | REVISSED PER M-NCPPC 1-11-08 COMMENTS                                     | PCN                                 |
| DATE              | REVISIONS DESCRIPTION                                                     | BY                                  |
| 1/10/07           | PROJ. 83048-LD7 (sheet) TCP-07034-south.dwg, 4/13/2015 3:31:02 PM, nispag |                                     |




TREE CONSERVATION PLAN, TYPE II  
THE BRICK YARD  
MARC PLANNED COMMUNITY  
PROPOSED LOTS 9-440 &  
PARCELS 'B' TO 'Z' & 'AA' TO 'WW'  
LAUREL DISTRICT No. 10  
PRINCE GEORGES COUNTY, MARYLAND  
HSSC 2007 SHEET SERIES, 216 NE 6 & 7 AND 217 NE 7  
ADD MAP BK LOCATION 4 C-10

| GRAPHIC SCALE |    |    |
|---------------|----|----|
| 1" = 30'      |    |    |
| 0             | 30 | 60 |
| 9             | 13 |    |



CALL MISS UTILITY  
1-800-257-7777  
48 hrs, Before Excavation

MATCH TO SHEET T-23, BDAI DWG. NO. 54.054-Y

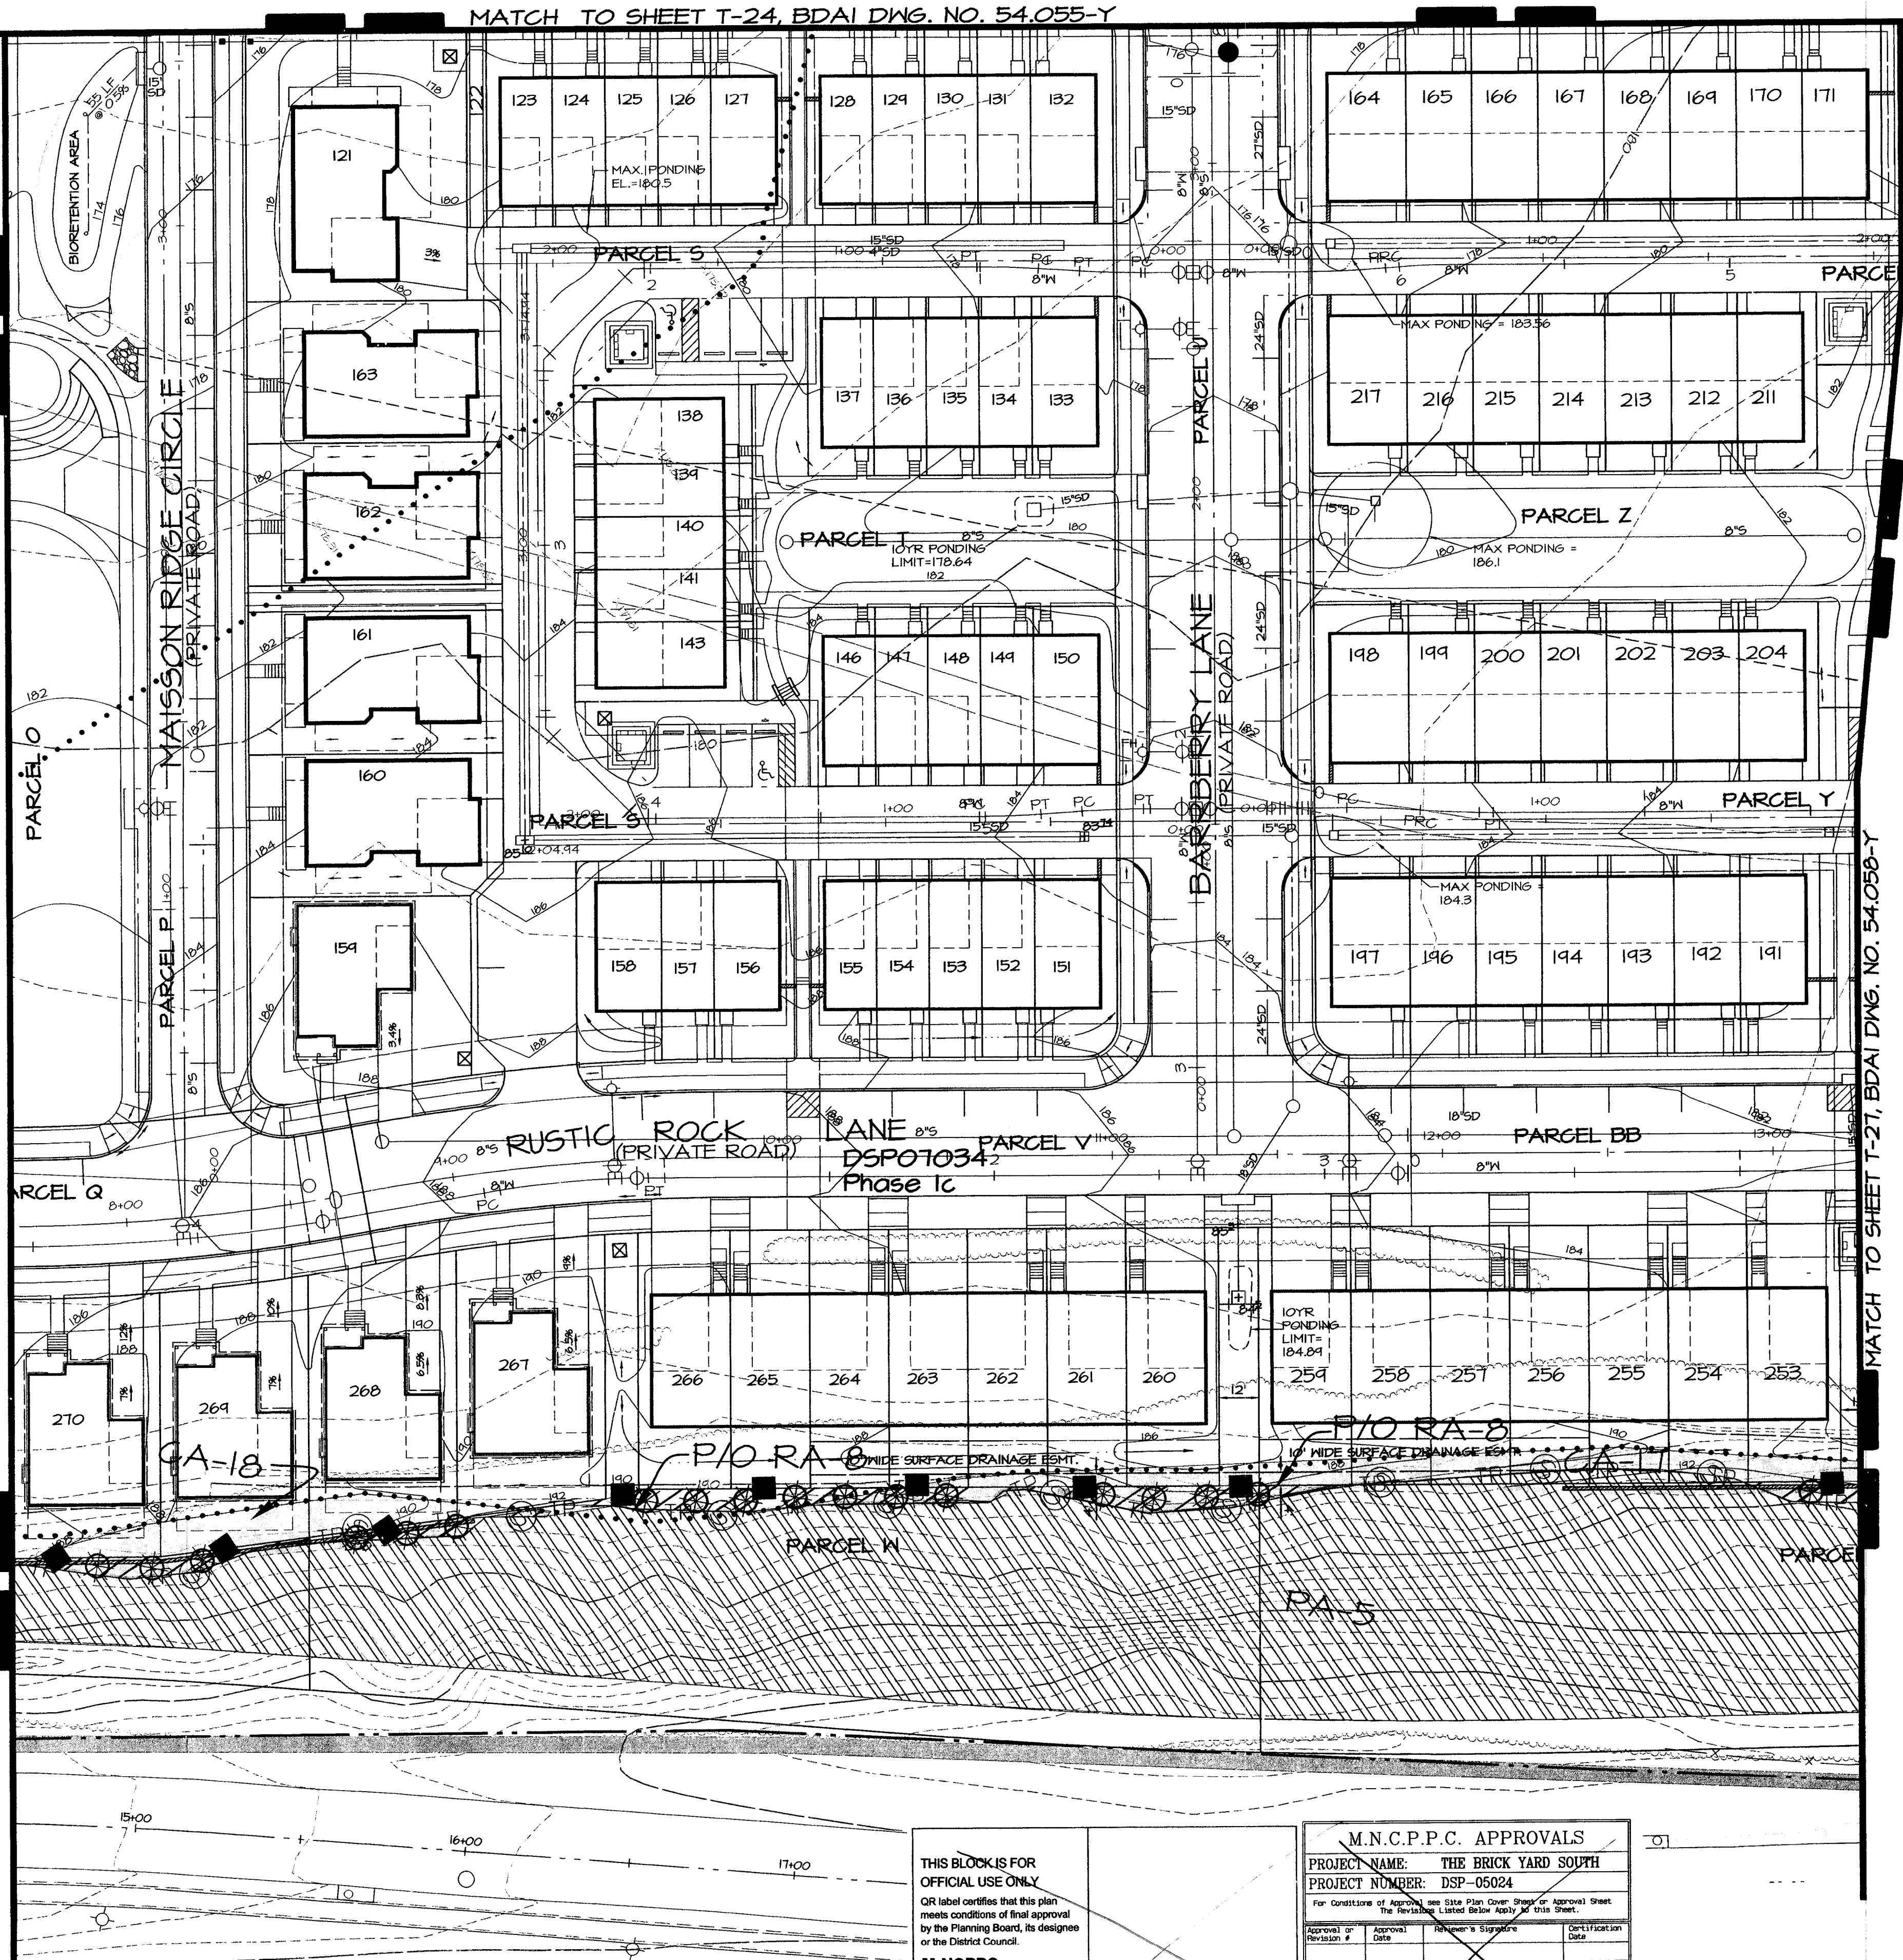

THIS BLOCK IS FOR OFFICIAL USE ONLY

QR label certifies that this plan meets conditions of final approval by the Planning Board, its designee or the District Council.

**M-NCPPC**

**APPROVAL**


PROJECT NAME: THE BRICK YARD

PROJECT NUMBER: DSP-05070/03

For Conditions of Approval see Site Plan Cover Sheet or Approval Sheet  
Revision numbers must be included in the Project Number

| M-NCPPC<br>Prince George's County Planning Department<br>Natural Resources Division |          |              |  |
|-------------------------------------------------------------------------------------|----------|--------------|--|
| APPROVAL                                                                            |          |              |  |
| TREE CONSERVATION PLAN                                                              |          |              |  |
| TCP 2-118-05                                                                        |          |              |  |
| Approved by                                                                         | DATE     |              |  |
| Lori Shirley                                                                        | 8/15/07  | DSP-05024    |  |
| Lori Shirley                                                                        | 10/25/08 | DSP-05070    |  |
| Lori Shirley                                                                        | 5/4/07   | DSP-05070-01 |  |
| K. Shoulters                                                                        | 12/26/07 | DSP-07034    |  |
| K. Shoulters                                                                        | 5/20/10  |              |  |
| K. Shoulters                                                                        | 10/18/11 | DSP-07034-01 |  |
| K. Shoulters                                                                        | 6/19/13  | DSP-07034-04 |  |
| Marc Riso                                                                           | 5/13/14  | DSP-05070-03 |  |
| K. Shoulters                                                                        | 8/04/14  | DSP-07034-06 |  |
| Megan K. Raiser                                                                     | 3/20/15  | DSP-07034-08 |  |

TREE CONSERVATION PLAN, TYPE II  
THE BRICK YARD  
MARC PLANNED COMMUNITY  
PROPOSED LOTS 9-440 &  
PARCELS 'B' TO 'Z' & 'AA' TO 'WW'  
LAUREL DISTRICT No. 10  
PRINCE GEORGES COUNTY, MARYLAND  
HSSC 2007 SHEET SERIES: 216 NE 6 & T AND 217 NE 7  
ADC MAP BK LOCATION 4 C-10

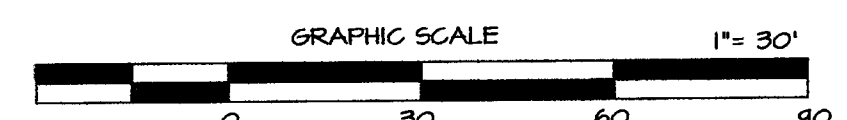


T-25  
TOP SHEET 8 OF 13

| April 15, 2015 |                                                | DATE                  |      |
|----------------|------------------------------------------------|-----------------------|------|
| 04/21/12       | REVISED TO CONFORM WITH DSP07034-02            | PCN                   | PCN  |
| 1-23-04        | Revised to create subphases for South DSP07034 | PCN                   | PCN  |
| 4-4-08         | Revised per staff required layout changes      | CM                    | CM   |
| 3-21-08        | Revised per M-NCPPC comments received 3-1-08   | CM                    | CM   |
| 2/14/08        | UPDATED WETLANDS/ STREAM FEATURES              | MB                    | MB   |
| 2/6/08         | REVISED PER M-NCPPC 1-11-08 COMMENTS           | MB                    | MB   |
| DATE           |                                                | REVISIONS DESCRIPTION |      |
| DATE           | DATE                                           | DATE                  | DATE |
| DATE           | DATE                                           | DATE                  | DATE |

OWNER  
JACKSON SHAW / BRICKYARD  
LIMITED PARTNERSHIP, LLLP  
4640 Forbes Boulevard, Suite 150-B  
Lanham, Maryland 20706  
301-424-1011  
ATTN: Thomas J. Aylward III

1721 WOODMERE ROAD, SUITE 200  
MITCHELLVILLE, MARYLAND 20721  
BEN DYER ASSOCIATES, INC.  
Engineers / Surveyors / Planners  
TELEPHONE (301) 430-2000  
COPYRIGHT © 2007 BEN DYER ASSOCIATES, INC.  
DRAWN BY (DESIGNED BY) RECORD NO. J-83048  
SCALE 1"=30'  
DATE MAY 2007  
DWG. NO. 54.056-Y

2:\107-PROJ\83048-LD7\sheet\TCPH-07034-south.dwg, 4/13/2015 3:32:12 PM, mncppc

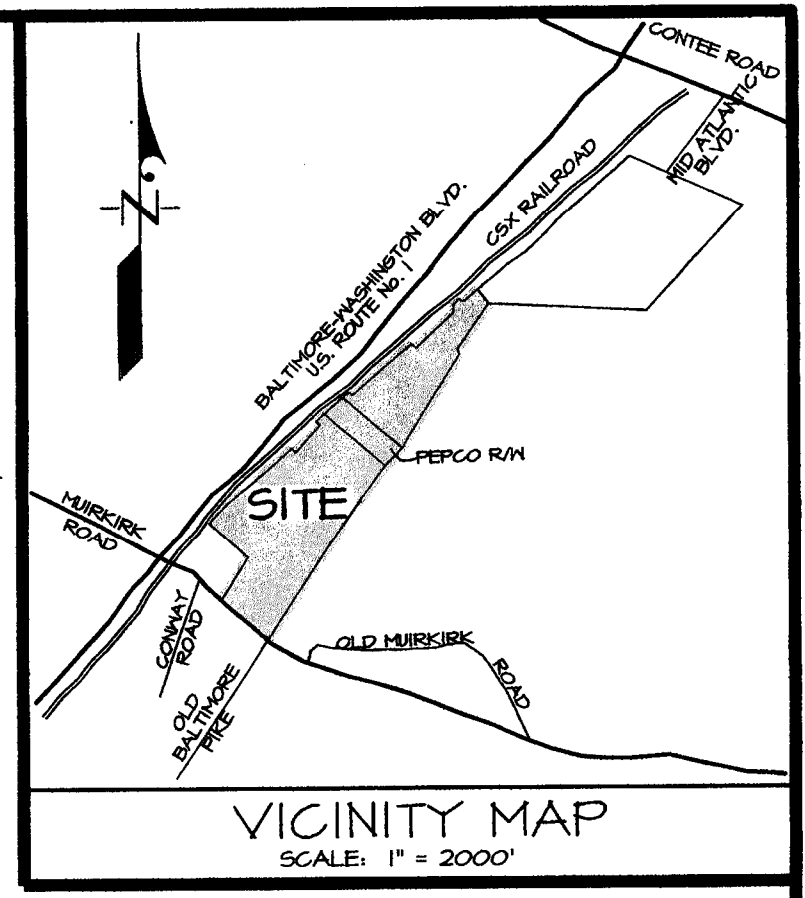

| LEGEND                                          |             |
|-------------------------------------------------|-------------|
| EXISTING CONTOURS                               | 182         |
| PROPOSED CONTOURS                               | 182         |
| EXISTING SPOT ELEVATIONS                        | 181.2 185.1 |
| PROPOSED SPOT ELEVATIONS                        | 181.2 185.1 |

THIS PRINT MADE APR 15 2015



| M-NCPPC<br>Prince George's County Planning Department<br>Natural Resources Division |          |              |  |
|-------------------------------------------------------------------------------------|----------|--------------|--|
| APPROVAL                                                                            |          |              |  |
| TREE CONSERVATION PLAN                                                              |          |              |  |
| TCP 2-118-05                                                                        |          |              |  |
| Approved by                                                                         | DATE     | DATE         |  |
| Lori Shirley                                                                        | 8/15/07  | DSP-05024    |  |
| 01 Lori Shirley                                                                     | 10/25/08 | DSP-05070    |  |
| 02 Lori Shirley                                                                     | 5/4/07   | DSP-05070-01 |  |
| 03 K. Shoulars                                                                      | 12/26/07 | DSP-07034    |  |
| 04 K. Shoulars                                                                      | 5/20/10  |              |  |
| 05 K. Shoulars                                                                      | 10/18/11 | DSP-07034-01 |  |
| 06 K. Shoulars                                                                      | 6/19/13  | DSP-07034-02 |  |
| 07 <i>Megan K. Reiser</i>                                                           | 5/13/15  | DSP-05070-03 |  |
| 08 K. Shoulars                                                                      | 8/04/14  | DSP-07034-06 |  |
| 09 Megan K. Reiser                                                                  | 3/20/15  | DSP-07034-08 |  |


THIS BLOCK IS FOR OFFICIAL USE ONLY  
OR label certifies that this plan meets conditions of final approval by the Planning Board, its designee or the District Council.

**M-NCPPC**  
**APPROVAL**


PROJECT NAME: THE BRICK YARD SOUTH  
PROJECT NUMBER: DSP-07034-08

For Conditions of Approval see Site Plan Cover Sheet or Approval Sheet  
Revision numbers must be included in the Project Number

| M.N.C.P.C. APPROVALS                                                   |          |           |      |
|------------------------------------------------------------------------|----------|-----------|------|
| PROJECT NAME: THE BRICK YARD SOUTH                                     |          |           |      |
| PROJECT NUMBER: DSP-05024                                              |          |           |      |
| For Conditions of Approval see Site Plan Cover Sheet or Approval Sheet |          |           |      |
| Approval                                                               | Revision | Signature | Date |
|                                                                        |          |           |      |
|                                                                        |          |           |      |
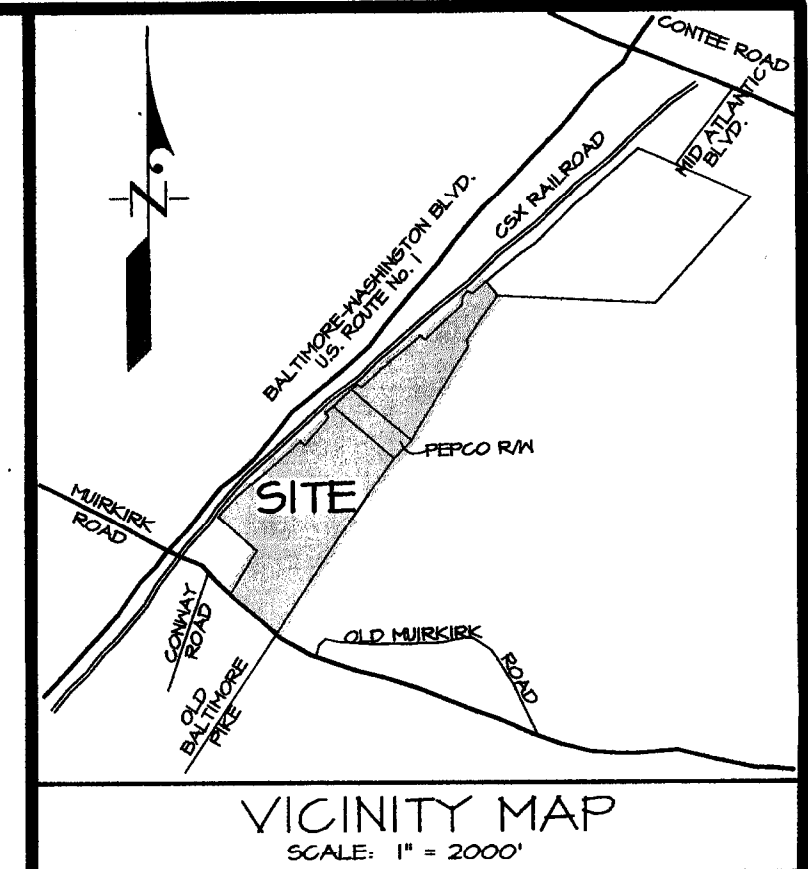

| LEGEND                                          |               |
|-------------------------------------------------|---------------|
| EXISTING CONTOURS                               | 182           |
| PROPOSED CONTOURS                               | 182           |
| EXISTING SPOT ELEVATIONS                        | x189.7 x186.3 |
| PROPOSED SPOT ELEVATIONS                        | x181.2 x185.1 |
| PROPOSED WATER                                  |               |
| PROPOSED STORM DRAIN                            |               |
| EXISTING STREET LIGHT                           |               |
| PROPOSED STREET LIGHT                           |               |
| LIMIT OF DISTURBANCE                            |               |
| PRE-DEVELOPMENT TREE LINE                       |               |
| POST-DEVELOPMENT TREE LINE                      |               |
| FLOODPLAIN: EXISTING/PROPOSED                   |               |
| FLOODPLAIN BUFFER                               |               |
| WATERS OF THE U.S.                              |               |
| WETLAND LIMITS                                  |               |
| WETLAND BUFFER                                  |               |
| PRIMARY MANAGEMENT AREA                         |               |
| STREAM BUFFER                                   |               |
| 65 dBA LINE                                     |               |
| PROPOSED RETAINING WALL                         |               |
| PROPOSED CHAIN LINK FENCE                       |               |
| PROPOSED VINYL SCREEN FENCE                     |               |
| PROPOSED CURB AND GUTTER                        |               |
| PROPOSED CONCRETE PAVING                        |               |
| PROPOSED HEAVY DUTY CONCRETE PAVING             |               |
| PROPOSED HEAVY DUTY ASPHALT PAVING              |               |
| STANDARD PARKING SPACES                         |               |
| COMPACT PARKING SPACES                          |               |
| HANDICAPPED PARKING SPACES                      |               |
| TREE PROTECTION FENCE                           |               |
| PRESERVATION PROTECTION SIGNAGE                 |               |
| REFORESTATION PROTECTION SIGNAGE                |               |
| CLEARING AREA                                   |               |
| PRESERVATION AREA                               |               |
| REFORESTATION AREA                              |               |
| SPECIMEN TREE WITH LIMITS OF CRITICAL ROOT ZONE |               |
| PROPOSED TREE 1-1/2" CAL.                       |               |
| MINING LIMITS                                   |               |
| PHASE LINE                                      |               |

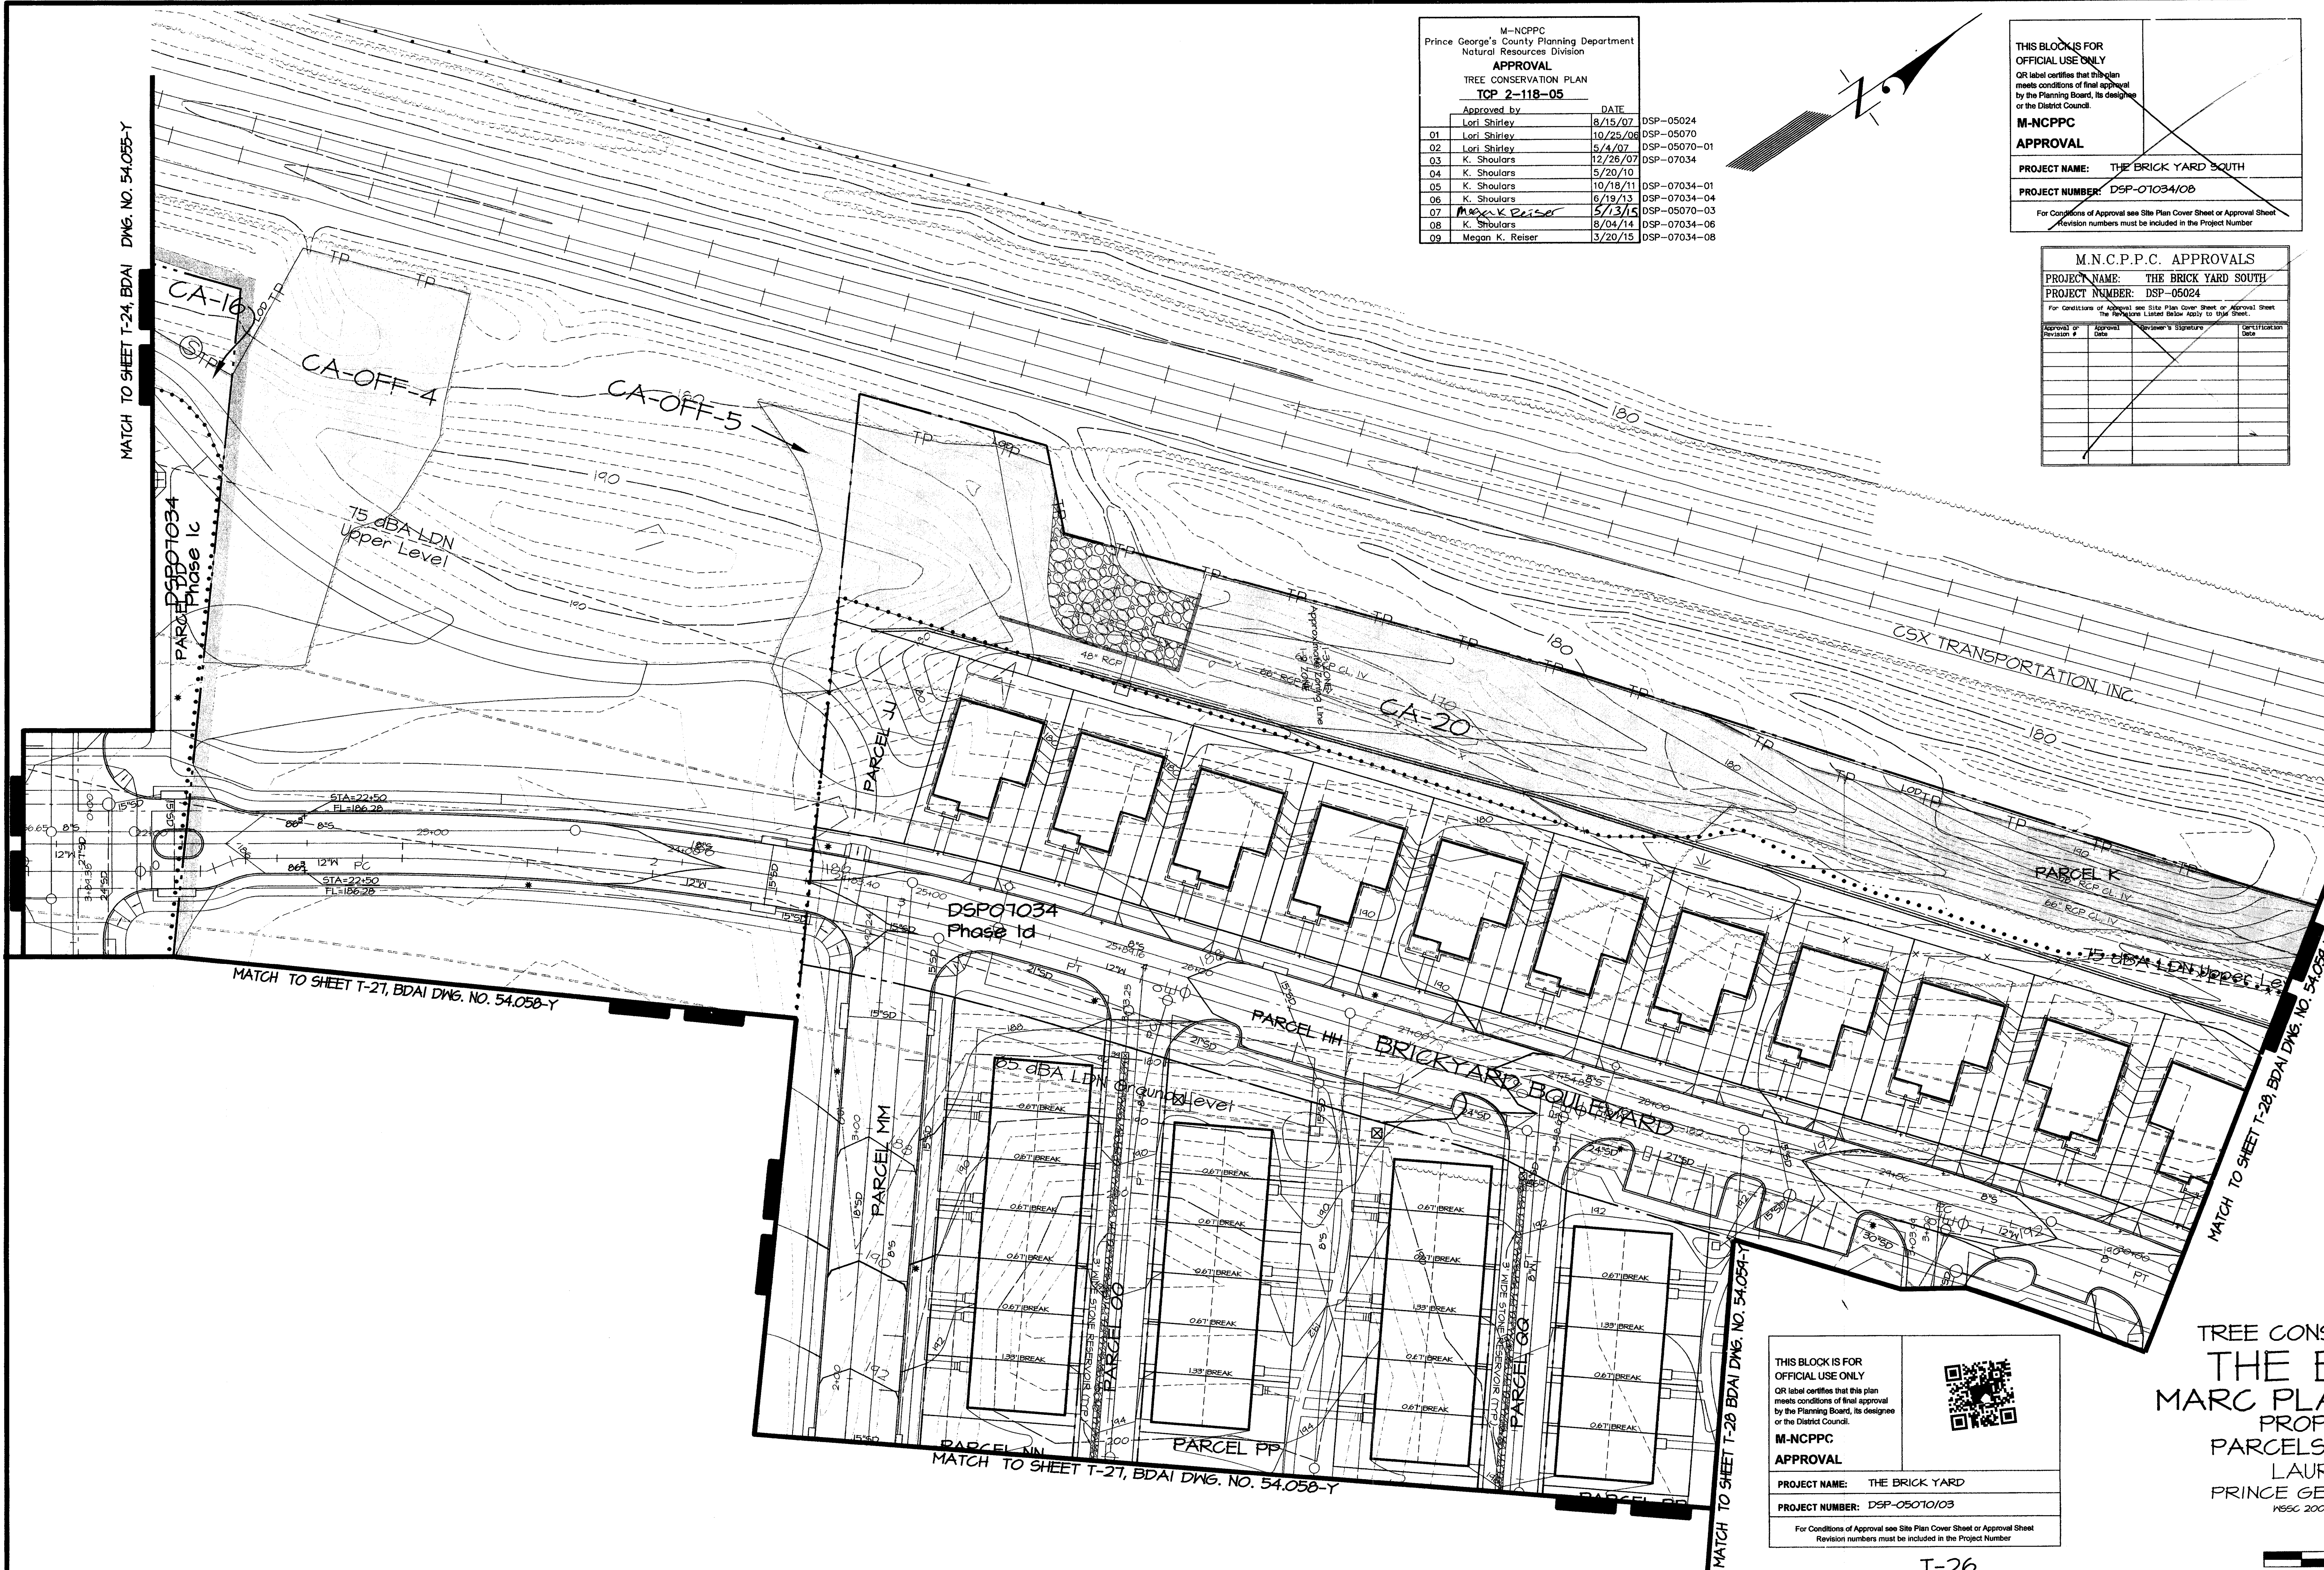


THIS BLOCK IS FOR OFFICIAL USE ONLY  
OR label certifies that this plan meets conditions of final approval by the Planning Board, its designee or the District Council.

**M-NCPPC**  
**APPROVAL**

PROJECT NAME: THE BRICK YARD  
PROJECT NUMBER: DSP-05070/03

For Conditions of Approval see Site Plan Cover Sheet or Approval Sheet  
Revision numbers must be included in the Project Number

TREE CONSERVATION PLAN, TYPE II  
**THE BRICK YARD**  
MARC PLANNED COMMUNITY  
PROPOSED LOTS 9-440 &  
PARCELS 'B' TO 'Z' & 'AA' TO 'WW'  
LAUREL DISTRICT No. 10  
PRINCE GEORGES COUNTY, MARYLAND  
HSSC 200' SHEET SERIES: 216 NE 6 & 7 AND 217 NE 1  
ADC MAP BK LOCATION 4 C-10

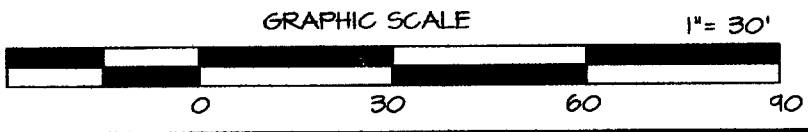

CALL MISS UTILITY  
1-800-251-7777  
48 hrs. Before Excavation

| DATE     | REVISIONS DESCRIPTION                         | BY  |
|----------|-----------------------------------------------|-----|
| 1/04/15  | Revised grading per clients request.          | PCN |
| 6/12/14  | Revised to redesign clubhouse and sound wall. | PCN |
| 11/14/13 | REVISED TO COMFORM WITH DSP07034-06           | PCN |
| 05/16/13 | REVISED TO COMFORM WITH DSP05070-03           | PCN |

OWNER  
JACKSON SHAW / BRICKYARD  
LIMITED PARTNERSHIP, LLP  
4640 Forbes Boulevard, Suite 150-B  
Lanham, Maryland 20706  
301-424-1011  
ATTN: Thomas J. Aylward III

T-26  
TCP SHEET 9 OF 13

April 15, 2015  
DATE

Mike Petrakis  
Qualified Professional  
COMAR 08.19.06.01

| DATE     | REVISIONS DESCRIPTION                          | BY  |
|----------|------------------------------------------------|-----|
| 04/21/12 | REVISED TO COMFORM WITH DSP07034-02            | PCN |
| 1-23-09  | Revised to create subphases for South DSP07034 | PCN |
| 4-4-08   | Revised per staff required layout changes.     | CN  |
| 3-21-08  | Revised per M-NCPPC comments received 3-7-08   | DM  |
| 2/14/08  | UPDATED WETLANDS/ STREAM FEATURES              | MB  |
| 2/6/08   | REVISED PER M-NCPPC I-II-08 COMMENTS           | MB  |

1721 WOODMORE ROAD, SUITE 200  
BEN DYER ASSOCIATES, INC.  
Engineers / Surveyors / Planners  
TELEPHONE (301) 430-2000  
COPYRIGHT © 2007 BEN DYER ASSOCIATES, INC.  
DRAWN BY: DESIGNED BY: CHECKED BY: RECORDED BY:  
SCALE 1" = 30'  
DATE MAY 2007  
DWG. NO. 54.051-Y

THIS PRINT MADE APR 15 2015



MATCH TO SHEET T-24, BDAI DWG. NO. 54.055-Y

MATCH TO SHEET T-26, BDAI DWG. NO. 54.057-Y

CALL MISS UTILITY  
1-800-257-7111  
48 hrs, Before Excavation


THIS BLOCK IS FOR  
OFFICIAL USE ONLY  
QR label certifies that this plan  
meets conditions of final approval  
by the Planning Board, its designee  
or the District Council.



M-NCPPC  
APPROVAL

PROJECT NAME: THE BRICK YARD  
PROJECT NUMBER: DSP-05070/03

For Conditions of Approval see Site Plan Cover Sheet or Approval Sheet  
Revision numbers must be included in the Project Number

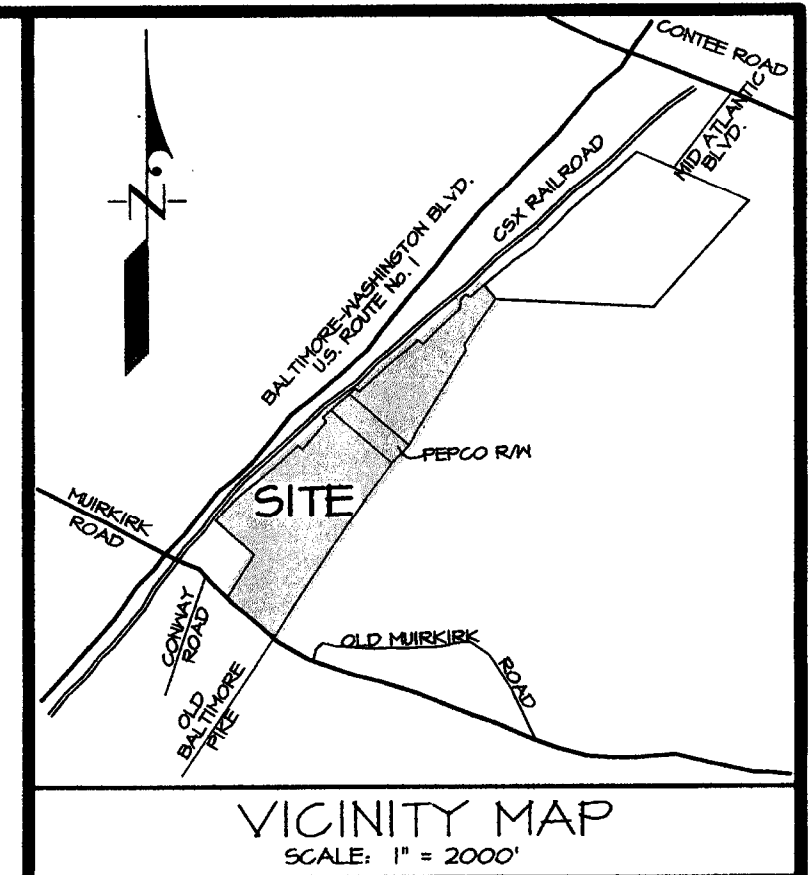


LEGEND

- EXISTING CONTOURS
- PROPOSED CONTOURS
- EXISTING SPOT ELEVATIONS
- PROPOSED SPOT ELEVATIONS
- PROPOSED SEWER
- PROPOSED WATER
- PROPOSED STORM DRAIN
- EXISTING STREET LIGHT
- PROPOSED STREET LIGHT
- LIMIT OF DISTURBANCE
- PRE-DEVELOPMENT TREE LINE
- POST-DEVELOPMENT TREE LINE
- FLOODPLAIN, EXISTING/PROPOSED
- FLOODPLAIN BUFFER
- WATERS OF THE U.S.
- WETLAND LIMITS
- WETLAND BUFFER
- PRIMARY MANAGEMENT AREA
- STREAM BUFFER
- 65 dBA LINE
- PROPOSED RETAINING WALL
- PROPOSED CHAIN LINK FENCE
- PROPOSED VINYL SCREEN FENCE
- PROPOSED CURB AND GUTTER
- PROPOSED CONCRETE PAVING
- PROPOSED HEAVY DUTY ASPHALT PAVING
- STANDARD PARKING SPACES
- CONTACT PARKING SPACES
- HANDICAPPED PARKING SPACES
- TREE PROTECTION FENCE
- PRESERVATION PROTECTION SIGNAGE
- REFORESTATION PROTECTION SIGNAGE
- CLEARING AREA
- PRESERVATION AREA
- REFORESTATION AREA
- SPECIMEN TREE WITH LIMITS OF CRITICAL ROOT ZONE
- PROPOSED TREE 1/2"-2" CAL
- MINING LIMITS
- PHASE LINE

| M-NCPPC<br>Prince George's County Planning Department<br>Natural Resources Division<br>APPROVAL<br>TREE CONSERVATION PLAN<br>TOP 2-118-05 |          |              |  |
|---|----------|--------------|--|
| Approved by   | DATE     |              |  |
| Lori Shirley   | 8/15/07  | DSP-05024    |  |
| Lori Shirley   | 10/25/08 | DSP-05070    |  |
| Lori Shirley   | 5/4/07   | DSP-05070-01 |  |
| K. Shoulters   | 12/28/07 | DSP-07034    |  |
| K. Shoulters   | 5/20/10  |              |  |
| K. Shoulters   | 10/18/11 | DSP-07034-01 |  |
| K. Shoulters   | 6/19/13  | DSP-07034-04 |  |
| Megan K. Reiser   | 5/13/15  | DSP-05070-03 |  |
| K. Shoulters   | 8/04/14  | DSP-07034-06 |  |
| Megan K. Reiser   | 3/20/15  | DSP-07034-08 |  |

TREE CONSERVATION PLAN, TYPE II  
THE BRICK YARD  
MARC PLANNED COMMUNITY  
PROPOSED LOTS 9-440 &  
PARCELS 'B' TO 'Z' & 'AA' TO 'WW'  
LAUREL DISTRICT No. 10  
PRINCE GEORGES COUNTY, MARYLAND  
MSSC 200' SHEET SERIES: 216 NE 6 & T AND 217 NE 1  
ADC MAP BK LOCATION 4 C-10

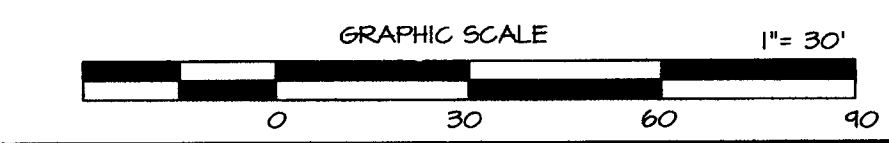

THIS BLOCK IS FOR  
OFFICIAL USE ONLY  
QR label certifies that this plan  
meets conditions of final approval  
by the Planning Board, its designee  
or the District Council.

M-NCPPC  
APPROVAL

PROJECT NAME: THE BRICK YARD SOUTH  
PROJECT NUMBER: DSP-07034/08

For Conditions of Approval see Site Plan Cover Sheet or Approval Sheet  
Revision numbers must be included in the Project Number

M.N.C.P.C. APPROVALS

PROJECT NAME: THE BRICK YARD SOUTH  
PROJECT NUMBER: DSP-05024

For Conditions of Approval see Site Plan Cover Sheet or Approval Sheet  
The following Label Below Entry on this Sheet

Approval of  
Approval Date  
Approval Signature  
Certification Date

OWNER  
JACKSON SHAW / BRICKYARD  
LIMITED PARTNERSHIP, LLLP  
4640 Forbes Boulevard, Suite 150-B  
Lanham, Maryland 20706  
301-424-1011  
ATTN: Thomas J. Aylward III

T-27  
TOP SHEET 10 OF 13

April 15, 2015  
DATE

Mike Petroski  
Qualified Professional  
COMAR 08.18.06.01

| DATE     | REVISIONS DESCRIPTION                          | BY  |
|----------|------------------------------------------------|-----|
| 04/21/12 | REVISED TO CONFORM WITH DSP07034-02 PCN        | PCN |
| 7-23-09  | Revised to create subphases for South DSP07034 | PCN |
| 4-4-08   | Revised per staff required layout changes.     | CM  |
| 3-27-08  | Revised per M-NCPPC comments received 3-1-08   | DM  |
| 2/14/08  | UPDATED WETLANDS/ STREAM FEATURES              | ME  |
| 2/6/08   | REVISED PER M-NCPPC 1-11-08 COMMENTS           | ME  |
| DATE     | REVISIONS DESCRIPTION                          | BY  |

1721 WOODMERE ROAD, SUITE 200  
MITCHELLVILLE, MARYLAND 20721  
BEN DYER ASSOCIATES, INC.  
Engineers / Surveyors / Planners  
TELEPHONE (301) 430-2000

COPYRIGHT © 2007 BEN DYER ASSOCIATES, INC.  
DRAWN BY DESIGNED BY CHECKED BY  
SCALE 1"=30'  
J-83048

DATE MAY 2007  
DWG. NO. 54.058-Y



| DATE     | REVISIONS DESCRIPTION                         | BY  |
|----------|-----------------------------------------------|-----|
| 1/04/15  | Revised grading per clients request.          | PCN |
| 6/12/14  | Revised to redesign clubhouse and sound wall. | PCN |
| 1/14/13  | REVISED TO CONFORM WITH DSP07034-06           | PCN |
| 05/16/13 | REVISED TO CONFORM WITH DSP05070-03           | PCN |







MATCH TO SHEET T-28, BDAI DWG. NO. 54.054-Y

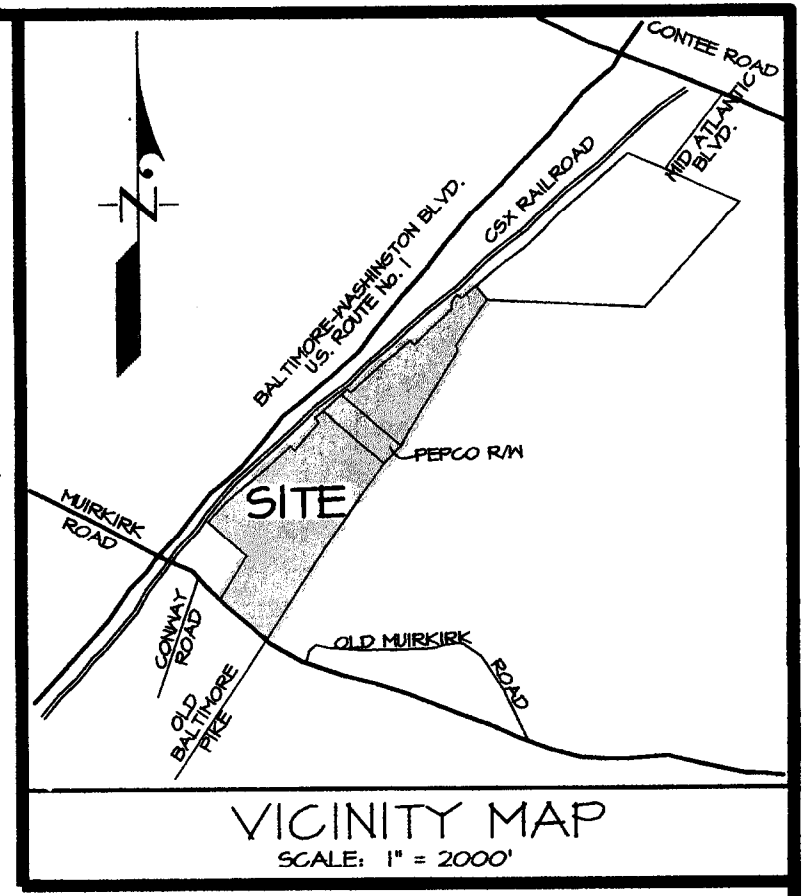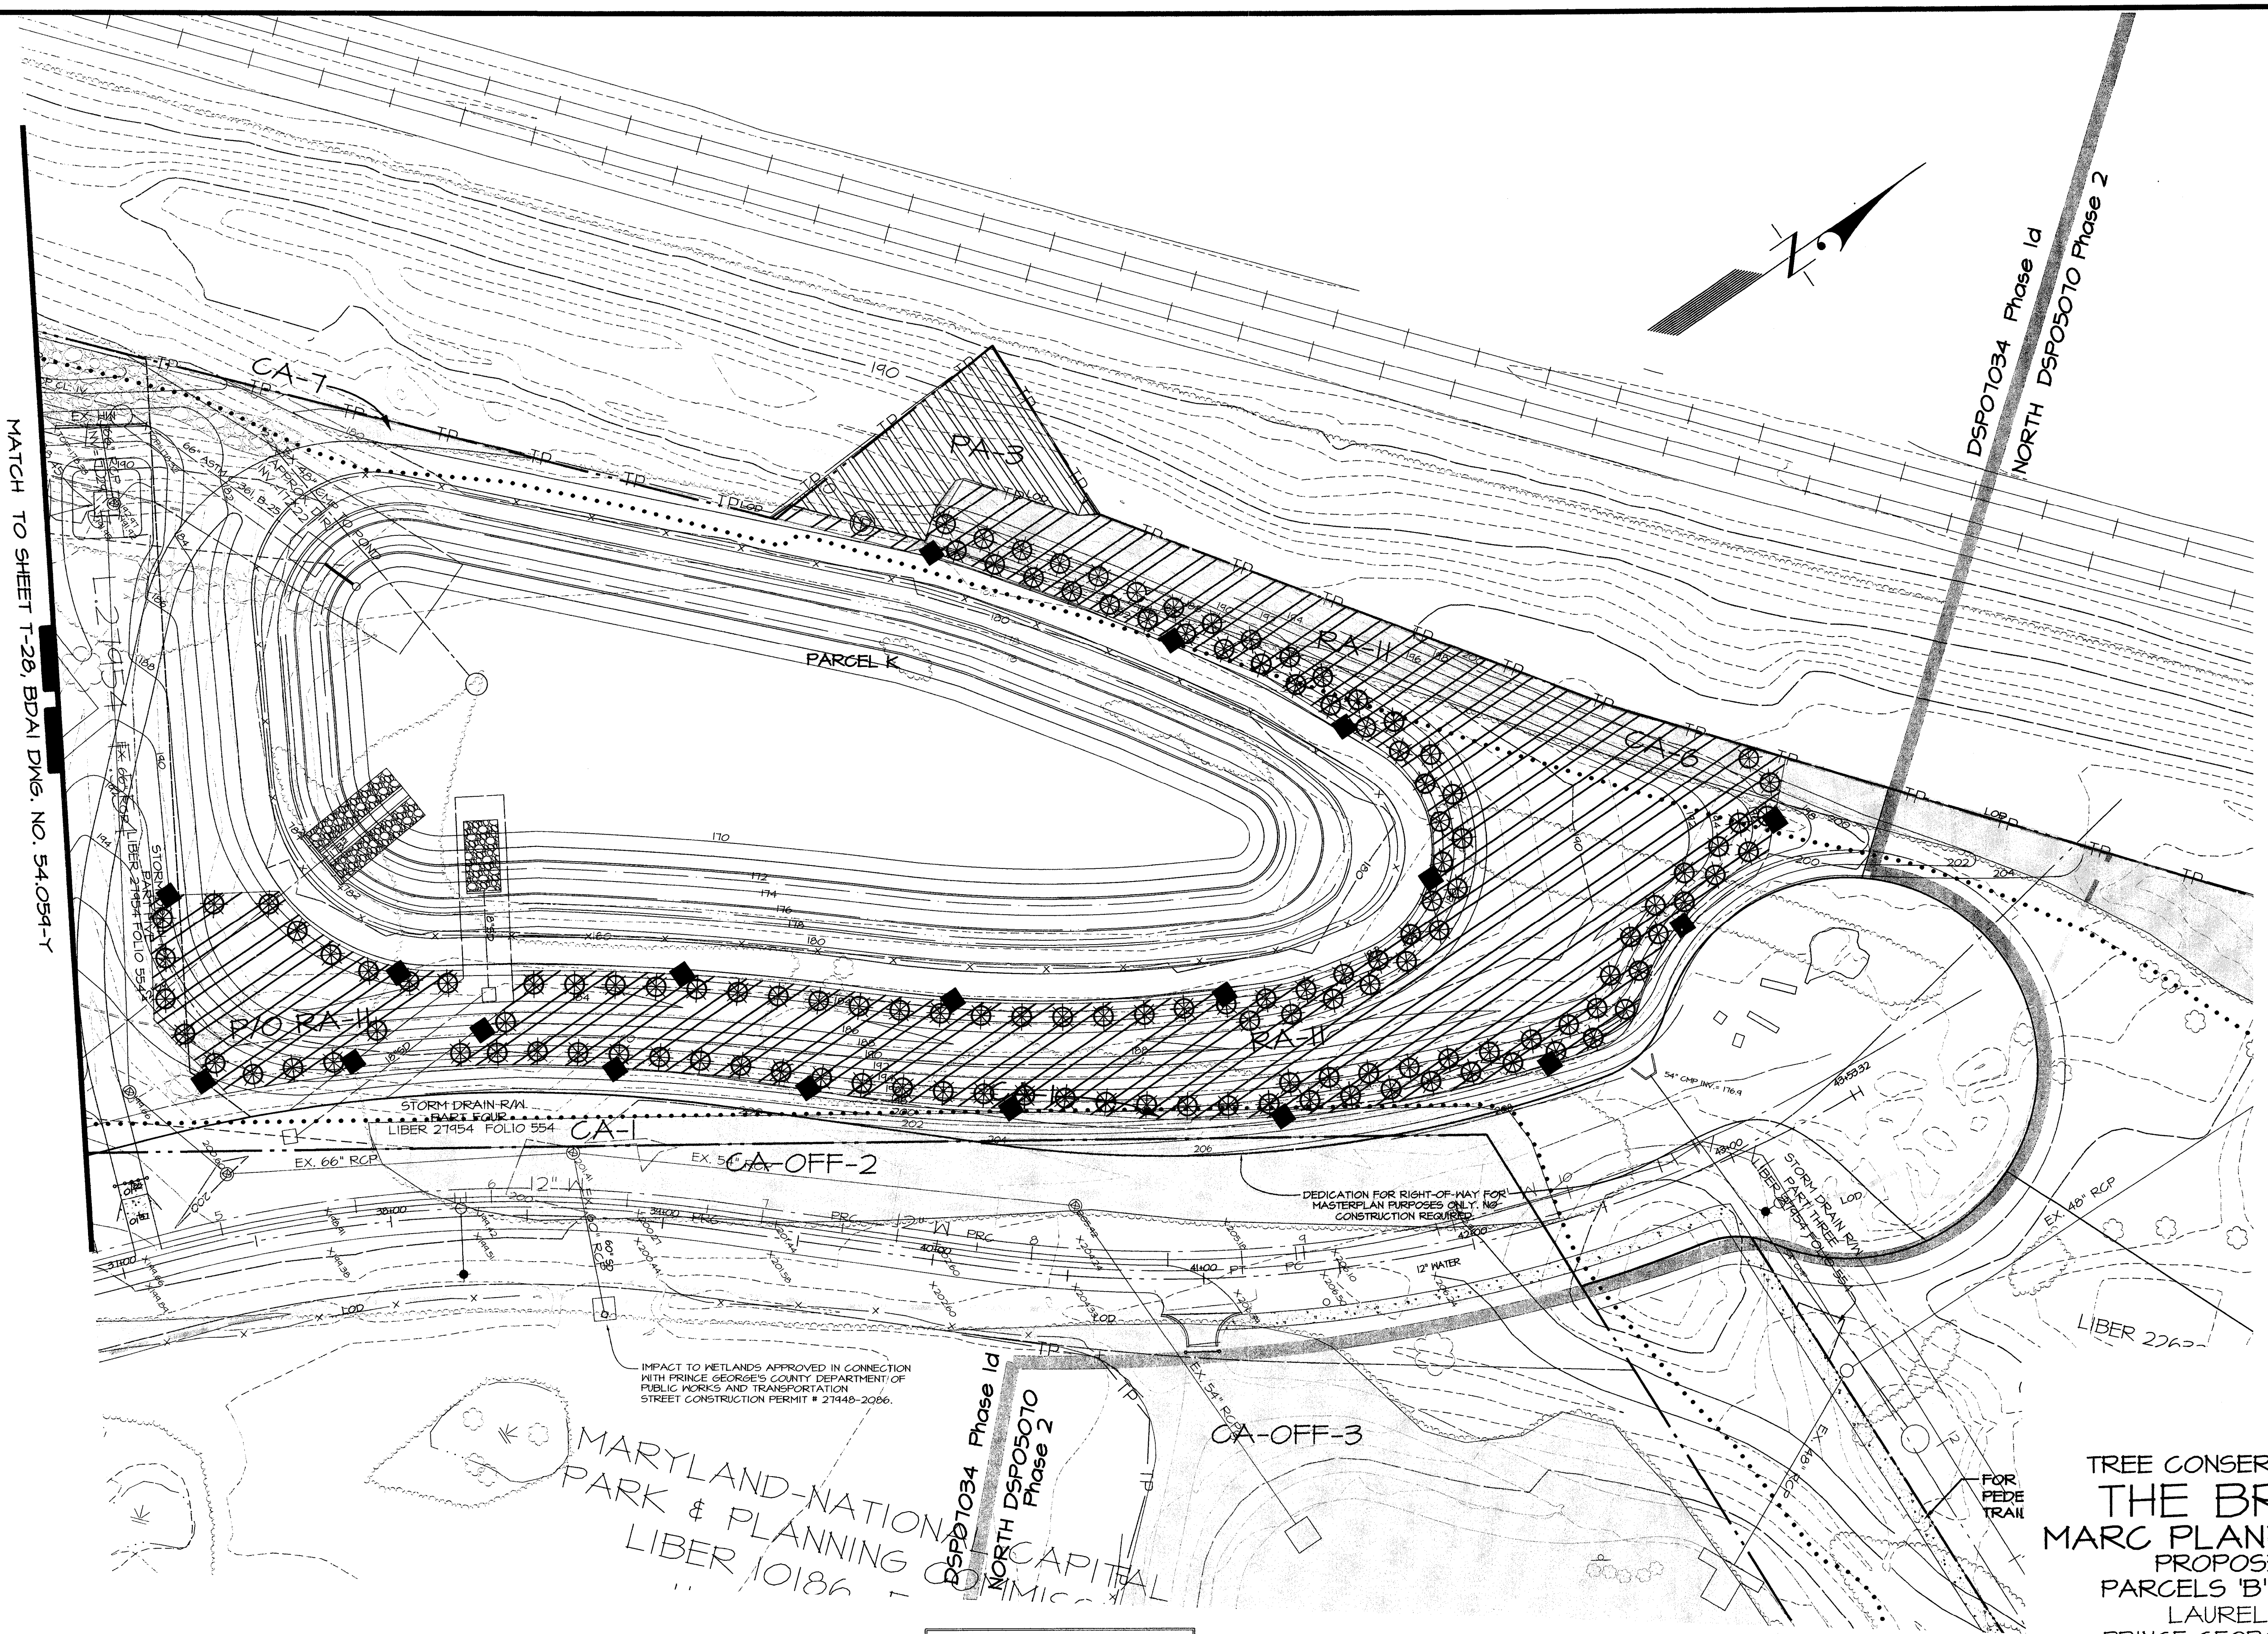

| LEGEND                                          |               |
|-------------------------------------------------|---------------|
| EXISTING CONTOURS                               | ---           |
| PROPOSED CONTOURS                               | ---           |
| EXISTING SPOT ELEVATIONS                        | 1184.7 1186.5 |
| PROPOSED SPOT ELEVATIONS                        | 1181.2 1185.1 |
| PROPOSED SEWER                                  | ---           |
| PROPOSED WATER                                  | ---           |
| PROPOSED STORM DRAIN                            | ---           |
| EXISTING STREET LIGHT                           | △             |
| PROPOSED STREET LIGHT                           | ●             |
| LIMIT OF DISTURBANCE                            | ---           |
| PRE-DEVELOPMENT TREE LINE                       | ---           |
| POST-DEVELOPMENT TREE LINE                      | ---           |
| FLOODPLAIN: EXISTING/PROPOSED                   | FF            |
| FLOODPLAIN BUFFER                               | FB            |
| WATERS OF THE U.S.                              | HL            |
| WETLAND LIMITS                                  | HL            |
| WETLAND BUFFER                                  | HB            |
| PRIMARY MANAGEMENT AREA                         | PHA           |
| STREAM BUFFER                                   | SB            |
| 65 dBA LINE                                     | ---           |
| PROPOSED RETAINING WALL                         | ---           |
| PROPOSED CHAIN LINK FENCE                       | X             |
| PROPOSED VINYL SCREEN FENCE                     | ---           |
| PROPOSED CURB AND GUTTER                        | ---           |
| PROPOSED CONCRETE PAVING                        | ---           |
| PROPOSED HEAVY DUTY CONCRETE PAVING             | ---           |
| PROPOSED HEAVY DUTY ASPHALT PAVING              | ---           |
| STANDARD PARKING SPACES                         | ⑥ ③ ②         |
| COMPACT PARKING SPACES                          | ---           |
| HANDICAPPED PARKING SPACES                      | ---           |
| TREE PROTECTION FENCE                           | TP            |
| PRESERVATION PROTECTION SIGNAGE                 | ⑤             |
| REFORESTATION PROTECTION SIGNAGE                | ---           |
| CLEARING AREA                                   | ---           |
| PRESERVATION AREA                               | ---           |
| REFORESTATION AREA                              | ---           |
| SPECIMEN TREE WITH LIMITS OF CRITICAL ROOT ZONE | ---           |
| PROPOSED TREE 1-1/2"-2" CAL.                    | ---           |
| MINING LIMITS                                   | ---           |
| PHASE LINE                                      | ---           |

| M-NCPPC<br>Prince George's County Planning Department<br>Natural Resources Division |              |
|-------------------------------------------------------------------------------------|--------------|
| APPROVAL                                                                            |              |
| TREE CONSERVATION PLAN                                                              |              |
| TCP 2-118-05                                                                        |              |
| Approved by                                                                         | DATE         |
| Lori Shirley                                                                        | 8/15/07      |
| 01 Lori Shirley                                                                     | 10/25/08     |
| 02 Lori Shirley                                                                     | 5/4/07       |
| 03 K. Shoulters                                                                     | 12/28/07     |
| 04 K. Shoulters                                                                     | 5/20/10      |
| 05 K. Shoulters                                                                     | 10/18/11     |
| 06 K. Shoulters                                                                     | 6/19/13      |
| 07 Megan K. Reiser                                                                  | 5/13/15      |
| 08 K. Shoulters                                                                     | 8/04/14      |
| 09 Megan K. Reiser                                                                  | 3/20/15      |
| DSP-05024                                                                           | DSP-05070    |
| DSP-05070-01                                                                        | DSP-07034    |
| DSP-07034-01                                                                        | DSP-07034-02 |
| DSP-07034-03                                                                        | DSP-07034-04 |
| DSP-07034-05                                                                        | DSP-07034-06 |
| DSP-07034-07                                                                        | DSP-07034-08 |

TREE CONSERVATION PLAN, TYPE II  
**THE BRICK YARD**  
MARC PLANNED COMMUNITY  
PROPOSED LOTS 9-440 &  
PARCELS 'B' TO 'Z' & 'AA' TO 'WW'  
LAUREL DISTRICT No. 10  
PRINCE GEORGES COUNTY, MARYLAND  
MSSC 200' SHEET SERIES: 216 NE 6 & T AND 217 NE 7  
ADC MAP BK LOCATION 4 C-10

CALL MISS UTILITY  
1-800-257-7777  
48 hrs. Before Excavation

| DATE     | REVISIONS DESCRIPTION                         | BY  |
|----------|-----------------------------------------------|-----|
| 1/09/15  | Revised grading per clients request.          | PCN |
| 6/12/14  | Revised to redesign clubhouse and sound wall. | PCN |
| 11/14/13 | REVISED TO COMFORM WITH DSP07034-06           | PCN |
| 05/16/13 | REVISED TO COMFORM WITH DSP05070-03           | PCN |

THIS BLOCK IS FOR OFFICIAL USE ONLY

QR label certifies that this plan meets conditions of final approval by the Planning Board, its designee or the District Council.

**M-NCPPC APPROVAL**

PROJECT NAME: THE BRICK YARD SOUTH  
PROJECT NUMBER: DSP-05024

For Conditions of Approval see Site Plan Cover Sheet or Approval Sheet  
Revision numbers must be included in the Project Number

M.N.C.P.P.C. APPROVALS

PROJECT NAME: THE BRICK YARD SOUTH  
PROJECT NUMBER: DSP-05024

For Conditions of Approval see Site Plan Cover Sheet or Approval Sheet  
Revision numbers must be included in the Project Number

THIS BLOCK IS FOR OFFICIAL USE ONLY

QR label certifies that this plan meets conditions of final approval by the Planning Board, its designee or the District Council.

**M-NCPPC APPROVAL**

PROJECT NAME: THE BRICK YARD  
PROJECT NUMBER: DSP-05070/03

For Conditions of Approval see Site Plan Cover Sheet or Approval Sheet  
Revision numbers must be included in the Project Number

OWNER  
JACKSON SHAW / BRICKYARD  
LIMITED PARTNERSHIP, LLLP  
4640 Forbes Boulevard, Suite 150-B  
Lanham, Maryland 20706  
301-424-1011  
ATTN: Thomas J. Aylward III

T-29  
TCP SHEET 12 OF 13  
April 15, 2015  
DATE  
Mike Patrakis  
Qualified Professional  
COMAR 08.19.06.01

| DATE     | REVISIONS DESCRIPTION                          | BY  |
|----------|------------------------------------------------|-----|
| 04/21/12 | REVISED TO COMFORM WITH DSP07034-02            | PCN |
| T-23-09  | Revised to create subphases for South DSP07034 | PCN |
| 4-4-08   | Revised per staff required layout changes.     | CM  |
| 3-21-08  | Revised per M-NCPPC comments received 3-1-08   | DM  |
| 2/14/08  | UPDATED WETLANDS/ STREAM FEATURES              | MB  |
| 2/6/08   | REVISED PER M-NCPPC 1-11-08 COMMENTS           | MB  |
| DATE     | REVISIONS DESCRIPTION                          | BY  |
| MAY 2007 |                                                |     |

1721 WOODMERE ROAD, SUITE 200  
BEN DYER ASSOCIATES, INC.  
Engineers / Surveyors / Planners  
TELEPHONE (301) 480-2000  
COPYRIGHT © 2007 BEN DYER ASSOCIATES, INC.  
DRAWN BY DESIGNED BY CHECKED BY RECORD NO. J-83048  
SCALE 1"=30'  
BRG. NO. 54.060-Y

APR 15 2015  
TUESDAY



